

NTUA Headquarters Complex Office Building

Fort Defiance, Arizona

Dyron Murphy Architects Project No. 2015.05



ADDENDUM No. 3

November 11, 2016

This addendum forms part of the Contract Documents and modifies the Bid Documents dated, October 6, 2016, as noted below. All Bidders must acknowledge receipt of this Addendum in the space provided on the Bid Form. Failure to do so may subject the Bidder to disqualification.

BIDDER QUESTIONS:

1. Regarding Glass Railing Assembly at Stair S1. Elevations A3, A5, A6/A304 show lay-outs and materials for this. The hand rail is called out as 05 5000.G1, "Aluminum, Brushed Anodized" Spec Section 05-7300 Glass Railing Assemblies call for 304 Stainless Steel at

- 1) Top Guard Rails
- 2) Handrails
- 3) End Post/Balustrade Post
- 4) Exposed Bottom Rails: Extruded aluminum structural member, brushed finish to match top rail...Which material are they to be, Brushed Aluminum or Brushed Stainless Steel?

At interior stairs, S1, hand rail system to be per specification section 05 7300 Glass Railing Assemblies.

2. The specs call for the Top Rail to be 1 ½" dia. Round w/ a channel for glass. Detail A6/A311 shows a Square Top Rail at the Glass Railing. Which is correct?

Provide 1-1/2 inch diameter round top rail as noted in specifications.

3. In Addendum #2 it was stated that the IT Server room was to receive a Dry System. Just want to confirm you did not mean a Pre-Action Fire Sprinkler System complete with Detection, as this is the typical preference for Server Rooms. Please confirm?

Provide system as noted on Addendum No. 2.

4. There are three major steel curtain wall manufacturers in the US. They each make very different shapes and sizes. Was a particular manufacturer required?

A particular manufacturer is not required. Design as shown on drawings is based on TGP (Technical Glass Products) as basis of design. Bidder is responsible to submit design to meet the design intent and requirements.

5. Exterior frame type K at office 1432 (A101c) is not present in elevation K (C6/A605). Should this be frame type U?

Window type at Office 1432, south wall, and as shown on elevation E5/A203 to be Window Type 'U'. However, window type to be 9'-0" height at this location only.

6. There is a window type at exterior wall of Offices 1428 thru 1431 which has no tag (lower right of elevation E5/A203)?

Window type is missing from Window Types. Refer to attached sketch with required dimensions and information.

7. Cannot find aluminum frame type T?

Window type 'T' is not used.

8. There is an aluminum-framed sliding pocket door (type N) but no spec for this door type?

The requirements of the wood sliding door system are to be per the drawings and specification section 08 1416 Flush Wood Doors. The track requirements and other components are noted in the Door Hardware Schedule and specification section 08 7100.

9. Fire-rated doors #1311, 1411, 1529, 1810a, 2211, 2318, 2423A2423B, C01b, S2B, and V02a are scheduled as aluminum frames (doors also at some of them). Is this correct? Fire-rated aluminum costs about \$300/sq.ft. and \$12,000 per door leaf.

Doors at locations noted are wood doors per the Door Schedule. Provide as indicated on drawings.

10. There is a spec section for aluminum sun shades (10 7113), but none appear on the plan elevations or wall sections. Where are these located?

The aluminum sun shades, 10 7113, are clearly shown on the various building elevations, building sections, wall sections and details.

11. Frame types XX are listed as "Clerestory Windows at Lobby". There isn't a clear view anywhere which shows how many of each window type is required?

The location and quantities of window types 'XX' are clearly shown on sheet A102c and E5/A405.

12. Cannot find frame type Y.

Window type 'Y' is not used.

13. The other question has to do with the 'k' class extinguisher. The spec 10 4400, 2.02, C7 says there are (3) required. I only saw one in the kitchen (G101). Could you provide the page(s) that show the other locations? There are two (2) locations shown on G101c in the Kitchen/Serving area. The third location will be determined at a later date.

14. Sheet A101A note indicates to "provide 3"-4" size smooth black river rock below all of stair S1, 3" deep. Coordinate with landscaping where black river rock extends to exterior. I do not see where the landscape plans address this item. Please provide sketch to define area of black river rock.

Refer to attached sketch for extent of river rock on the exterior.

15. Sheet A101B Meeting Room A 1814: Note indicates there is a motorized projector lift, but does not note a projector. Are we to provide a projector at every projector lift location? Please confirm and provide spec. for projector.

Projectors will be provided by Owner.

16. Is there going to be a VoiP Telephone system to be installed and if so, what is the manufacturer?

The VoiP telephone system will be provided by Owner.

17. Is there a wage determination rate through Navajo Nation for the low voltage portion to bid?

All wages are per wage rate included in the bid documents.

18. On page 10 of the Instructions to Bidders, section 8.1 Submission Materials, I cannot find a Certification Form in the bid documents. Please advise.

The letter of certification is to be provided by the bidder/contractor on their company letterhead indicating compliance with the requirements noted in the section.

19. Will the state/county tax be required on top of the Navajo Nation Tax, or will only the Navajo 5% Tax be required?

The Navajo Nation 5% service tax is what is required with the project located on Navajo. The companies are responsible for the cost of other taxes associated with it business transactions, ie state or county. Those taxes may be more associated with the material cost, which are not purchased on the Navajo Nation.

20. Will there be Federal Funds involved in the project that will require Davis Bacon Wages Rates, or should the Wage Rates listed be used?

With RUS loans the Davis Bacon Wage Rates are not required—the Wage Rate listed should be used.

21. Is the gas line going to the Hogan listed in the Allowance #2 included in the Base Bid or is it accounted for in the Allowance.

The extension of the gas line to the Hogan is part of the allowance and should be accounted for in that cost. Refer to sheet C201 for point of termination and extension.

22. Is there a specification for the Wood Stair Treads and landing that can be provided.

The requirements for the wood treads are included in the specification section 05 5100 Metal Stairs.

23. Please clarify what the edge conditions are to be for the gravel mulch ground cover that is shown on the Landscaping plans sheet L200-L202. There is currently no callout as to if we are to provide metal or concrete edger at the edge of the edge of the landscape rock mulch or between the two different types of rock mulch.

There are no edge conditions between the various gravel materials.

24. On L201, there appears to be no rock mulch at the plantings along the north edge of the parking lot along the fence as well as around the fleet vehicle parking lot, please confirm that there is not rock mulch at these locations.

Provide 1" Sierra Rose gravel mulch (as indicated on Material Schedule on L202) at the north edge of the parking lot between the curb and fence.

Rock mulch is not required around the fleet vehicle parking.

25. Please clarify if detail B5/S301 applies to the foundation required for the mechanical equipment enclosure, as the schedule provided on S701 only provides foundation sheets for walls that extend up to 10' above grade only. The Mechanical Equipment Enclosure is called out to be 16' tall walls. Please clarify.

Refer to revised sheet S601 provided as part of Addendum No. 1 for revised information regarding the mechanical enclosure. In addition, refer to Addendum No. 1 for correct wall height (18'-0").

26. A4/A404, there is a callout for SS-1 pointing to the wall as if there is to be a solid surface backsplash between the countertop and wall cabinet, however, there cut section that are provided do not show a detail for this condition. Please provide a detail with the solid surface backsplash if that is the intent.

Provide solid surface backsplash at locations noted on the drawings and schedules. Attachment to wall to be per manufacturer recommendations.

27. On the above mentioned hardware spec, there is no hardware sets for Doors C09 and C10. Also, Doors G01a, G01b, and 1810e are not on the door schedule. Please advise.

Doors C09 and C10 are to be deleted.

Doors G01 and G01b are hardware set 4 as noted on the hardware schedule (specification section 08 7100). These are exterior doors to the mechanical enclosure and service yard enclosure.

Door 1810e is hardware set 36 as noted on the hardware schedule (specification section 08 7100). Door is located in Kitchen (Alternate 01).

DRAWING + SPECIFICATION CLARIFICATIONS:

CIVIL:

1. Refer to civil addendum included herein.

- Bidder questions clarifications.
- Revised specification section 21 4123B

MECHANICAL:

1. Refer to mechanical and plumbing addendum included herein.

- Revised sheets: M003, M101a, M101b, M101c, M102a, M102b, M102c, M104, M501, M502, P002, P101a, P101b, P101c, P102a, P102b, P102c, P111c, P112c, P304, P401.

ELECTRICAL:

1. Refer to electrical addendum included herein.


- Bidder questions clarifications.

END OF ADDENDUM NO.3


Oscar Tovar, Project Manager
Dyron Murphy Architects, P.C

Attachments:

1. Architectural sketches.
2. Civil addendum.
3. Mechanical addendum.
4. Electrical addendum

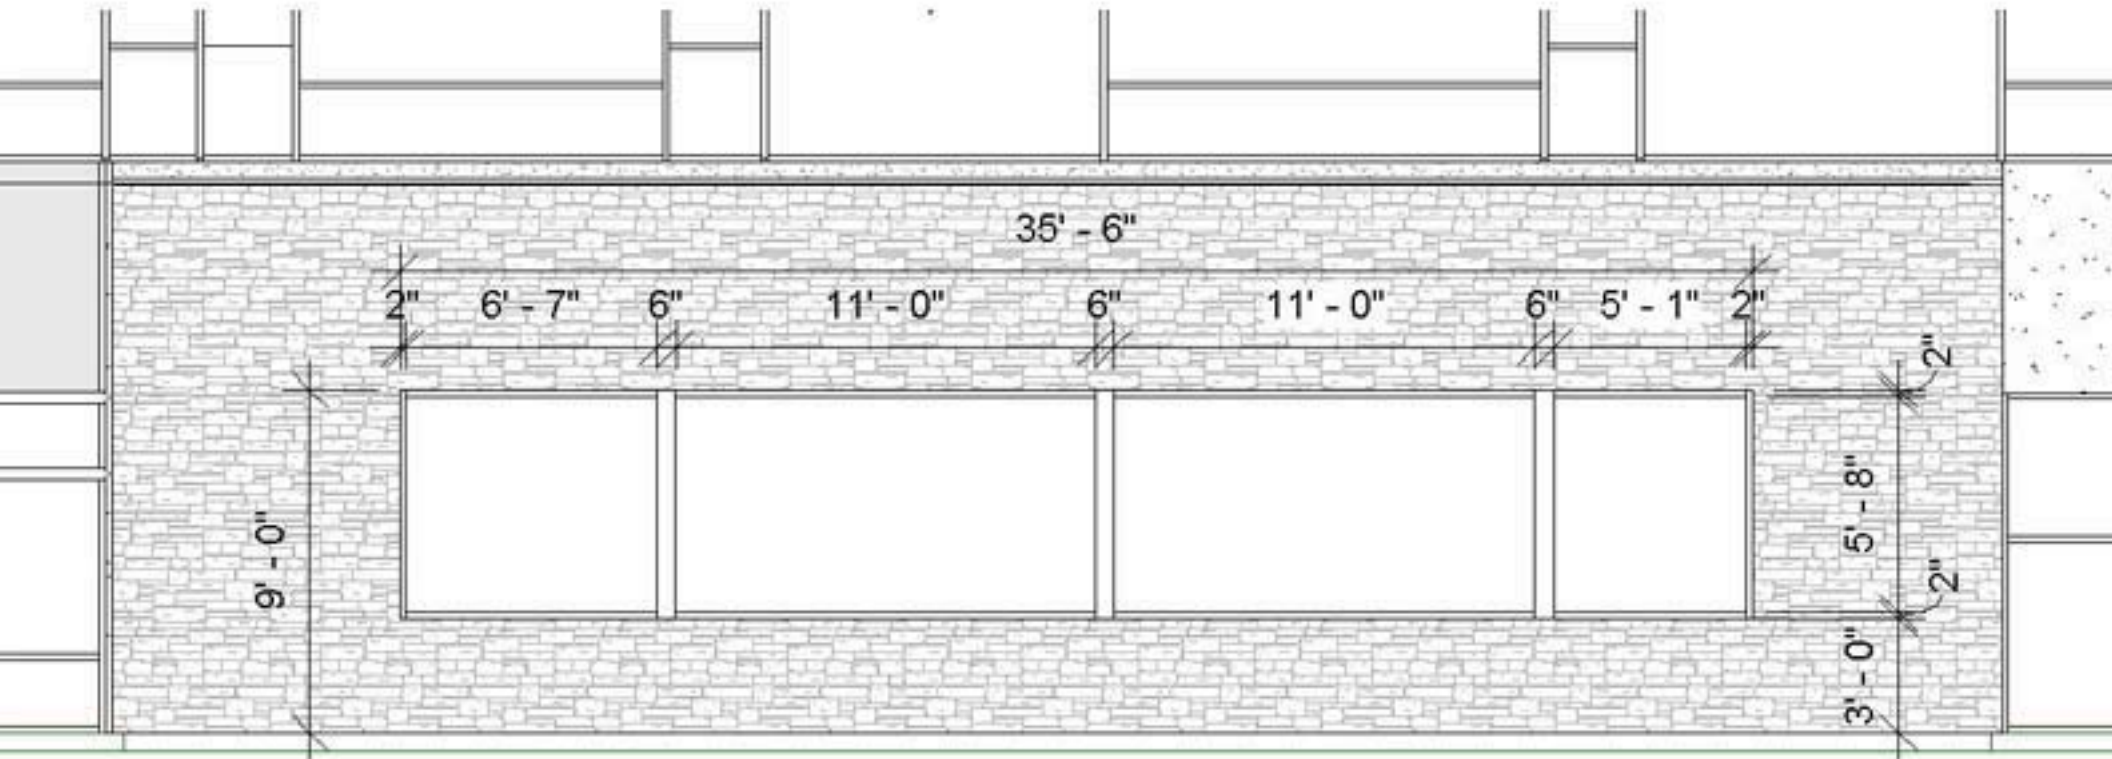

ALUMINUM STOREFRONT SYSTEM
 GLAZING: IG-1
 ELEVATION E5/A203 (OFFICES 1428-1431)
 ADDENDUM NO. 3

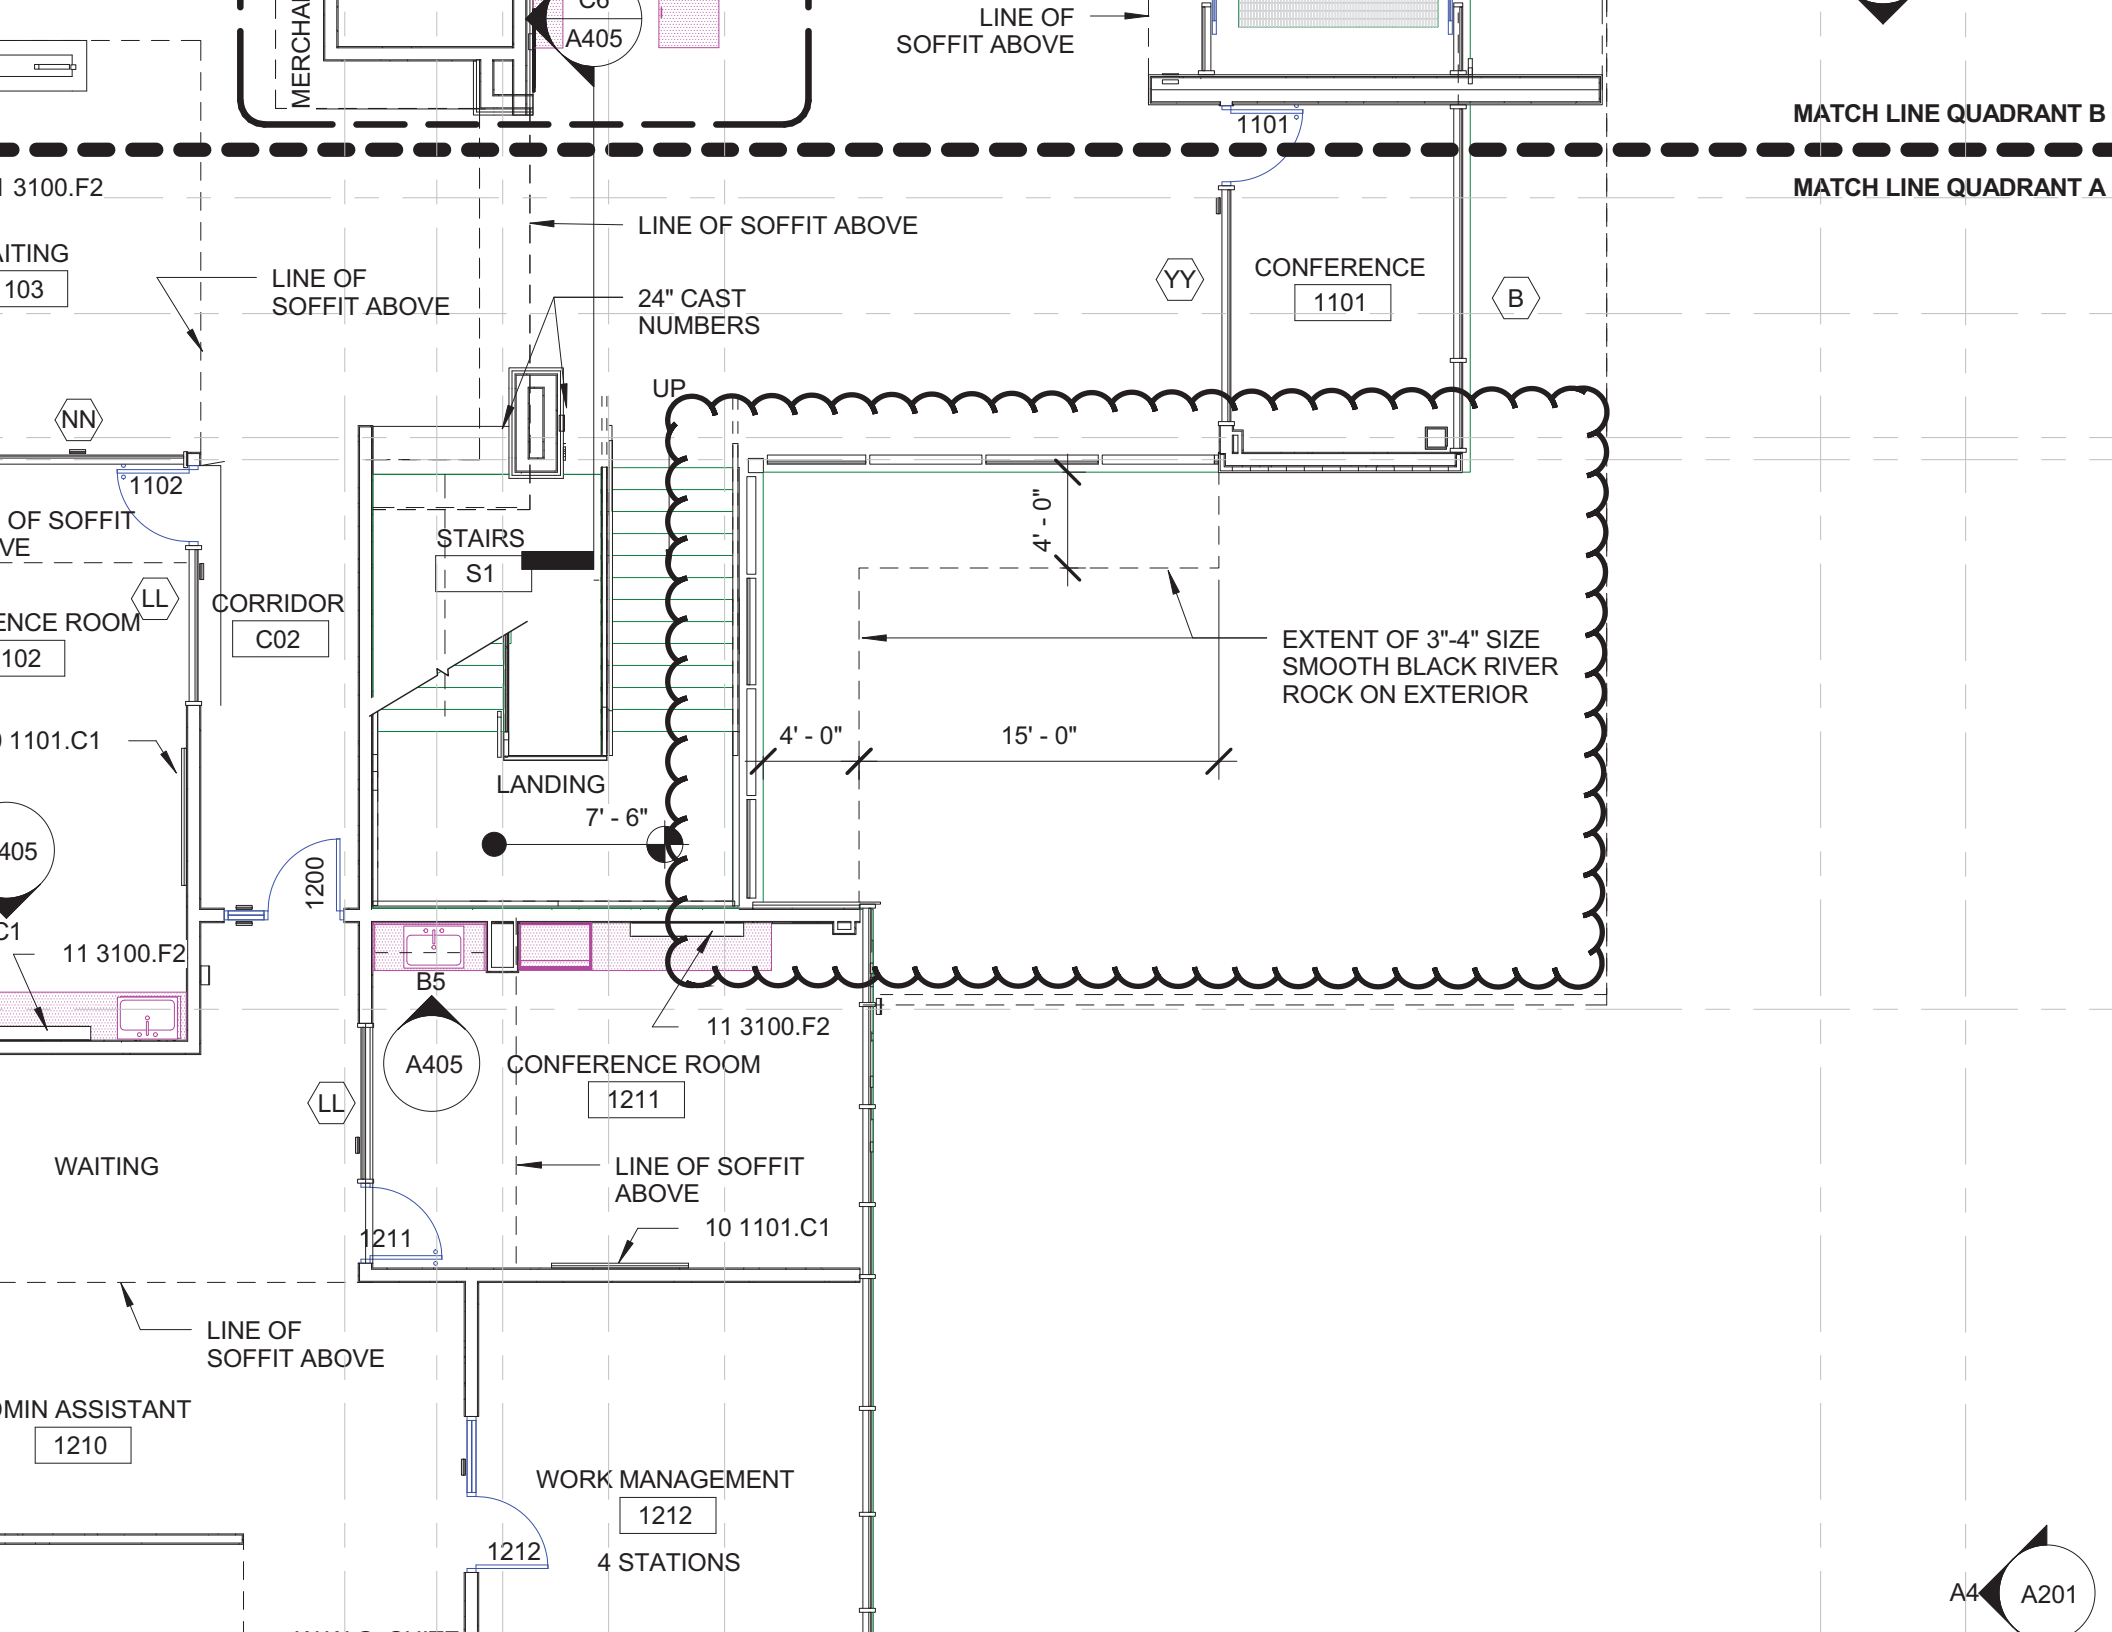

MATCH LINE QUADRANT B

MATCH LINE QUADRANT A

3100.F2

WAITING
103

LINE OF SOFFIT ABOVE

LINE OF SOFFIT ABOVE

24" CAST
NUMBERS

CONFERENCE
1101

UP

STAIRS
S1

CORRIDOR
C02

EXTENT OF 3"-4" SIZE
SMOOTH BLACK RIVER
ROCK ON EXTERIOR

LINE OF SOFFIT ABOVE

CONFERENCE ROOM
1102

1101.C1

LANDING
7' - 6"

15' - 0"

A405

1200

4' - 0"

11 3100.F2

A405

CONFERENCE ROOM
1211

11 3100.F2

WAITING

LINE OF SOFFIT ABOVE

10 1101.C1

ADMIN ASSISTANT
1210

LINE OF SOFFIT ABOVE

WORK MANAGEMENT
1212

4 STATIONS

1212

November 9, 2016

Oscar Tovar
Sr. Project Manager
Dyron Murphy Architects, P.C.
4505 Montbel Place NE
Albuquerque, NM 87107

Re: NTUA HQ – Addendum 02
REVISED Responses to Comments

SPECIFICATIONS

Questions from Engineering America

The following comments are:

1. 1.03 Qualifications item D. and E. to be removed and replaced with: The tank manufacturer shall submit with bid that it is compliant with EPA AIS; steel sheets made from American steel.

Response: Modify Specification 1.03.D to the following:

“D. Certification from the tank manufacturer that all steel and aluminum used for the tank shall be smelted and produced in the U.S.A., or is otherwise compliant with American Iron and Steel Guidelines, as defined by the US EPA for Clean Water State Revolving Fund projects. Contractor shall provide all documentation for this certification or compliance.

- 1. Only bids from manufactured tank suppliers who comply with this subsection and have successfully pre-qualified will be considered.”*

3. 1.07 Coatings item 4.a. and 5.a.b. remove and replace CST Storage with: Tank Manufacture.

Response: Modify 5a and 5b to the following (4a was previously modified):

‘5. Measurement of Color

a. The exterior color of the sheets shall be measured using a colorimeter approved by Manufacturer. The colorimeter shall have a valid calibration record.

b. The color must fall within the tolerance specified by Manufacturer; else the panel shall be rejected.”

Engineering ▲

Spatial Data ▲

Advanced Technologies ▲

SECTION 21 41 23 B
BOLTED STEEL TANK

PART 1 GENERAL

1.01 SCOPE

Furnish and erect a glass-fused-to-steel bolted water storage tank, including foundation, tank structure and tank appurtenances as shown on the Drawings and described herein.

- A. All required labor, materials and equipment shall be included.
- B. All materials furnished by the tank manufacturer, which are in contact with the stored water shall be certified and listed by the National Sanitation Foundation (NSF) to meet ANSI/NSF Additives Standard No. 61. Certification of a coating type alone will not be sufficient to meet this requirement.

1.02 REFERENCES

- A. SSPC SP-10 - Surface Preparation Standard – Near-White Metal Blast Cleaning
- B. ASTM C633-79 - Standard Test Method for Adhesion or Cohesive Strength of Flame-Sprayed Coatings
- C. ISO 28706-1:2008 – Vitreous and Porcelain Enamels – Determination of Resistance to Chemical Corrosion
- D. ISO 2859 – Sampling Procedures for Inspection by Attributes
- E. EN 14430:2004 – Vitreous and Porcelain Enamels – High Voltage Test
- F. ISO 6370-2 – Vitreous and Porcelain Enamels – Determination of Resistance to Abrasion

1.03 QUALIFICATIONS OF TANK SUPPLIER

- A. The Engineer's selection of factory applied glass-fused-to-steel bolted tank construction for this facility has been predicated upon specific criteria, construction methods, and an optimum coating for resistance to internal and external tank corrosion. Deviations from the specified design, construction or coating details, will not be permitted.
- B. The tank manufacturer shall submit with its proposal a drawing showing major dimensions and plate thickness upon which the bid is based and a site specific foundation design based on the soils report showing preliminary dimensions and approximate quantities of concrete and reinforcing steel. The tank and foundation drawings shall be signed and sealed by a Professional Engineer licensed in the state of Arizona.
- C. Strict adherence to the standards of design, fabrication, erection, product quality, and long term performance established in this Specification will be required by the Owner and Engineer.
- D. Certification from the tank manufacturer that all steel and aluminum used for the tank shall be smelted and produced in the U.S.A., or is otherwise compliant with American Iron and Steel Guidelines, as defined by the US EPA for Clean Water State Revolving Fund projects. Contractor shall provide all documentation for this certification or compliance.
 - 1. Only bids from manufactured tank suppliers who comply with this subsection and have successfully pre-qualified will be considered.
- E. The Engineer reserves the right to evaluate all bids based on long term, 50-year minimum operation, coatings and maintenance costs. Values to be used in this evaluation will be at the discretion of the Engineer, as detailed in this specification and bid tabulation form. The Engineer will add such costs, dependent upon the type of tank offered, to the bidder's price to determine the effective low bid for purposes of making the award.

1.04 RELATED WORK

- A. Section 21 41 23 – Fire Protection Tank

1.05 DESIGN CODES AND GUIDES

- A. The most recent editions of the publications listed in the following text form a part of the specification to the extent referenced. The publications are referred to by the following abbreviation:
 - 1. ANSI/AWWA D103 – Standard for Factory Coated Bolted Steel Tanks.
 - 2. NFPA 22 – Water Tanks for Private Fire Protection.
 - 3. 2009 NFPA 5000 - Building Construction and Safety Code
 - 4. IBC 2006 - International Building Code
 - a. ASCE 7-05 - Minimum Design Loads for Buildings and Other Structures
 - b. ACI 318-05 - Building Code Requirements for Structural Concrete
- B. Specific design criteria in addition to that specified on the contract drawings:
 - 1. Occupancy and Use Category: IV – Fire Suppression Facility
 - 2. Minimum frost depth: 30 inches
 - 3. Minimum thickness: 20 inches
 - 4. Allowable soil bearing pressure (on engineered fill): 2,500 psf
 - 5. Foundation type: Reinforced Concrete Bottom with Embedded Steel Base Setting Ring per Paragraph 1.09.A of this Section.

1.06 SUBMITTALS

The following shall be submitted in accordance with Administrative Requirements of the project, Section 01 3000 of the Project Manual.

- A. Shop Drawings:
 - 1. Dimensioned tank fabrication drawings indicating all appurtenances with necessary plan and elevation views.
 - 2. Engineering calculations for tank and foundation by registered professional engineer in the State of Arizona.
 - 3. Tank foundation plan.
 - 4. Tank foundation materials of construction.
 - 5. Include the following tank finish data:
 - a. Manufacturer's standard product data, performance characteristics and material safety data sheet.
 - b. List of materials to be used under this section.
 - c. Exception to or deviations from specified requirements, if any, and reasons for same.
- B. Tank inspection report including test results.
- C. Tank manufacturer qualifications including listing of 3 similar installations within the last 5 years.
- D. Operations and Maintenance manual.
- E. Tank Warranty.
- F. Certification from the tank manufacturer that the tank meets the requirements of the standards listed in Section 1.03.

1.07 COATING

A. GLASS COATING

The tank shall be provided with a glass fused-to-steel coating per AWWA D103.

B. FACTORY INSPECTION

1. The manufacturer's quality system shall be ISO 9001 certified and refer to ISO (International Organization for Standardization) for the following testing and procedures.
2. Chemical Resistance of Glass Coating
 - a. Frits shall be individually tested in accordance with pertinent sections of ISO 28706-1:2008.
3. Factory Holiday Test
 - a. A dry volt test using a minimum of 1100 volts is required.
 - b. Frequency of the test shall be every sheet. Any sheet registering a discontinuity on the interior surface of floor shall be rejected.
4. Measurement of Glass Thickness
 - a. Glass thickness shall be measured using an electronic dry film thickness gage (magnetic induction type) approved by Manufacturer. The thickness gage shall have a valid calibration record.
 - b. The thickness of the glass shall be between 10.0 and 18.0 mils (0.010 and 0.018 inches).
5. Measurement of Color
 - a. The exterior color of the sheets shall be measured using a colorimeter approved by Manufacturer. The colorimeter shall have a valid calibration record.
 - b. The color must fall within the tolerance specified by Manufacturer; else the panel shall be rejected.
6. Impact Adherence Test
 - a. The adherence of the glass coating to the steel shall be tested in accordance with ISO standards. Any sheet that has poor adherence shall be rejected.
7. Fishscale Test
 - a. The glass coating shall be tested in-house for fishscale by placing the full size production sheets in an oven at 400° F for one hour. The sheets will then be examined for signs of fishscale. Any sheet exhibiting fishscale shall be rejected and all sheets from that gage lot will be similarly tested.

1.08 SHIPPING AND HANDLING

- A. All sheets that pass Factory Inspection and Quality Control checks shall be protected from damage prior to packing for shipment.
- B. Heavy paper or plastic foam sheets shall be placed between each panel to eliminate sheet-to-sheet abrasion during shipment.
- C. Individual stacks of panels will be wrapped in heavy mil plastic and steel banded to special wood pallets built to maintain the roll-radius of the tank panels and minimize contact or movement of finished panels during shipment.
- D. Shipment from the factory will be by truck, hauling the tank components exclusively.

1.09 ERECTION

A. FOUNDATION

1. The tank foundation shall be either:
 - a. Type 1, Steel-bottom tanks supported on ringwalls per AWWA D103.
 - Or
 - b. Type 6, Concrete-bottom with embedded steel base setting ring per AWWA D103
2. The tank foundation is a part of this contract and shall be installed by the Authorized

Tank Dealer. A site specific foundation design signed and sealed by a Professional Engineer licensed in the state of Arizona, based on the soils report, shall be submitted for review and approval.

3. The tank foundation shall be designed by the manufacturer to safely sustain the structure and its live loads.
4. Tank footing design shall be based on the soil bearing capacity given in the geotechnical report. Copies of the soil report are to be provided to the bidder prior to bid date by the Owner or Engineer.

B. Sidewall Structure

1. Field erection of the glass-coated, bolted-steel tank shall be in strict accordance with the procedures outlined in the manufacturer's erection manual, and performed by an authorized dealer of the tank manufacturer, regularly engaged in erection of these tanks, using factory trained erectors.
2. Specialized erection jacks and building equipment developed and manufactured by the tank manufacturer shall be used to erect the tanks.
3. Particular care shall be taken in handling and bolting of the tank panels, structural members, and appurtenances to avoid abrasion of the coating system. Prior to a liquid test, all surface areas shall be visually inspected by the Engineer.
4. No backfill shall be placed against the tank sidewall without prior written approval of the tank manufacturer. Any backfill allowed shall be placed according to the strict instructions of the tank manufacturer.

C. Roof

1. The roof shall be a structurally supported dome roof per AWWA D103.
 - a. The dome shall be clear span and designed to be self-supporting from the periphery structure with primary horizontal thrust contained by an integral tension ring.
 - b. The dome and tank shall be designed to act as an integral unit. The tank shall be designed to support an aluminum dome roof including all specified live loads.
2. Roof Vent
 - a. A properly sized vent assembly in accordance with AWWA D103 shall be furnished and installed above the maximum water level of sufficient capacity so that at maximum design rate of water fill or withdrawal, the resulting interior pressure or vacuum will not exceed ½ inch water column.
 - b. The overflow pipe shall not be considered to be a tank vent.
 - c. The vent shall be constructed of aluminum such that the hood can be unbolted and used as a secondary roof access.
 - d. The vent shall be so designed in construction as to prevent the entrance of birds and/or animals by including an expanded aluminum screen (½ inch) opening. An insect screen of 23 to 25 mesh polyester monofilament shall be provided and designed to open should the screen become plugged by ice formation.

D. APPURTENANCES

1. Pipe Connections
 - a. Where pipe connections are shown to pass through tank panels, they shall be field located, saw cut, (acetylene torch cutting or welding is not permitted), and utilize an interior and exterior flange assembly. Tank shell reinforcing shall comply with AWWA D103 latest edition. A single component urethane sealer shall be applied on any cut panel edges or bolt connections.
 - b. Overflow piping shall be sized as shown on the Drawings and shall be seamless aluminum tubing.
2. Outside Tank Ladder

- a. An outside tank ladder shall be furnished and installed as shown on the submittal drawings.
 - b. Ladders shall be fabricated of aluminum and utilize grooved, skid-resistant rungs.
 - c. Safety cage and step-off platforms shall be fabricated of galvanized steel. Ladders shall be equipped with a hinged lockable entry device.
3. Shell Manways
- a. One bottom access door shall be provided as shown on the submittal drawings in accordance with AWWA D103.
 - b. The manhole opening shall be a minimum of 30 inches in diameter. The access door (shell manhole) and the tank shell reinforcing shall comply with AWWA D103 latest edition, Sec. 5.1.
4. Cathodic Protection
- a. A passive cathodic protection system shall be designed and supplied by the tank manufacturer based upon information supplied by the Engineer or Owner.

E. HYDROSTATIC FIELD TESTING

1. Following completion of erection and cleaning of the tank, the structure shall be tested for liquid tightness by filling tank to its overflow elevation.
2. Any leaks disclosed by this test shall be corrected by the authorized dealer in accordance with the manufacturer's recommendations.
3. Water required for testing shall be furnished by the Owner at the time of tank erection completion, and at no charge to the tank erector. Disposal of test water shall be the responsibility of the Owner.
4. Labor and equipment necessary for hydrostatic tank testing is to be included in the price of the tank.

F. TANK MANUFACTURER'S WARRANTY

The tank manufacturer shall include a warranty for the tank materials and coating. As a minimum, this warranty shall provide assurance against defects in workmanship and materials, under normal and proper use, maintenance and operation, during the period expiring on the earlier of (i) one year after liquid is first introduced into the tank or (ii) 14 months after shipment from the factory.

The manufacturer shall further warrant that the glass coated product zone surfaces (that portion of the tank interior below the normal high elevation of the contained liquid) will not corrode, under normal and proper use, maintenance and operation, during the period expiring on the earlier of (i) 12 months after liquids is first introduced into the tank or (ii) 14 months after shipment from the factory.



Date: November 10, 2016

Project: NTUA-HQ COMPLEX OFFICE BUILDING
Fort Defiance, Arizona

AEG Project #: 15037

From: Brian Arnold, P.E.

Re: ADDENDA #03
- Mechanical & Plumbing Revisions to ISSUE FOR CONSTRUCTION Documents

This Addendum revises the documents for the Issue For Construction (IFC) documentation, issued October 06, 2016. This Addendum modifies portions of the original IFC documents as noted below, and forms a part of the IFC documents. All other items included in the original IFC documents remain in effect for this Project.

DOCUMENT:	DESCRIPTION:
Drawing M003 MECHANICAL EQUIPMENT SCHEDULES	- ADDS: At WSHP Schedule: SMOKE DETECTORS AT ALL UNITS DUCTED FILTER RACK SECTION – FACTORY PROVIDED
Drawings M101a M101b M101c M102a M102b M102c MECHANICAL HVAC PLANS	- ADDS: RETURN AIR OPENINGS THRU WALLS, ABOVE CEILINGS.
Drawing M104 MECHANICAL HVAC PLAN ADDITIVE ALT #02	- ADDS: MECHANICAL HEAT PUMP WATER PIPING
Drawing M501 MECHANICAL BUILDING AUTOMATION SYSTEM	- ADDS: Detail M1 / M501: Electrical Power Monitor – NORMAL / EMERGENCY Detail M4 / M501: Outdoor Air Temperature (dry-bulb and wet-bulb)
Drawing M502	- REVISES: Detail M2 / M502 – revises ERV Points List Schedule

MECHANICAL BUILDING AUTOMATION SYSTEM	<ul style="list-style-type: none"> - ADDS: Detail M3 / M502: AC-101 & AC-102 HVAC at IT Server Room [1113] Detail M4 / M502: AC-103 at Call Center Room [1700] Detail M5 / M502: AC-105 at Electrical Room [ELEC1] Detail M6 / M502: AC-104 at UOC [1610] and Programmer [1611] Detail M7 / M502: Split-System Cooling Units at IT Closet [1114]; ELEV EQUIP [1107]; IT Closet [2116]; IT Closet [2410] -
Drawing P002 PLUMBING SCHEDULES	<ul style="list-style-type: none"> - RE-ISSUE THE ENTIRE DRAWING FOR CLARIFICATION
Drawings P101a P101b P101c P102a P102b P102c WASTE PIPING PLANS – Levels 1 & 2	<ul style="list-style-type: none"> - ADDS: Condensate piping for Water Source Heat Pump Units
Drawing P111c PLUMBING WATER & GAS PLAN – Level 1	<ul style="list-style-type: none"> - ADDS: Water piping (CW & HW) up to sinks on 2nd floor above.
Drawing P112c PLUMBING WATER & GAS PLAN – Level 1	<ul style="list-style-type: none"> - ADDS: - Sink Designations - Water piping (CW & HW) up to sinks on 2nd floor above
Drawing P304 PLUMBING FITNESS CENTER ADDITIVE ALT #02	<ul style="list-style-type: none"> - ADDS: Condensate piping for Water Source Heat Pump Units
Drawing P401 PLUMBING DETAILS	<ul style="list-style-type: none"> - ADDS: Condensate drain at trap for Lav detail - REVISES: Water Heater Flue Vent Detail

If there are any questions or comments related to this information, do not hesitate to contact our office.

END OF MECHANICAL ADDENDA #03 ITEMS

WATER SOURCE HEAT PUMP SCHEDULE

SYM	TACO	TYPE	SVC	TOTAL HEAT EXCH		HEAT TRANSFER AREA		LMTD		HOT SIDE		COLD SIDE		ELECTRICAL
				(BTU/hr)	(sq ft)	(sq ft)	(sq ft)	(°F)	(°F)	(°F)	(°F)	(°F)	(°F)	
HX-01	PF82-129-4	PLATE & FRAME	COND. WATER	3,155	1,108	1,37	95.0	85.0	55.0	8.5	83.0	93.0	680	15.2

PLATE AND FRAME HEAT EXCHANGER SCHEDULE:

SYM	TACO	TYPE	SVC	TOTAL HEAT EXCH	HEAT TRANSFER AREA	LMTD	HOT SIDE	COLD SIDE	ELECTRICAL					
HX-01	PF82-129-4	PLATE & FRAME	COND. WATER	3,155	1,108	1,37	95.0	85.0	55.0	8.5	83.0	93.0	680	15.2

COOLING TOWER (FLUID COOLER) SCHEDULE:

SYM	BALTIMORE	AIR COOL (mfr)	MODEL NO.	AMBIENT	HEAT REJECTION	WATER		ELECTRICAL				
						FLUID FLOW (gpm)	WWT (°F)	LWT (°F)	DRIP (gpm)	FAN (HP)	PUMP (HP)	WATER (GPM)
CT-01	FXV-1212C-16D-K	68	3,150	680	93	83	13.8	859	10	7.5	12	460/360

NTUA HQ COMPLEX OFFICE BUILDING

FT. DEFIANCE, ARIZONA
100% CONSTRUCTION DOCUMENTS
OCTOBER 6, 2016

HEAT PUMP WATER CIRCULATING PUMP SCHEDULE

SYMBOL	MANUFACTURER	MODEL	TYPE	SYSTEM	GPM	HEAD FT.	IMPELLER DIA.	SUCTON & DISCHARGE	EFF.	RPM	HP	ELECTRICAL
HPWP-01	TACO	CH4009	CLOSE COUPLED BASE MOUNTED	HEAT PUMP CIRCULATING WATER	550	75	9.25	5.0"x4.0"	79.0%	1750	15.0	460/360

COOLING TOWER CIRCULATING PUMP SCHEDULE

SYMBOL	MANUFACTURER	MODEL	TYPE	SYSTEM	GPM	HEAD FT.	IMPELLER DIA.	SUCTON & DISCHARGE	EFF.	RPM	HP	ELECTRICAL
CTP-01	TACO	CH4011	CLOSE COUPLED BASE MOUNTED	COOLING TOWER CIRCULATING WATER	680	95	11.0"	5.0"x4.0"	81.0%	1750	25.0	460/360

TRIPLE DUTY VALVE SCHEDULE

SYMBOL	MANUFACTURER (OR APPROVED EQUAL)	MODEL	SIZE	FLOW GPM	SYSTEM	COMMENTS
TDV-01	TACO	MPV03-05	5.0"	550	HEAT PUMP CIRCULATING WATER	2.37 PSI PRESSURE DROP MISCELLANEOUS: Flanged connectors.

SUCTION DIFFUSER SCHEDULE

SYMBOL	MANUFACTURER (OR APPROVED EQUAL)	MODEL	SIZE	FLOW GPM	SYSTEM	COMMENTS
SD-01	TACO	SD06004-6	6.0"x5.0"	550	HEAT PUMP CIRCULATING WATER	1.62 PSI PRESSURE DROP MISCELLANEOUS: Flanged connectors. Furnish with start-up screen.

AIR SEPARATOR SCHEDULE

SYMBOL	MANUFACTURER (OR APPROVED EQUAL)	MODEL	SERVICE	FLOW GPM	PIPE CONN.	PROVIDE WITH:
AS-01	TACO	4906A	HEAT PUMP CIRCULATING WATER	550	6 in	STRAINER, ASME, BRACKET SUPPORTS METRAFLEX MODEL MV54 3/4" AUTO AIR VENT

EXPANSION TANK SCHEDULE

SYMBOL	MANUFACTURER (OR APPROVED EQUAL)	MODEL	SERVICE	DIMENSIONS (IN)	VOLUME (GAL)	ACCEPT (GAL)	MOUNTING	TYPE
EXT-01	TACO	CBX254-125	HEAT PUMP CIRCULATING WATER	24" x 40"	68	34	VERTICAL	DIAPHRAGM

VARIABLE FREQUENCY DRIVE SCHEDULE

SYMBOL	SERVICE	MFGR	MODEL	HP	VOLTAGE	PROVIDE WITH:
VFD-01	HEAT PUMP CIRCULATING WATER	TACO/SCHNEIDER ELECTRIC SQUARE D	DSJ4Y08	15.0	460/360	NEMA 1 VFD with 3 contactor bypass, LCD text keypad. Reduced harmonic technology (line reactor), overcurrent circuit breaker, 0-20mA speed reference.

HEATING HOT WATER BOILER SCHEDULE:

SYM	GREENHECK	MFR	MODEL #	OUTDOOR AIR SIDE (OUTSIDE AIR INTO BUILDING)	INDOOR AIR SIDE (EXHAUST AIR FROM BUILDING)	PERFORMANCE EFFECTIVENESS (%)	ELECTRICAL		PHYSICAL						
							DRIVE	V/PH/Hz							
ERV-A101	PV6-35-SC	2,760	0.75	2,485	0.60	55	65	5.0	3.0	BELT	460/360	10.7	15.0	98x104x56	1,800

ENERGY RECOVERY VENTILATOR SCHEDULE ROOFTOP MOUNTED, VERTICAL SUPPLY AND RETURN

SYM	GREENHECK	MFR	MODEL #	OUTDOOR AIR SIDE (OUTSIDE AIR INTO BUILDING)	INDOOR AIR SIDE (EXHAUST AIR FROM BUILDING)	PERFORMANCE EFFECTIVENESS (%)	ELECTRICAL		PHYSICAL						
							DRIVE	V/PH/Hz							
ERV-A101	PV6-35-SC	2,760	0.75	2,485	0.60	55	65	5.0	3.0	BELT	460/360	10.7	15.0	98x104x56	1,800

ELECTRIC UNIT HEATER SCHEDULE

TAG	SERVICE	MFGR	MODEL	HEATING CAPACITY	FAN WATTS	VOLTAGE	OTHER
EUH-101	MECH ROOM [MECH1]	OMARK	MW UH7504	25,600	7,500	6	240V/1PH/60HZ

Level 1				Level 2				Level 1				Level 2			
Equip Tag	Trane (mfr) Model Number	Normal capacity	Design airflow	Equip Tag	Trane (mfr) Model Number	Normal capacity	Design airflow	Equip Tag	Trane (mfr) Model Number	Normal capacity	Design airflow	Equip Tag	Trane (mfr) Model Number	Normal capacity	Design airflow
hpA101	EXH-F0187	1 1/2 ton	625	hpA201	EXH-F0704	6 ton	2,300	hpB101	EXH-F0307	2 1/2 ton	1,045	hpC01	EXH-F0097	3/4 ton	315

MISCELLANEOUS ITEMS TO BE FURNISHED BY MECHANICAL CONTRACTOR:

- High efficiency horizontal
- Copper heat exchanger
- See plans for air discharge configuration
- Extended temperature range package
- 24V controls
- Refrigerant, R-410A
- 2" filters
- Smoke detector
- Enhanced sound attenuation package
- Standard piping configuration
- Digital manual & auto changeover
- 7 day programmable
- 3-heat/2-cool, DDC thermostat
- Condensate pump provided with each unit
- ECM supply fan motor
- Interface with building automation system
- Backflow preventer
- Ducted filter rack section - furnished with each heat pump unit
- Provide and install pre-manufactured hose piping kits as manufactured by HAYS FLUID CONTROLS, "3-SERIES". HOSE KITS TO INCLUDE:
 - Isolation valve(s); ball valve, both supply and return
 - Strainer
 - Automatic flow control valve, ("MESURFLO"), on return line
 - Solenoid valve, 24V, ATC valve on return line
 - Line size per the following schedule:

NOTE: DISCONNECTS BY ELECTRICAL CONTRACTOR.

MISCELLANEOUS ITEMS TO BE FURNISHED BY MECHANICAL CONTRACTOR:

- NEMA 1 enclosure
- 4-20mA input signal
- Vertical enclosure
- Line reactor
- Communication card with bus
- Compatible with BACNET BAS protocol

NOTE: UNITS SELECTED AT 6,500 FT. ELEVATION

AEG
Arsed Engineering Group, LLC.
4700 Lincoln Road, NE 1 Suite 101 | Albuquerque, NM 87109 | 505.761.3100

DIYRON MURPHY ARCHITECTS, P.C.

4505 Montbel Place NE, Albuquerque, New Mexico 87107

10/06/16
ENGINEER

Revision Schedule

Revision Number	Revision Date	Revision Description
1	10/27/16	ADD 01
2	11/03/16	ADD 02
3	11/10/16	ADD 03

PROJECT NUMBER: 2015.05 | DRAWN BY: WOOD | PROJ/MGR: BA

RVT FILE

Sheet Title: MECHANICAL: EQUIPMENT SCHEDULES

Sheet Number: M003

Sequence of: 6 5 4 3 2 1

MECHANICAL: EQUIPMENT SCHEDULES

6 5 4 3 2 1

NTUA HQ COMPLEX
OFFICE BUILDING


FT. DEFIANCE, ARIZONA

100% CONSTRUCTION DOCUMENTS

OCTOBER 6, 2016

KEYED NOTES

- LOCATION OF RETURN AIR WALL OPENING IN WALL ABOVE CEILING.

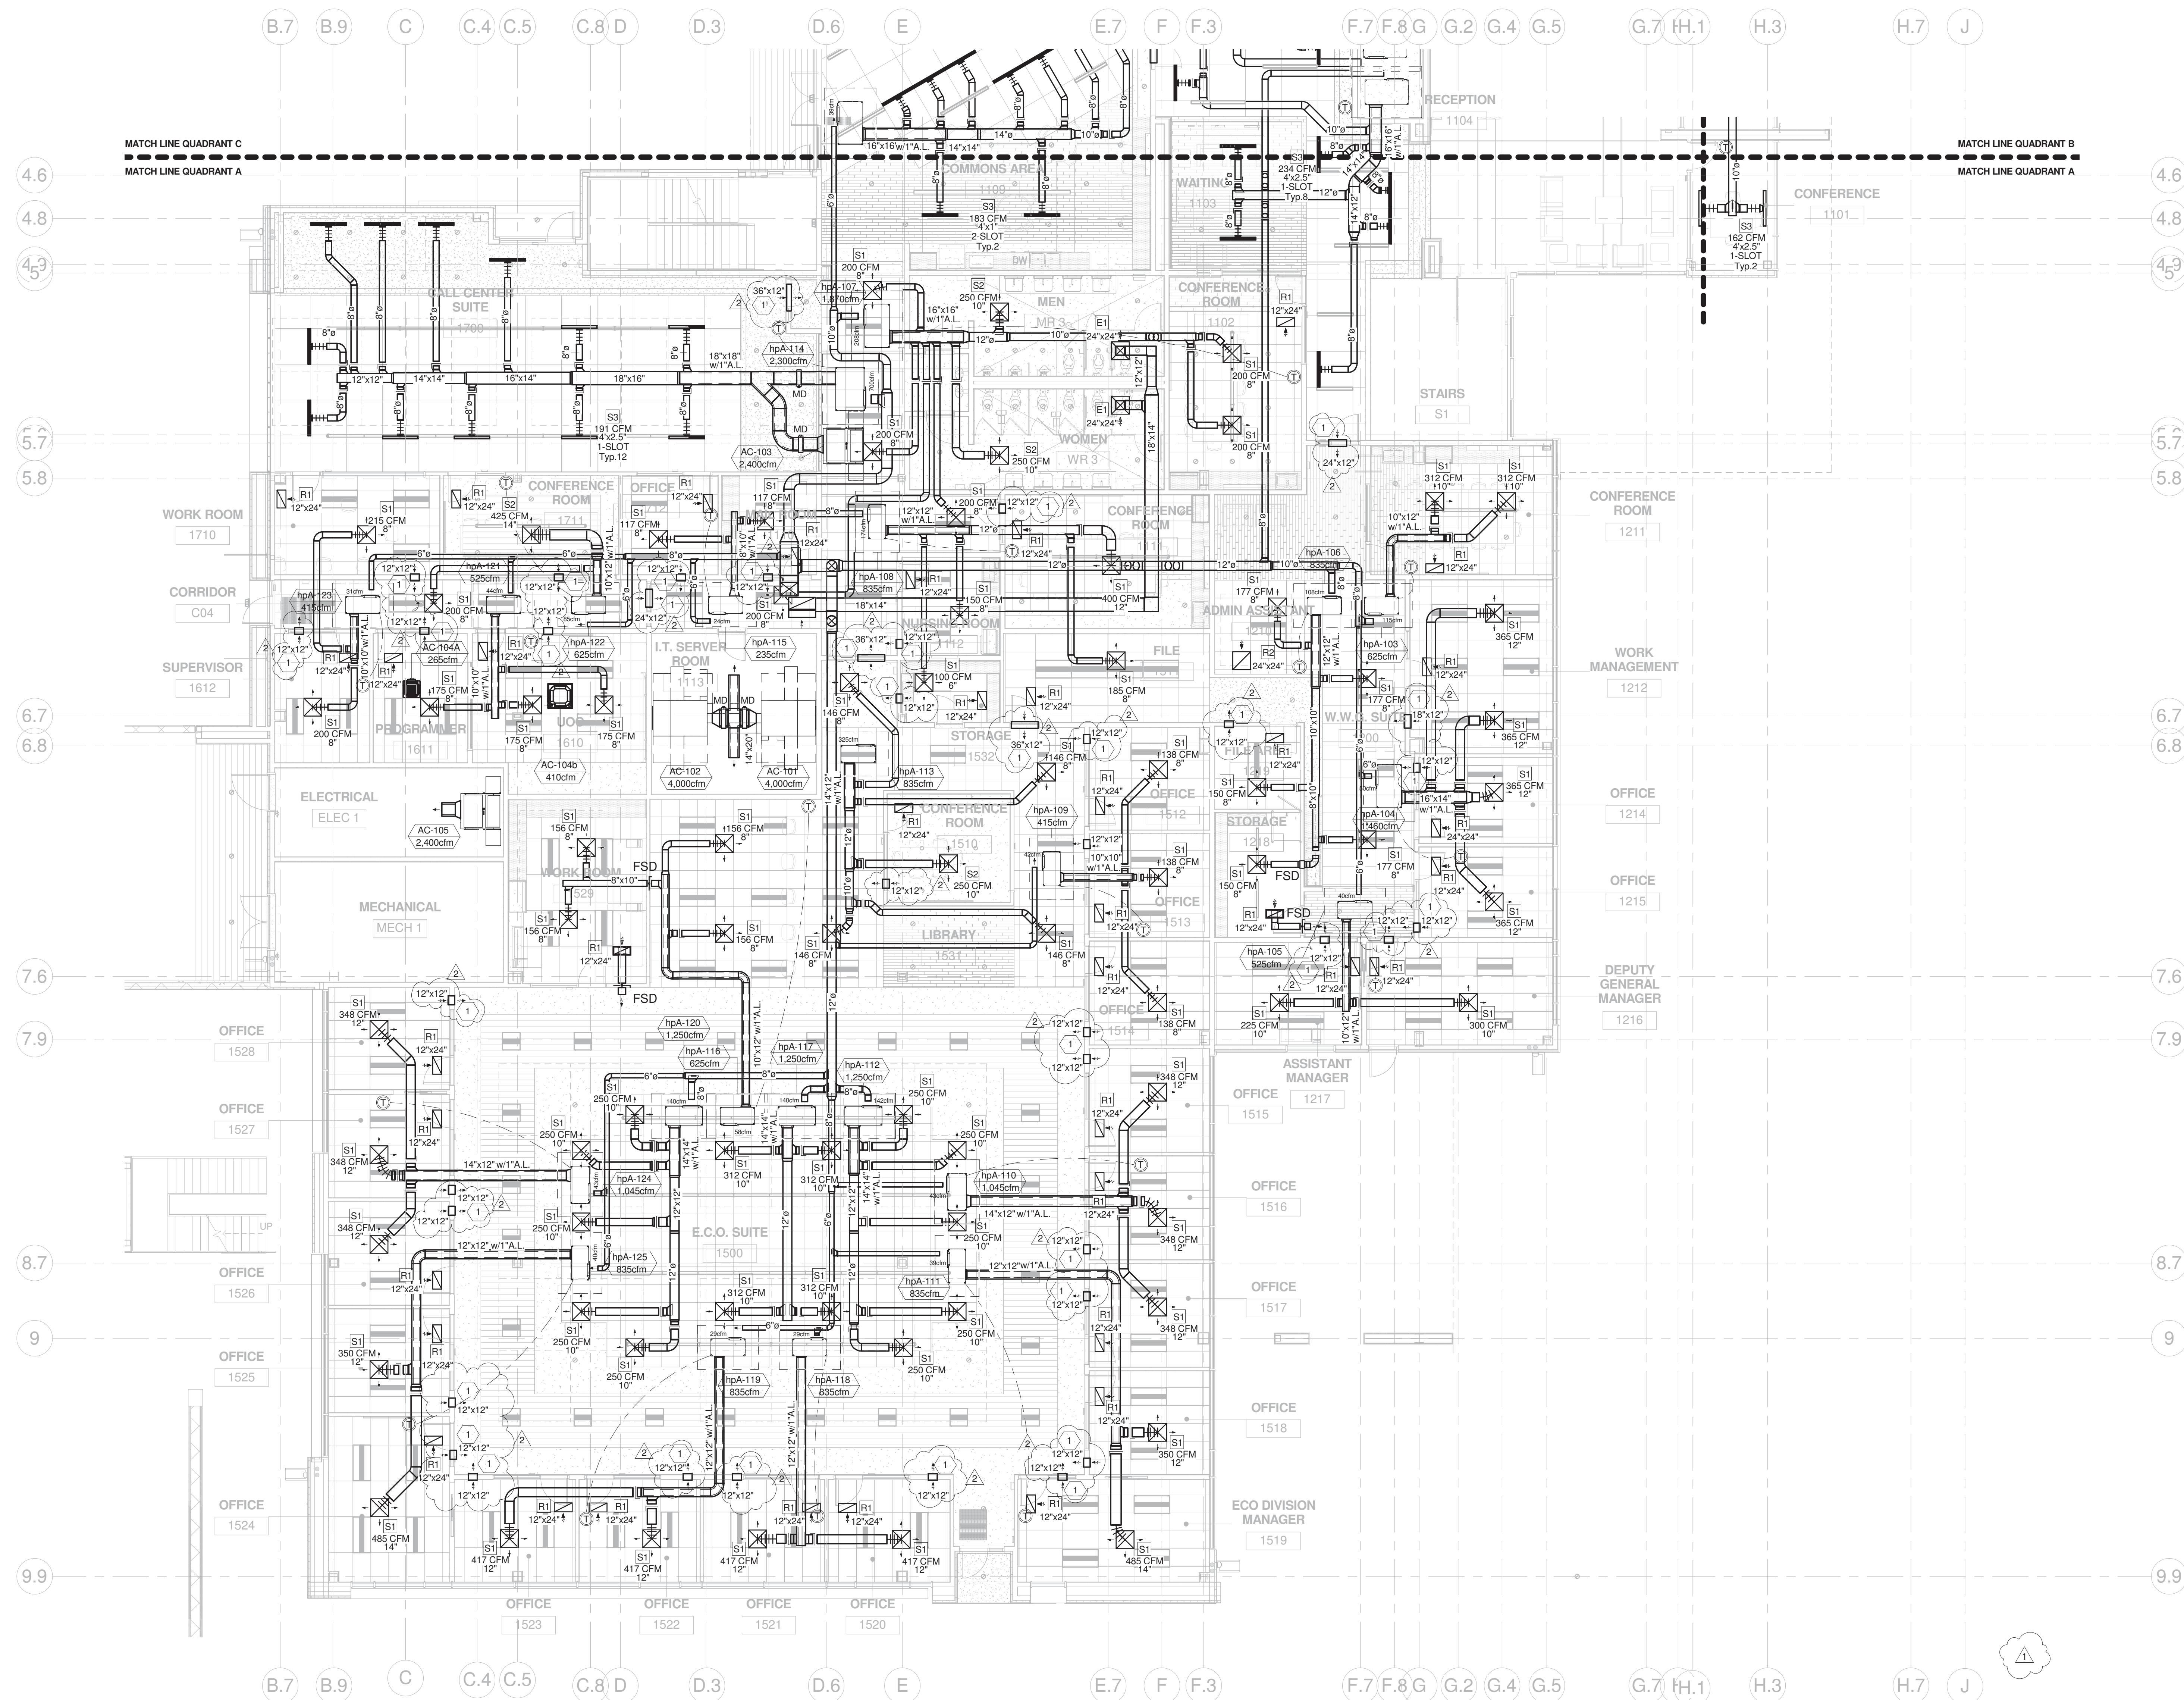


A5 MECHANICAL 1st FLOOR HVAC PLAN - QUADRANT A
1/8" = 1'-0"




4700 Lincoln Road, NE 1 Suite 101 Albuquerque, NM 87109 | 505.761.3100

DYRON MURPHY ARCHITECTS, P.C.

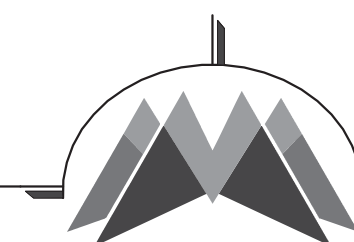

4505 Montbel Place NE, Albuquerque, New Mexico 87107

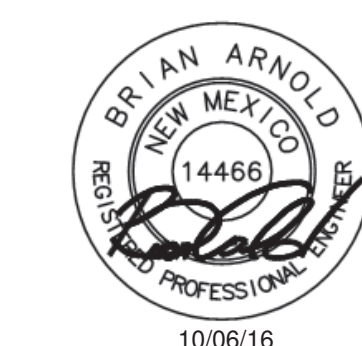

ENGINEER

Revision Schedule

Revision Number	Revision Date	Revision Description
1	10/27/16	ADD. 01
2	11/10/16	ADD.03

PROJECT NUMBER: 2016.05
DRAWN BY: DMT
PRQJ MGR: BA
RVT FILE: C:\Users\dmt\Documents\ArSed\15-037 NTUA HQ\15-037 NTUA HQ Bldg_Local\15_dspall.rvt

Sheet Number

M101a

Sequence of

MECHANICAL 1st FLOOR
HVAC PLAN - QUADRANT A

E

D

C

B

A

6

5

4

3

2

1

11/20/16 11:51:30 AM C:\Users\dmt\Documents\ArSed\15-037 NTUA HQ\15-037 NTUA HQ Bldg_Local\15_dspall.rvt D:\DYN\MURPHY_ARCHITECTS_P.C.

NTUA HQ COMPLEX OFFICE BUILDING


FT. DEFIANCE, ARIZONA

100% CONSTRUCTION DOCUMENTS

OCTOBER 6, 2016

KEYED NOTES:


- GREASE EXHAUST DUCT: INSTALL BETWEEN GREASE HOOD (KEH-xxx) AND KITCHEN EXHAUST FAN (KEF-xxx).
 - DUCTWORK IS 16GA. ALL WELDED CONSTRUCTION, SLOPE AT 1/4" PER FOOT TOWARDS HOOD EXHAUST OPENING.
 - INSTALL DUCT CLEANING ACCESS DOORS AT 5'-0" O.C. IN HORIZONTAL SECTIONS OF GREASE DUCTWORK.
 - GREASE DUCT ASSEMBLY WILL BE WRAPPED WITH TWO (2) LAYERS OF 1-1/2" THICK FIRETEMP DUCTWRAP. FOLLOW ALL MANUFACTURERS INSTALLATION INSTRUCTIONS TO MAINTAIN U.L. LISTING.
- DISHWASHER EXHAUST DUCT: INSTALL BETWEEN DISHWASHER AND EXHAUST FAN (KEF-007).
 - DUCTWORK IS 16GA. ALL WELDED CONSTRUCTION, SLOPE AT 1/4" PER FOOT TOWARDS HOOD EXHAUST OPENING.
- LOCATION OF RETURN AIR OPENING IN WALL ABOVE CEILING.

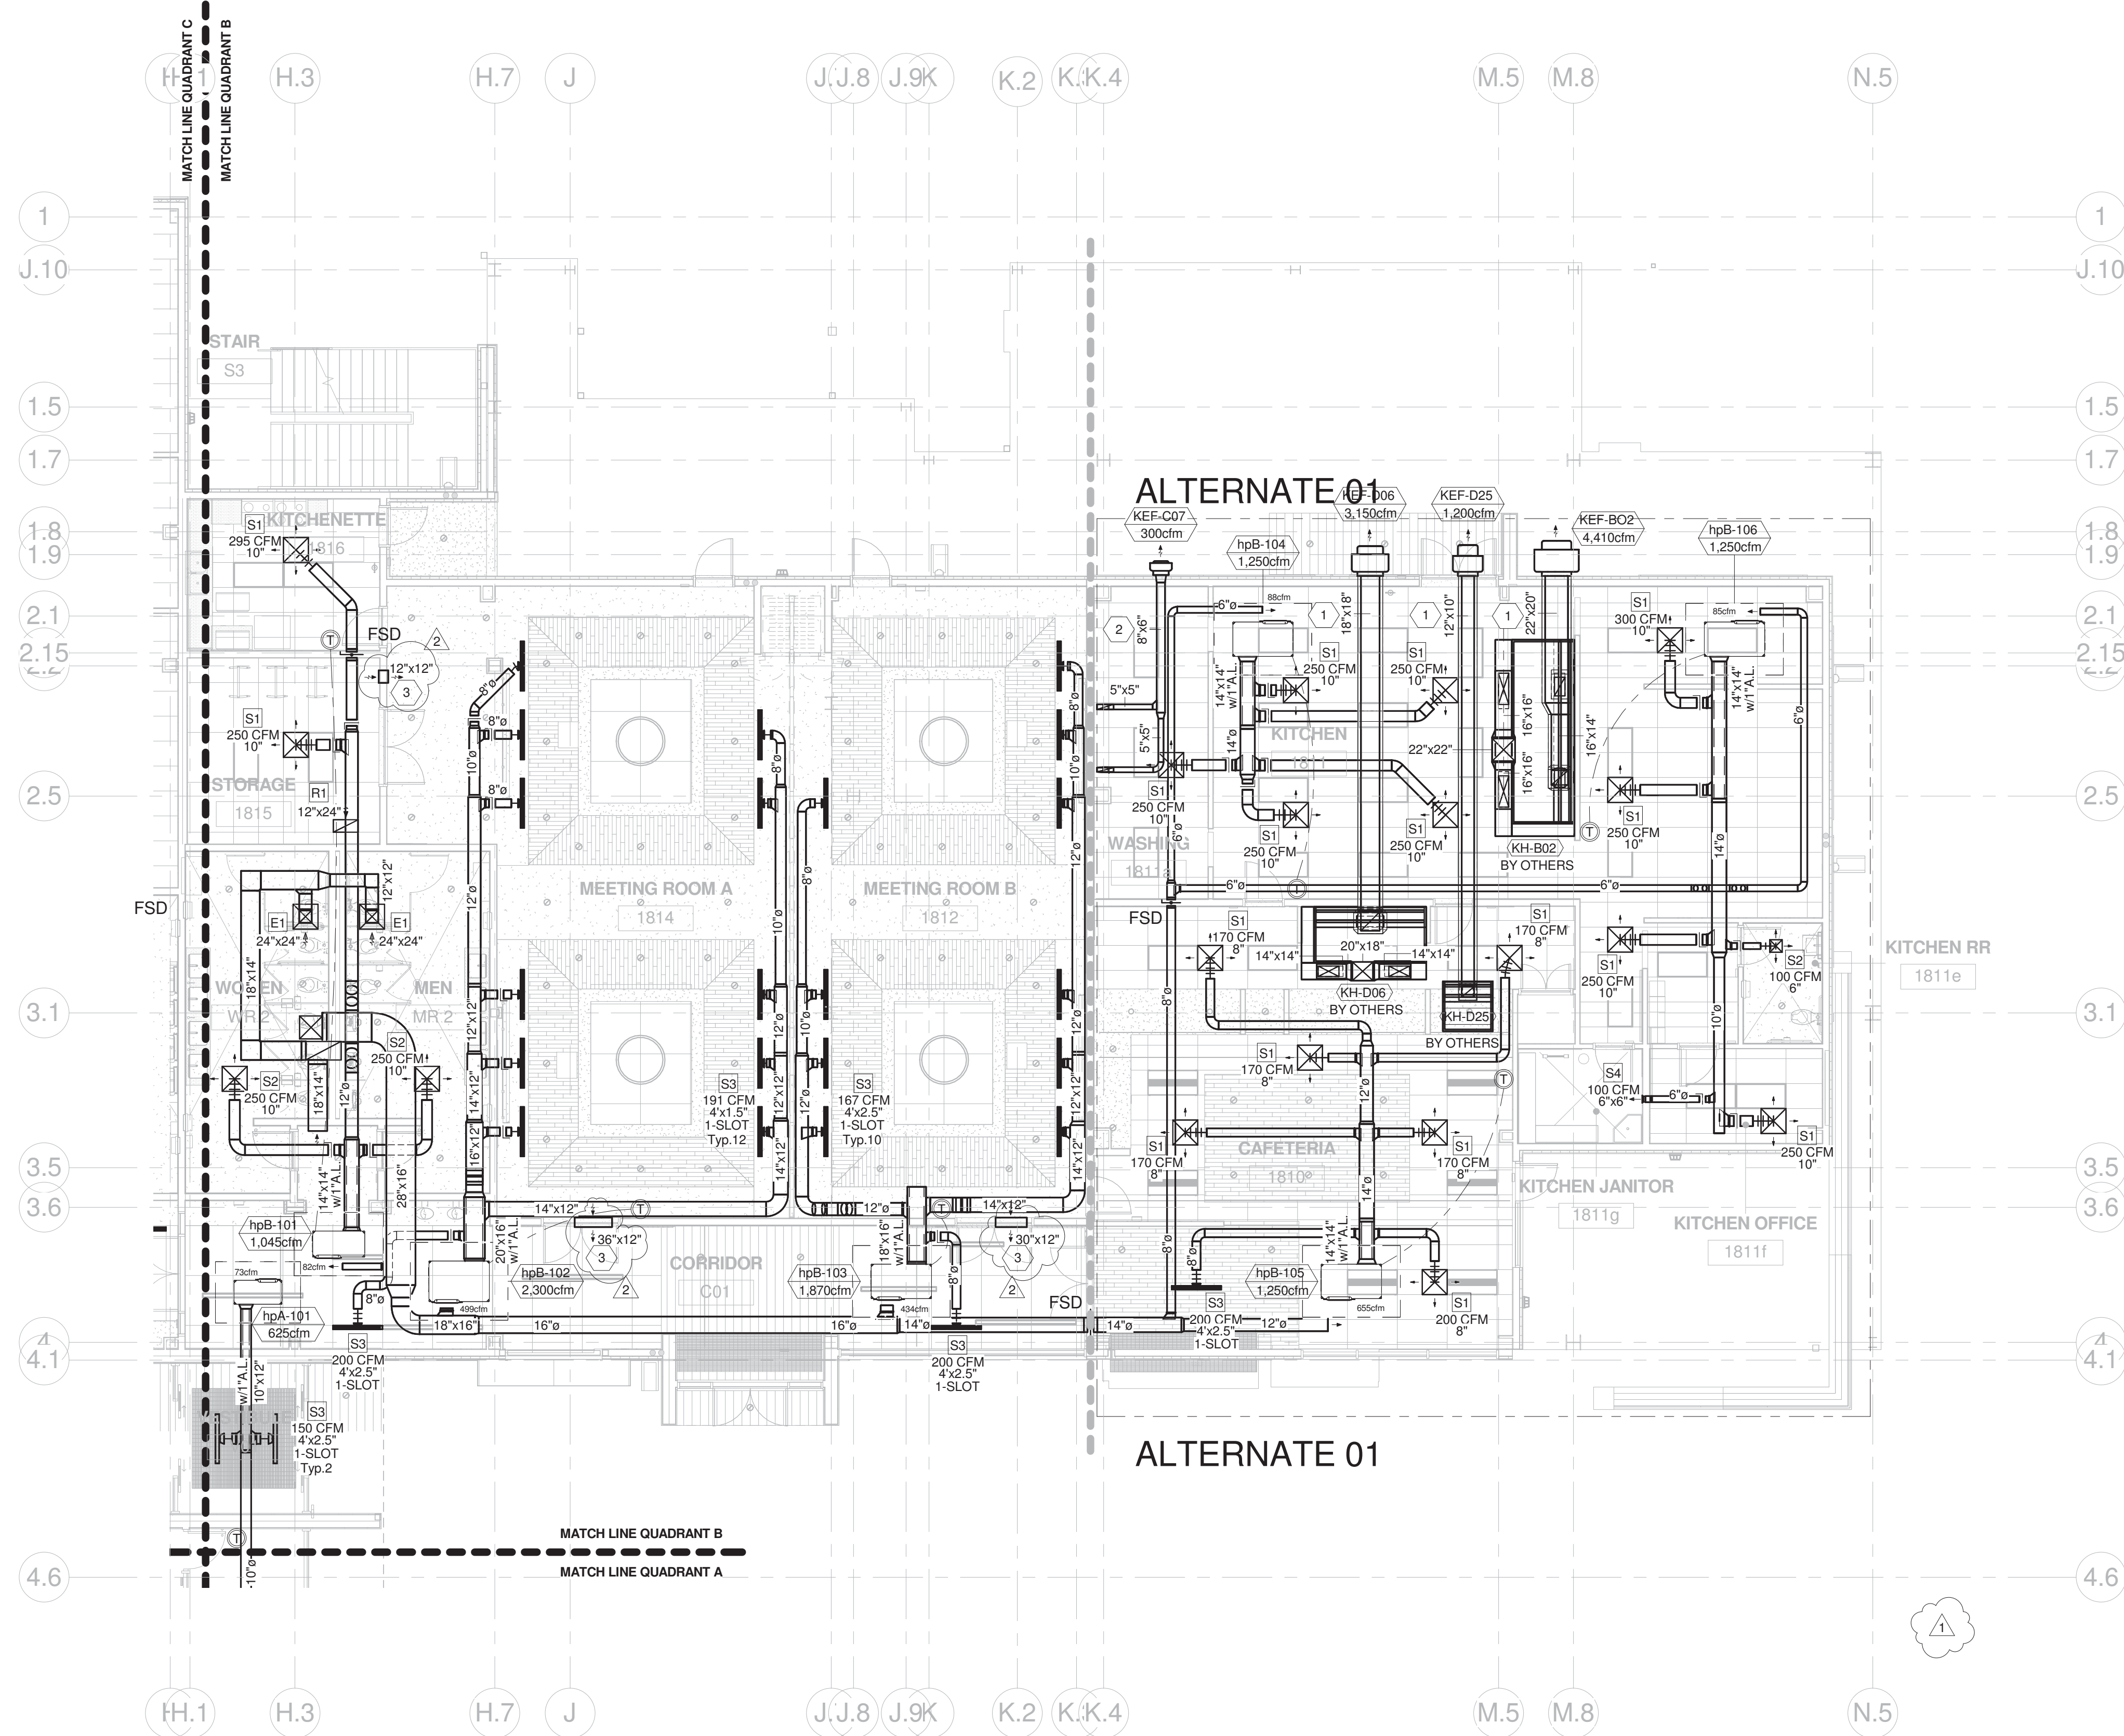

A4 MECHANICAL 1st FLOOR HVAC PLAN - QUADRANT B
1/8" = 1'-0"



DYRON MURPHY ARCHITECTS, P.C.

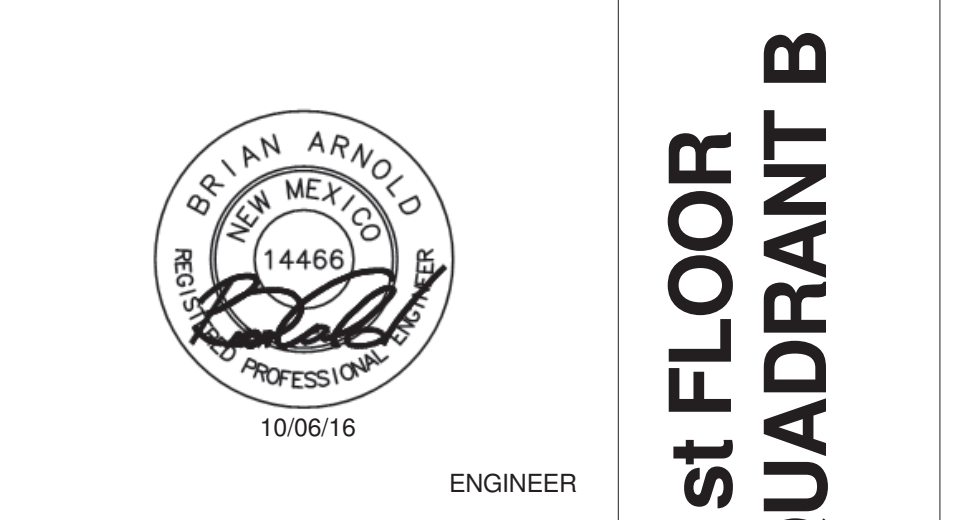

Revision Schedule		
Revision Number	Revision Date	Revision Description
1	10/27/16	ADD. 01
2	11/10/16	ADD.03

PROJECT NUMBER: 2015.05
DRAWN BY: DMT
PROJ MGR: BA
RVT FILE: C:\Users\dmtapia\Documents\ArSed\15-037 NTUA HQ\15-037 NTUA HQ Bldg_Locall-15_dspall.rvt

Sheet Title: MECHANICAL 1st FLOOR HVAC PLAN - QUADRANT B

Sheet Number: **M101b**
Sequence of

E
D
C
B
A

6 5 4 3 2 1

11/20/16 11:57 AM C:\Users\dmtapia\Documents\ArSed\15-037 NTUA HQ\15-037 NTUA HQ Bldg_Locall-15_dspall.rvt DYRON MURPHY ARCHITECTS, P.C.

NTUA HQ COMPLEX
OFFICE BUILDING


FT. DEFIANCE, ARIZONA

100% CONSTRUCTION DOCUMENTS

OCTOBER 6, 2016

KEYED NOTES

1. LOCATION OF RETURN AIR WALL OPENING IN WALL ABOVE CEILING.

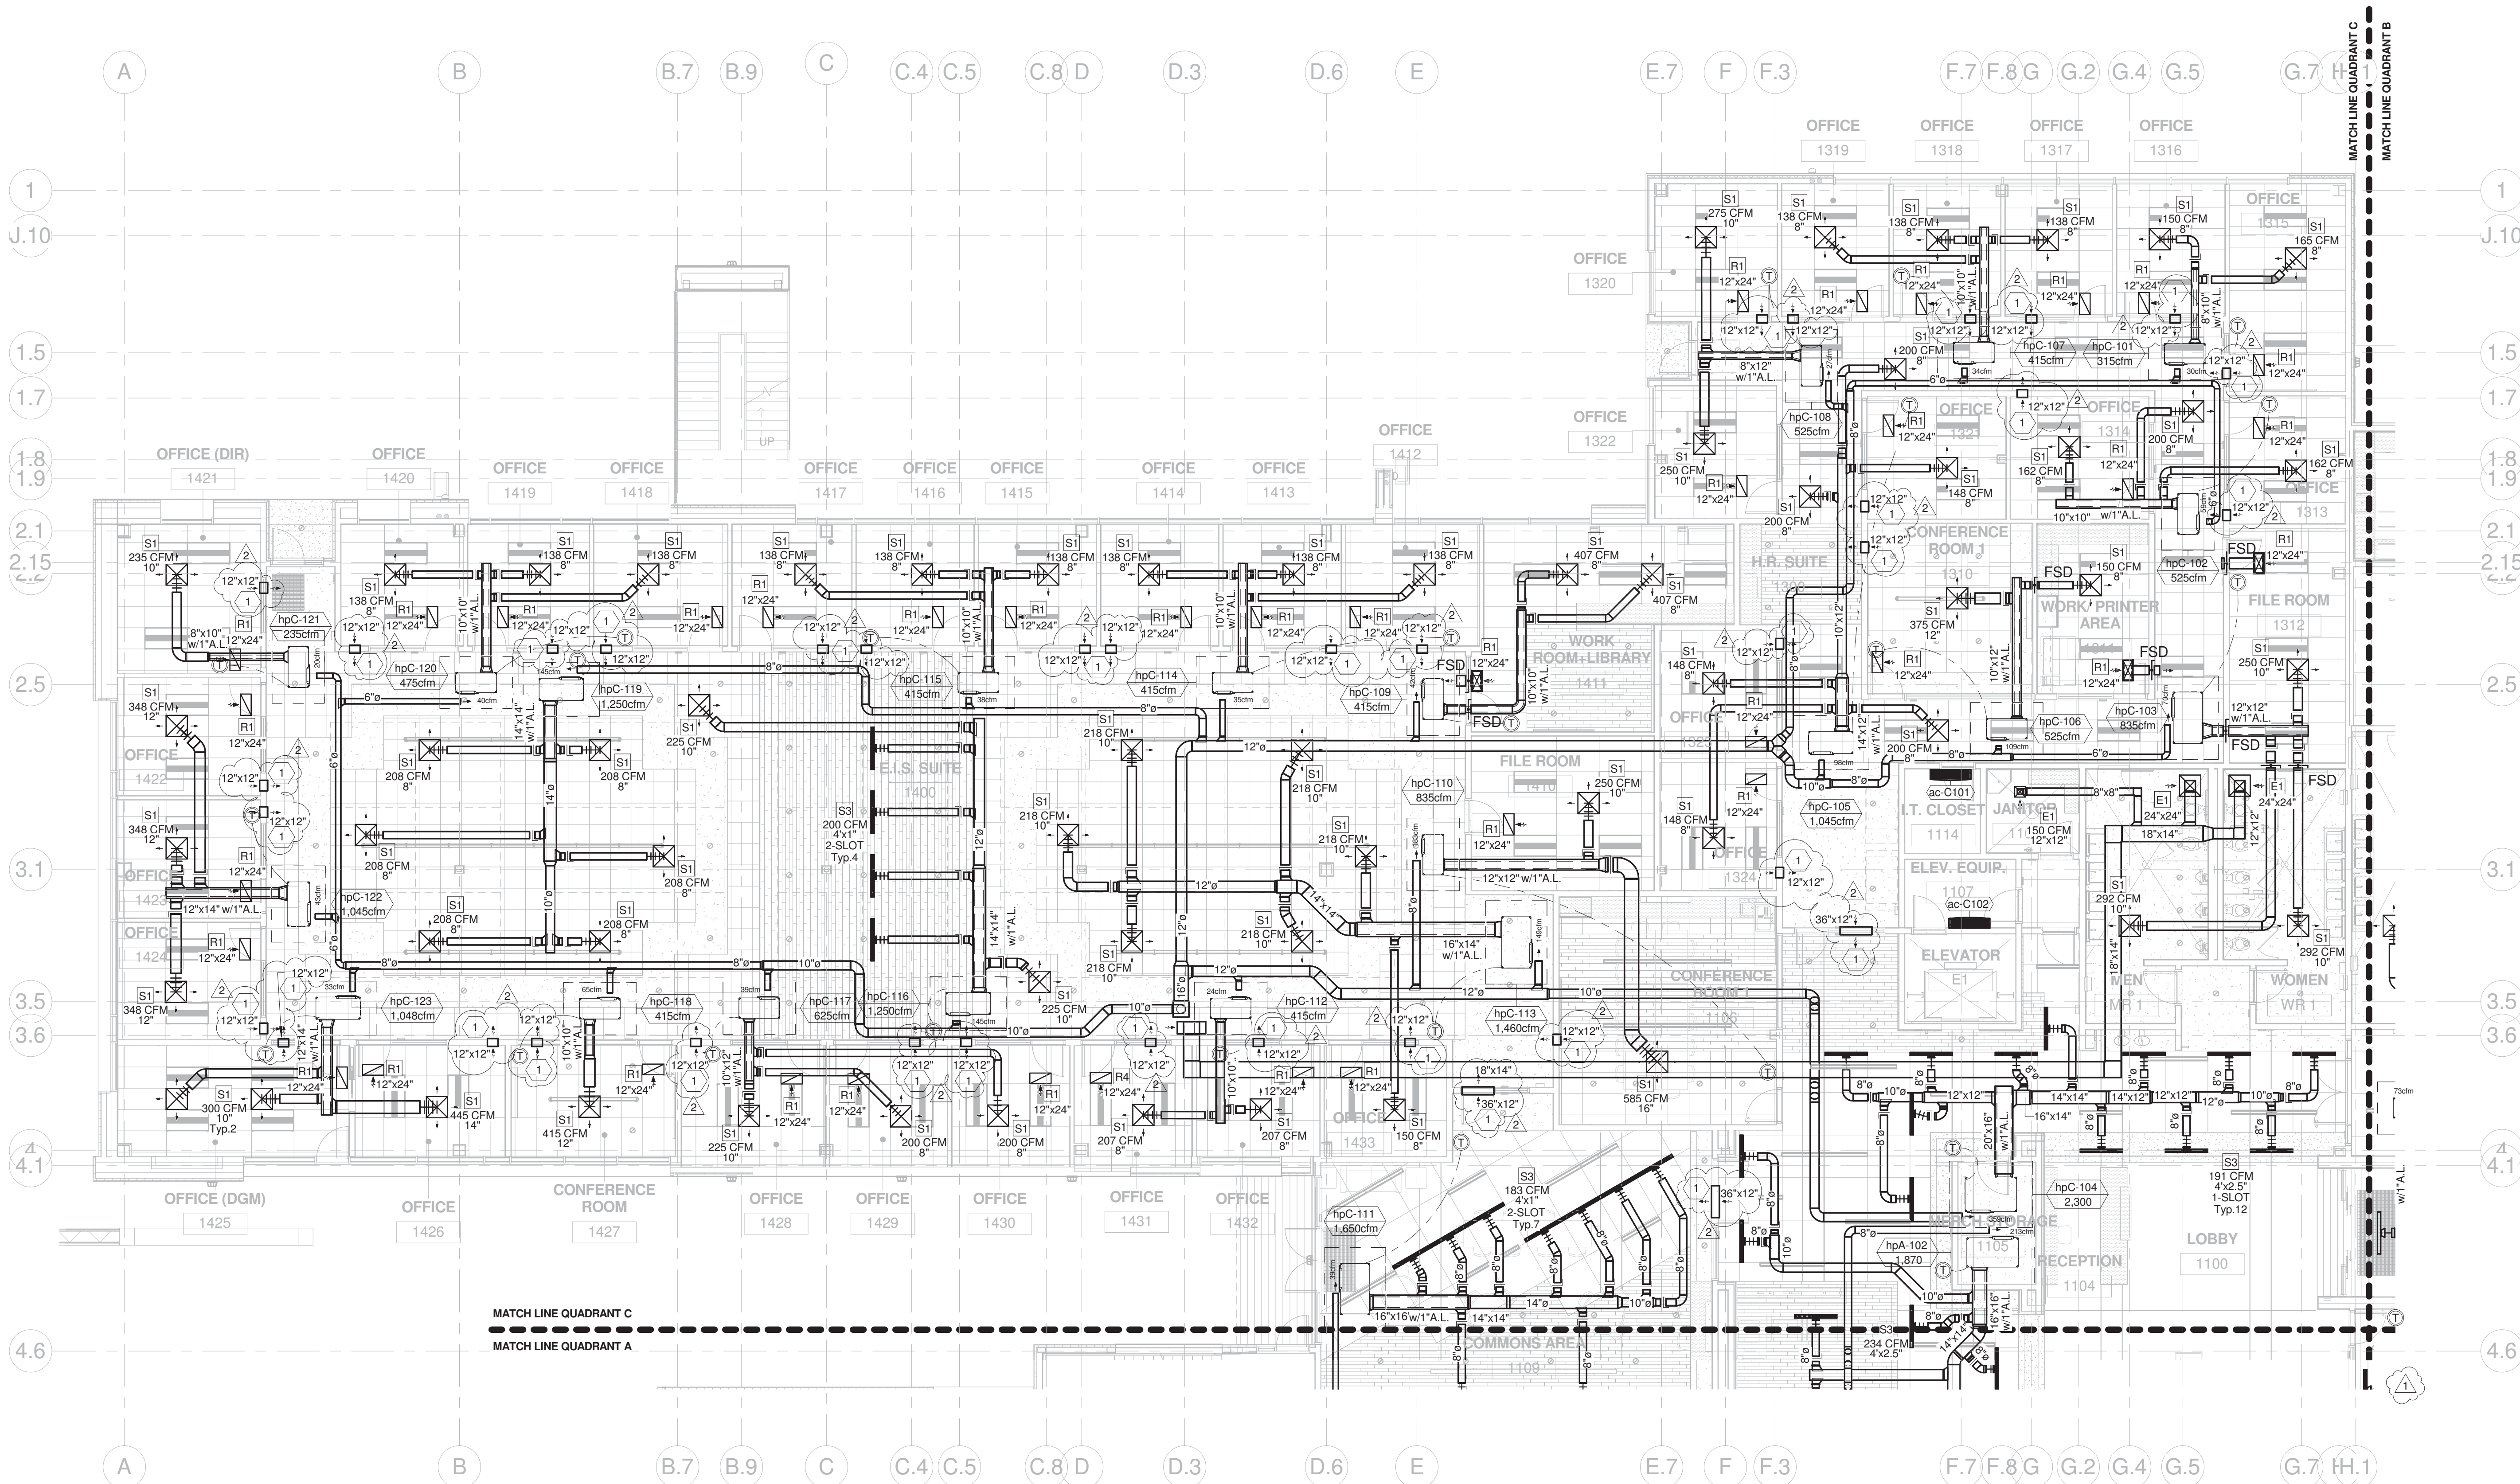


A5 MECHANICAL 1st FLOOR HVAC PLAN - QUADRANT C
1/8" = 1'-0"



4700 Lincoln Road, NE 1 Suite 101 | Albuquerque, NM 87109 | 505.761.3100

DYRON MURPHY ARCHITECTS, P.C.

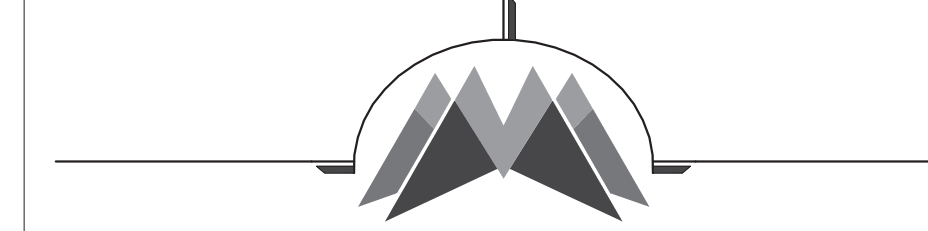

4505 Montbel Place NE, Albuquerque, New Mexico 87107

Professional Engineer Seal for Brian Arnold, License No. 14466, State of New Mexico, dated 10/06/16.

Revision Schedule		
Revision Number	Revision Date	Revision Description
1	10/27/16	ADD. 01
2	11/10/16	ADD.03

PROJECT NUMBER: 2015.05
DRAWN BY: DMT
PROJ MGR: BA
RVT FILE: C:\Users\dmtapia\Documents\Arsed\15-037 NTUA HQ\15-037 NTUA HQ Bldg_Local\15_dspal1.rvt
Sheet Number

M101c

Sequence of

MECHANICAL 1st FLOOR
HVAC PLAN - QUADRANT C

E
D
C
B
A

6 5 4 3 2 1

11/20/16 11:58 AM C:\Users\dmtapia\Documents\Arsed\15-037 NTUA HQ\15-037 NTUA HQ Bldg_Local\15_dspal1.rvt D:\D.MURPHY ARCHITECTS, P.C.

**NTUA HQ COMPLEX
OFFICE BUILDING**


FT. DEFIANCE, ARIZONA

100% CONSTRUCTION DOCUMENTS

OCTOBER 6, 2016

KEYED NOTES

1. LOCATION OF RETURN AIR WALL OPENING IN WALL ABOVE CEILING.

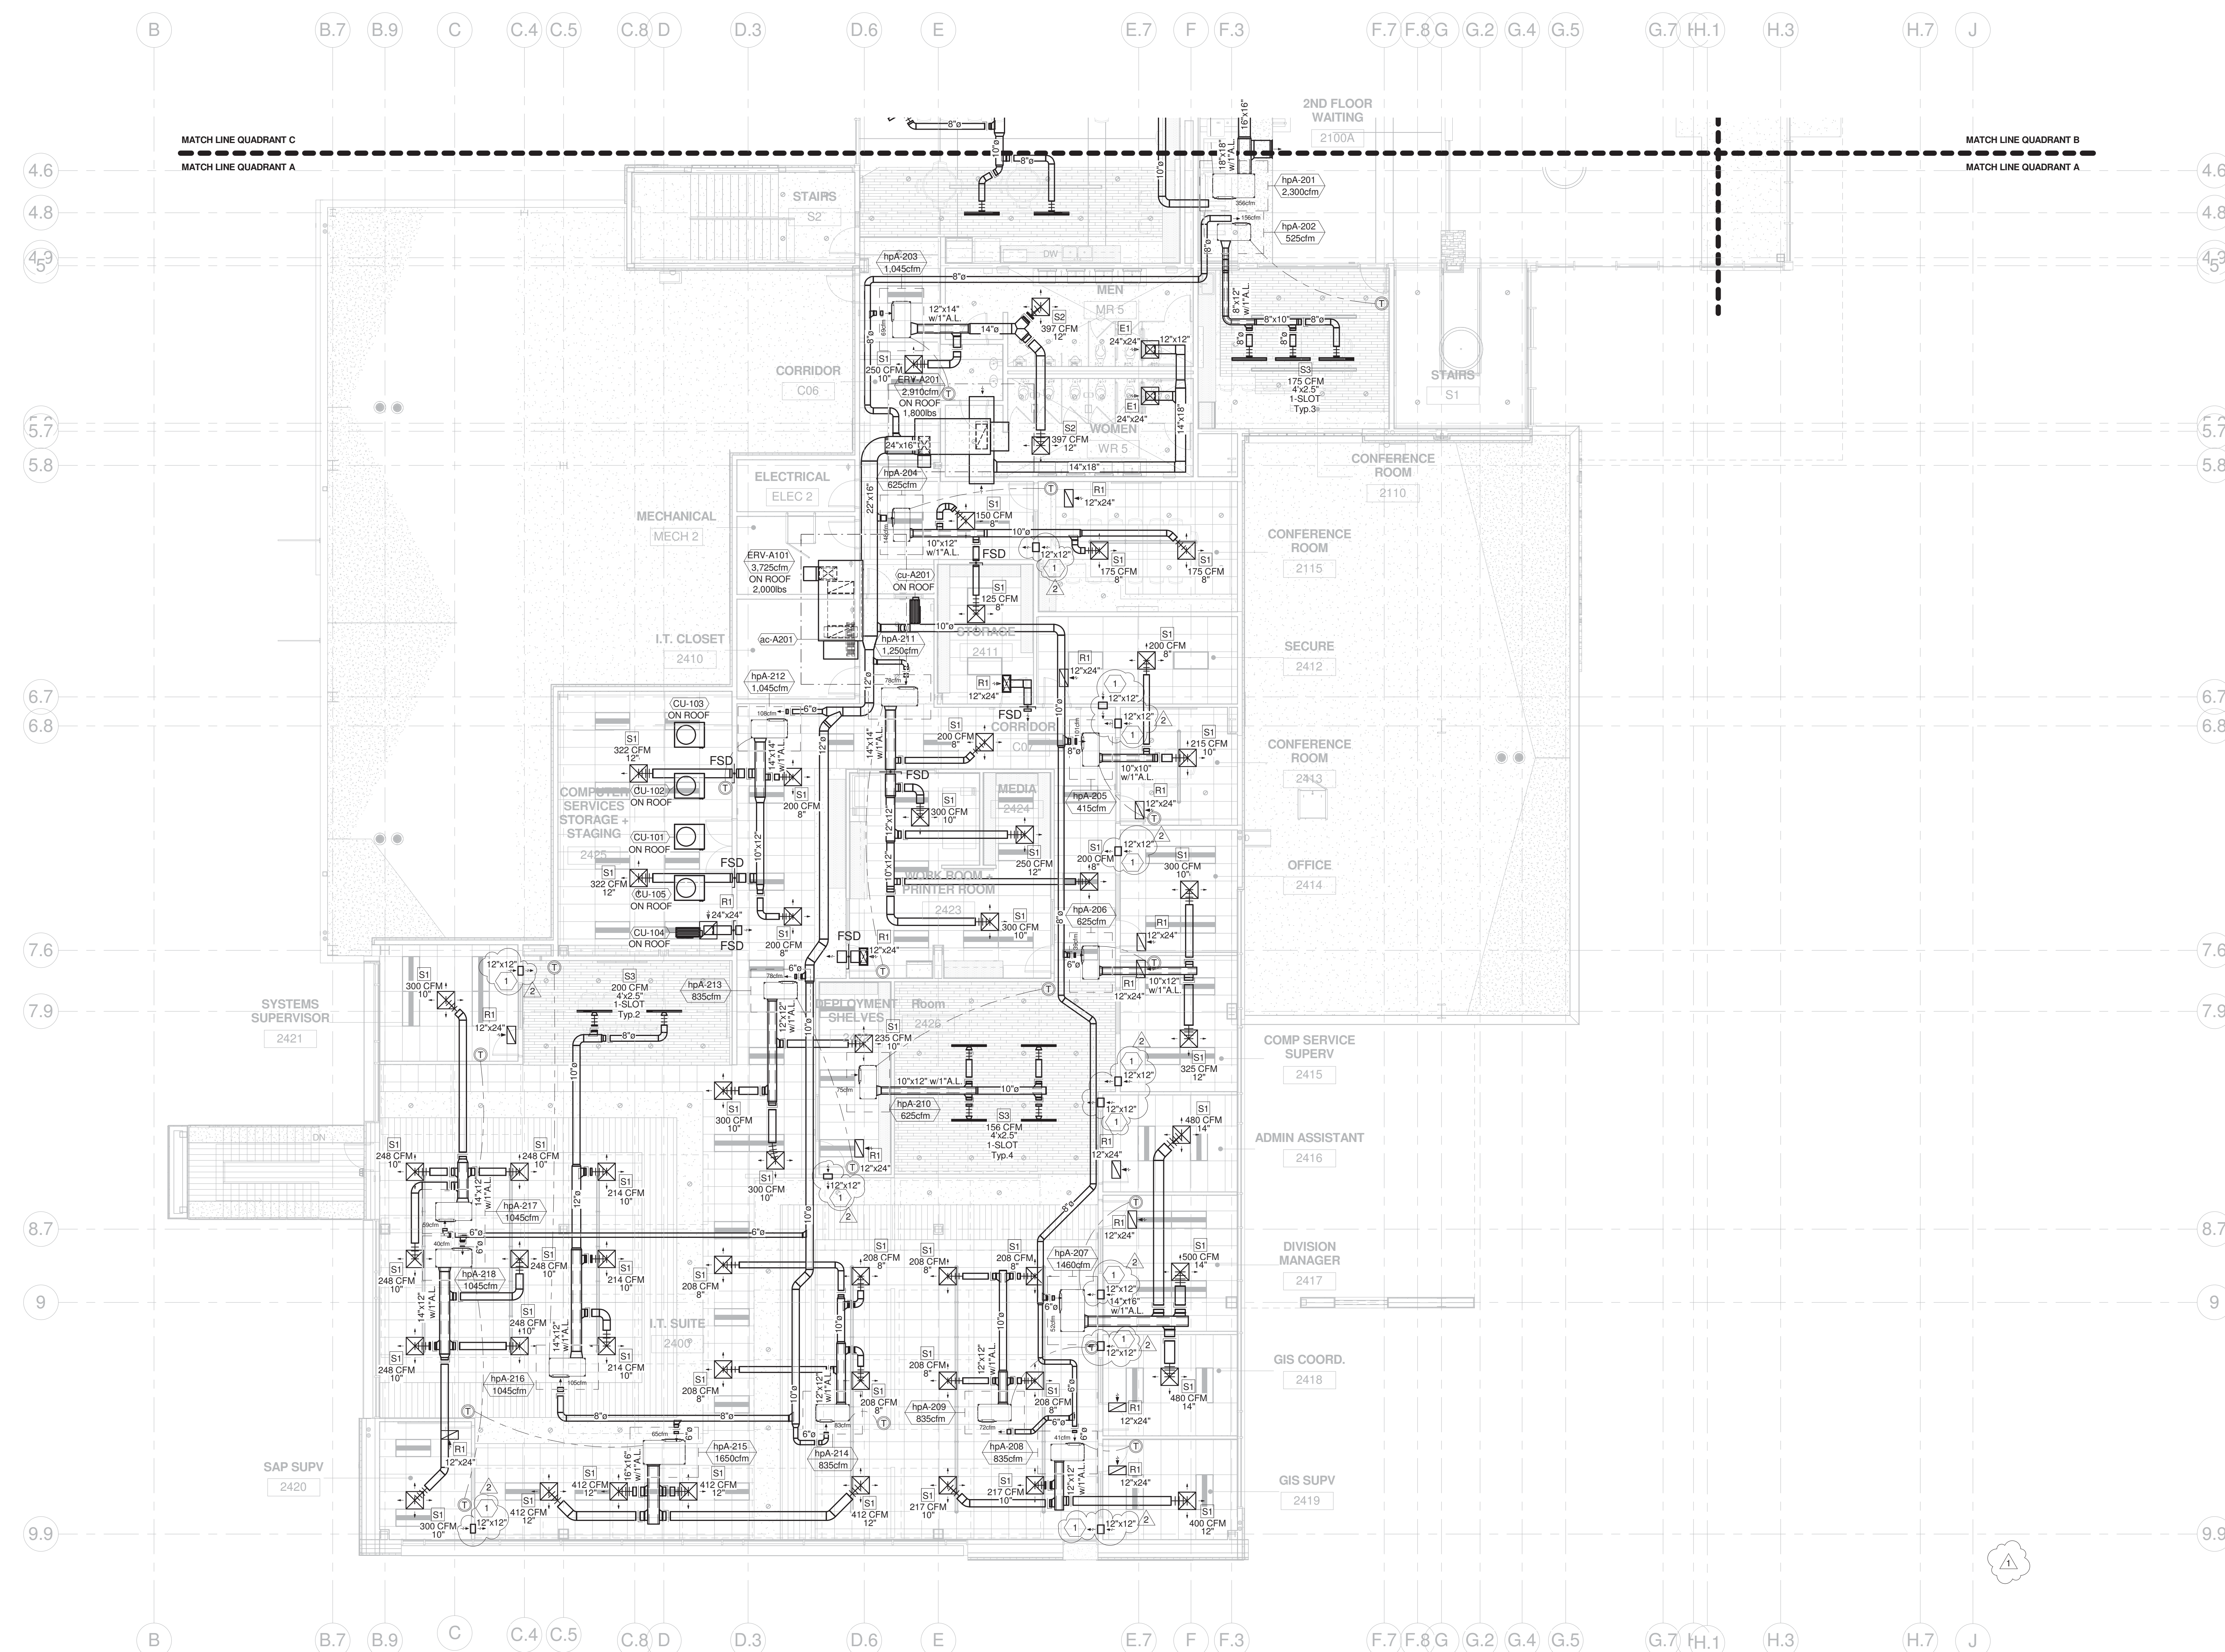

A5 MECHANICAL 2nd FLOOR HVAC PLAN - QUADRANT A
1/8" = 1'-0"




4700 Lincoln Road, NE | Suite 101 | Albuquerque, NM 87109 | 505.761.3100

DYRON MURPHY ARCHITECTS, P.C.



4505 Montbel Place NE, Albuquerque, New Mexico 87107

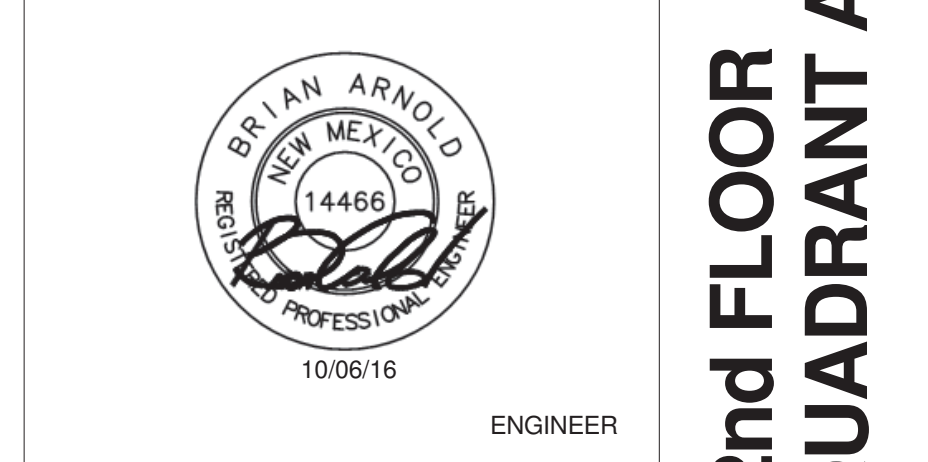

Revision Schedule		
Revision Number	Revision Date	Revision Description
1	10/27/16	ADD. 01
2	11/10/16	ADD.03

PROJECT NUMBER: 2015.05
DRAWN BY: DMT
PROJ MGR: BA
RVT FILE: C:\Users\dmtapia\Documents\ArSed\15-037 NTUA HQ\15-037 NTUA HQ Bldg_Local\15_dspall.rvt

Sheet Title: **MECHANICAL 2nd FLOOR HVAC PLAN - QUADRANT A**

Sheet Number: **M102a**

Sequence of

E
D
C
B
A

B B.7 B.9 C C.4 C.5 C.8 D D.3 D.6 E E.7 F F.3 F.7 F.8 G G.2 G.4 G.5 G.7 H.1 H.3 H.7 J

4.6 4.8 4.9 5.7 5.8 6.7 6.8 7.6 7.9 8.7 9 9.9

6 5 4 3 2 1

11/20/16 11:59:26 AM
C:\Users\dmtapia\Documents\ArSed\15-037 NTUA HQ\15-037 NTUA HQ Bldg_Local\15_dspall.rvt
DYRON MURPHY ARCHITECTS, P.C.

**NTUA HQ COMPLEX
OFFICE BUILDING**


FT. DEFIANCE, ARIZONA

100% CONSTRUCTION DOCUMENTS


OCTOBER 6, 2016

KEYED NOTES

1. LOCATION OF RETURN AIR WALL OPENING IN WALL ABOVE CEILING.

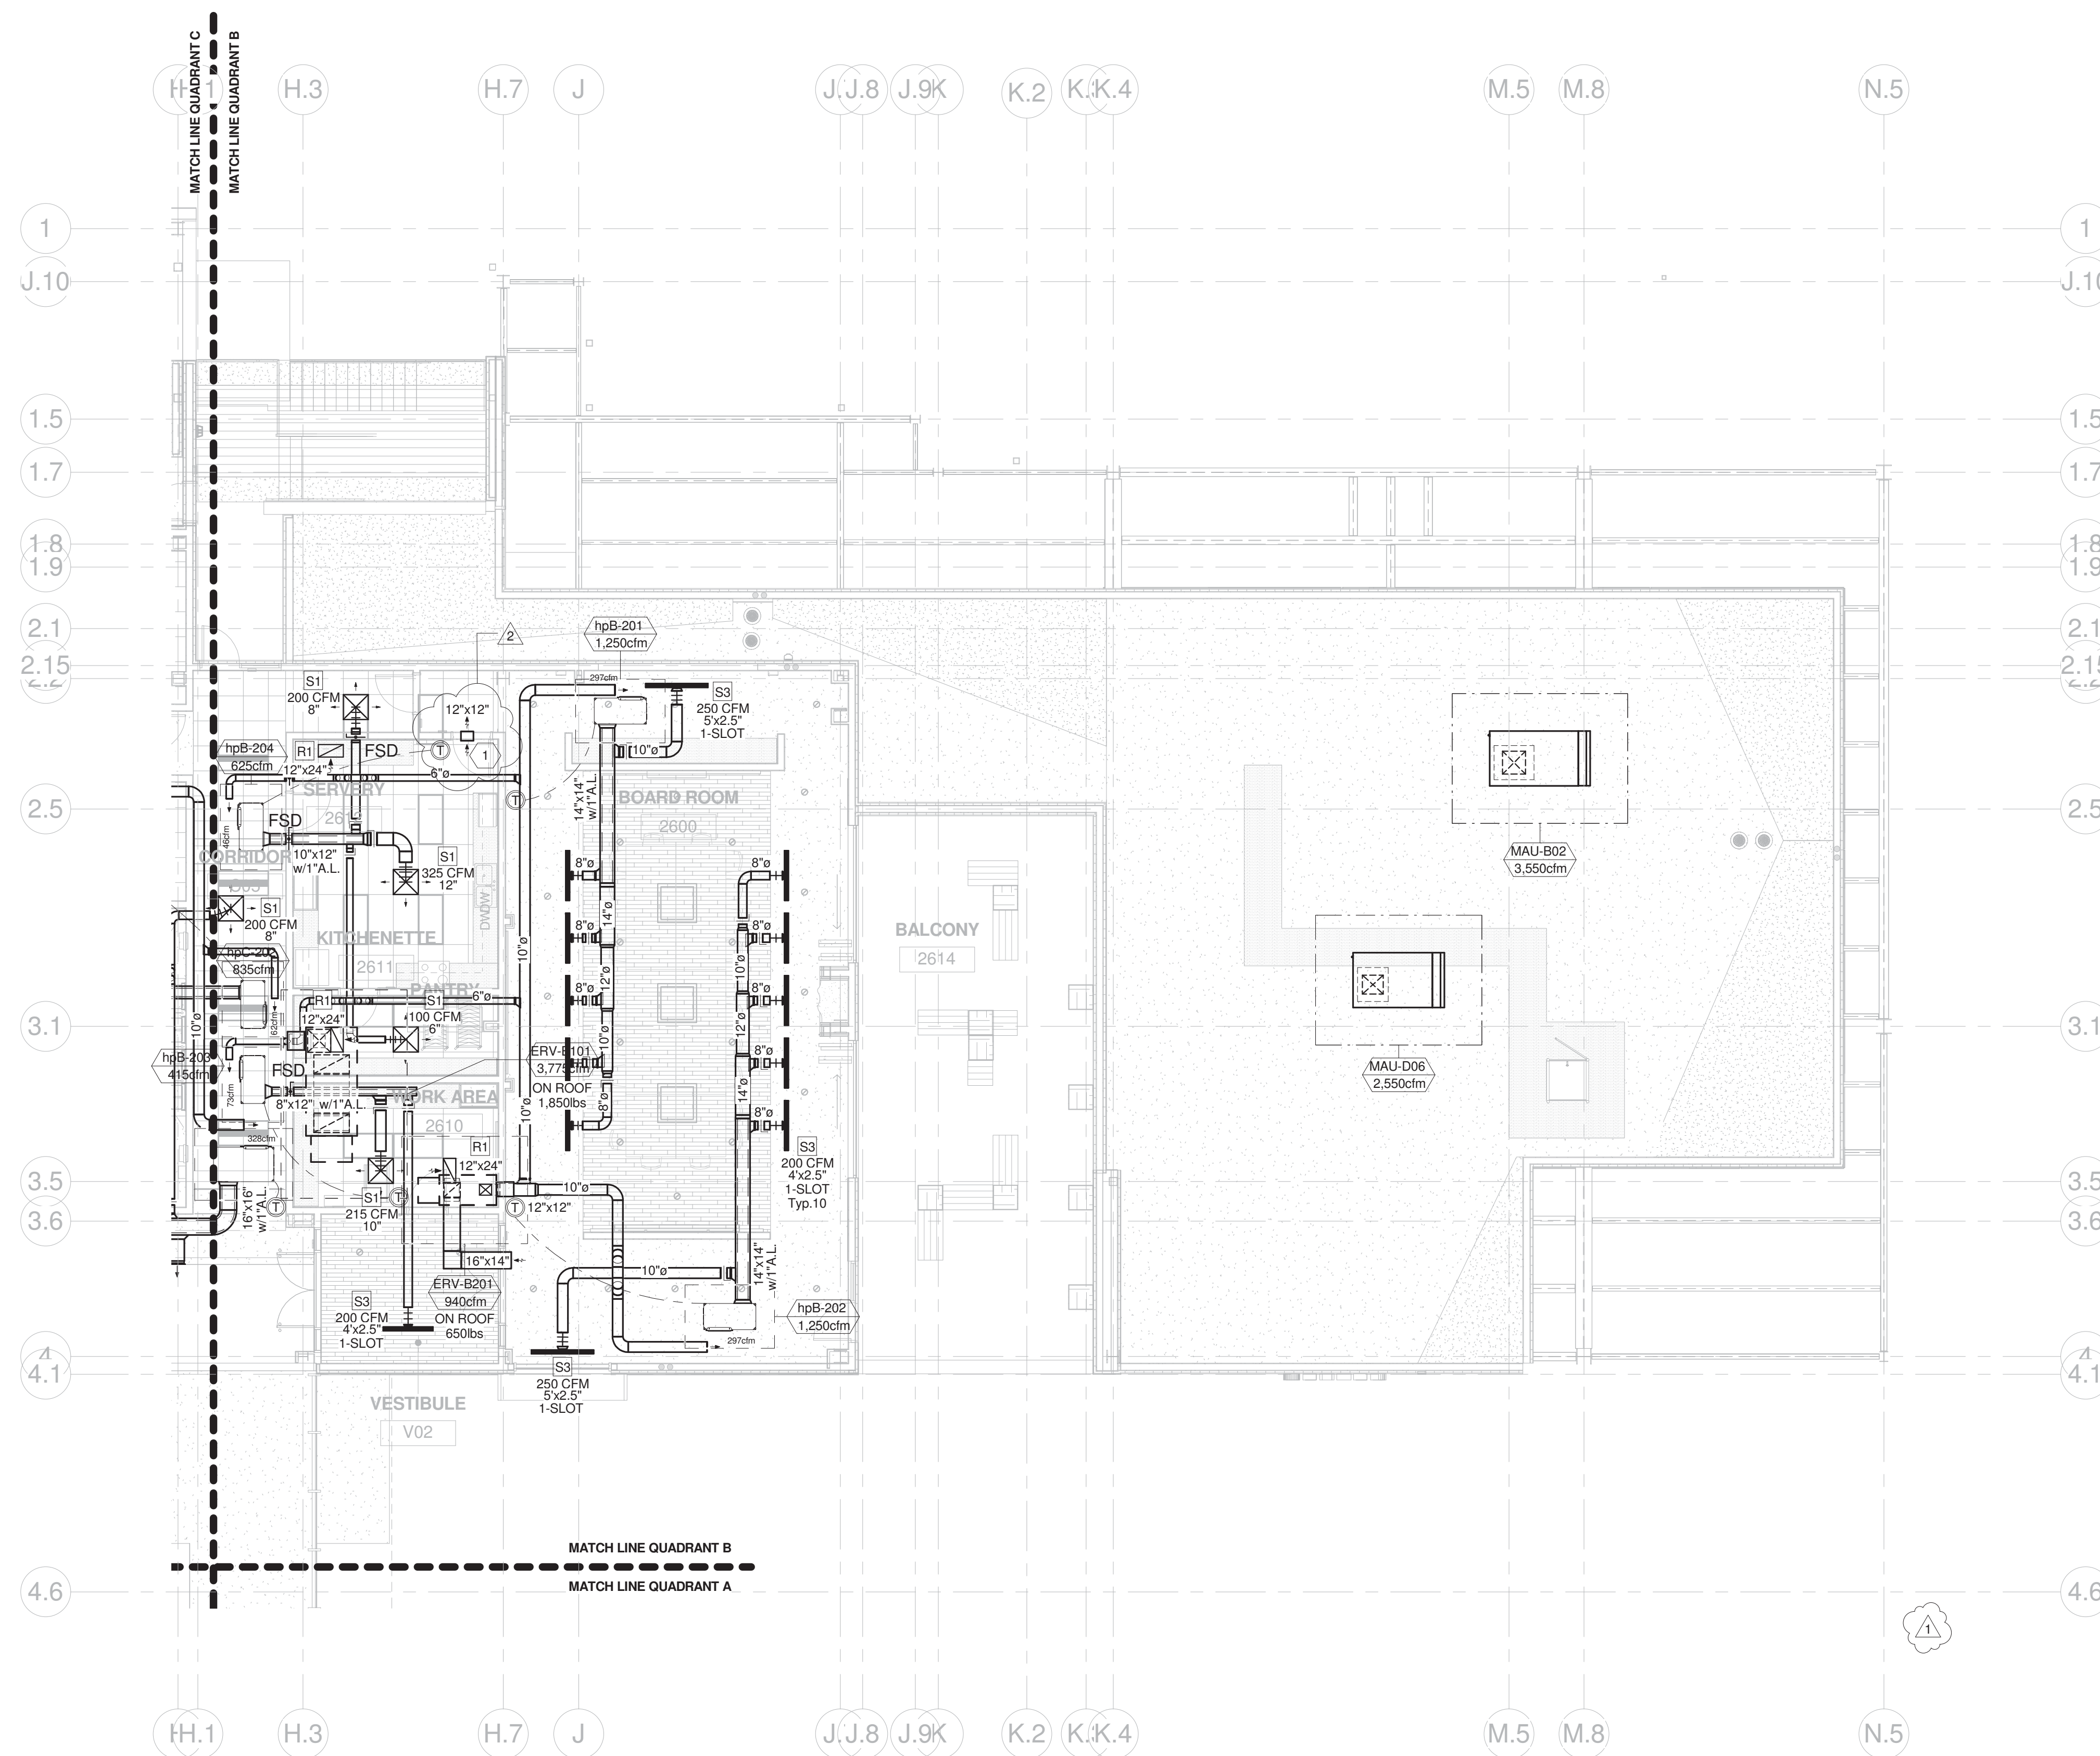


2 MECHANICAL 2nd FLOOR HVAC PLAN - QUADRANT B
1/8" = 1'-0"

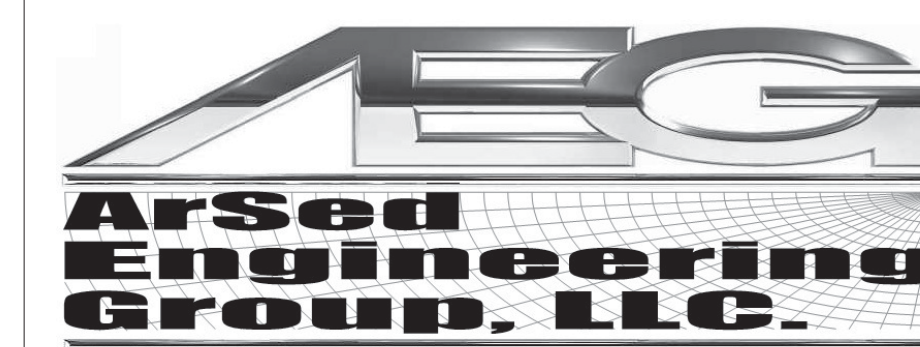


4700 Lincoln Road, NE 1 Suite 101 | Albuquerque, NM 87109 | 505.761.3100

DYRON MURPHY ARCHITECTS, P.C.

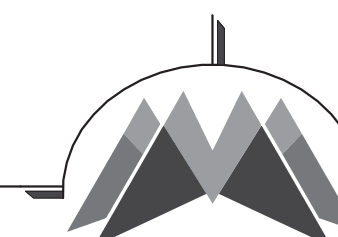

4505 Montbel Place NE, Albuquerque, New Mexico 87107

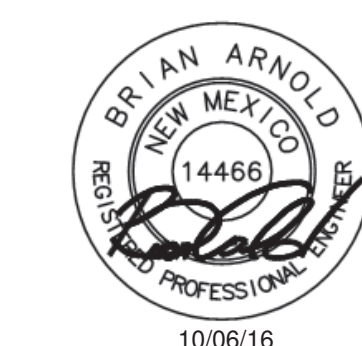

ENGINEER

Revision Schedule

Revision Number	Revision Date	Revision Description
1	10/27/16	ADD. 01
2	11/10/16	ADD.03

PROJECT NUMBER: 2015.05
DRAWN BY: DMT
PROJ MGR: BA
RVT FILE: C:\Users\dmtapia\Documents\ArSed\15-037 NTUA HQ\15-037 NTUA HQ Bldg_Local\15_dspall.rvt

Sheet Number

M102b

Sequence of

**MECHANICAL 2nd FLOOR
HVAC PLAN - QUADRANT B**

E
D
C
B
A

6 5 4 3 2 1

11/20/16 11:59:00 AM
C:\Users\dmtapia\Documents\ArSed\15-037 NTUA HQ\15-037 NTUA HQ Bldg_Local\15_dspall.rvt
DYRON MURPHY ARCHITECTS, P.C.


**NTUA HQ COMPLEX
OFFICE BUILDING**

FT. DEFIANCE, ARIZONA

100% CONSTRUCTION DOCUMENTS

OCTOBER 6, 2016

KEYED NOTES
1. LOCATION OF RETURN AIR WALL OPENING IN WALL ABOVE CEILING.

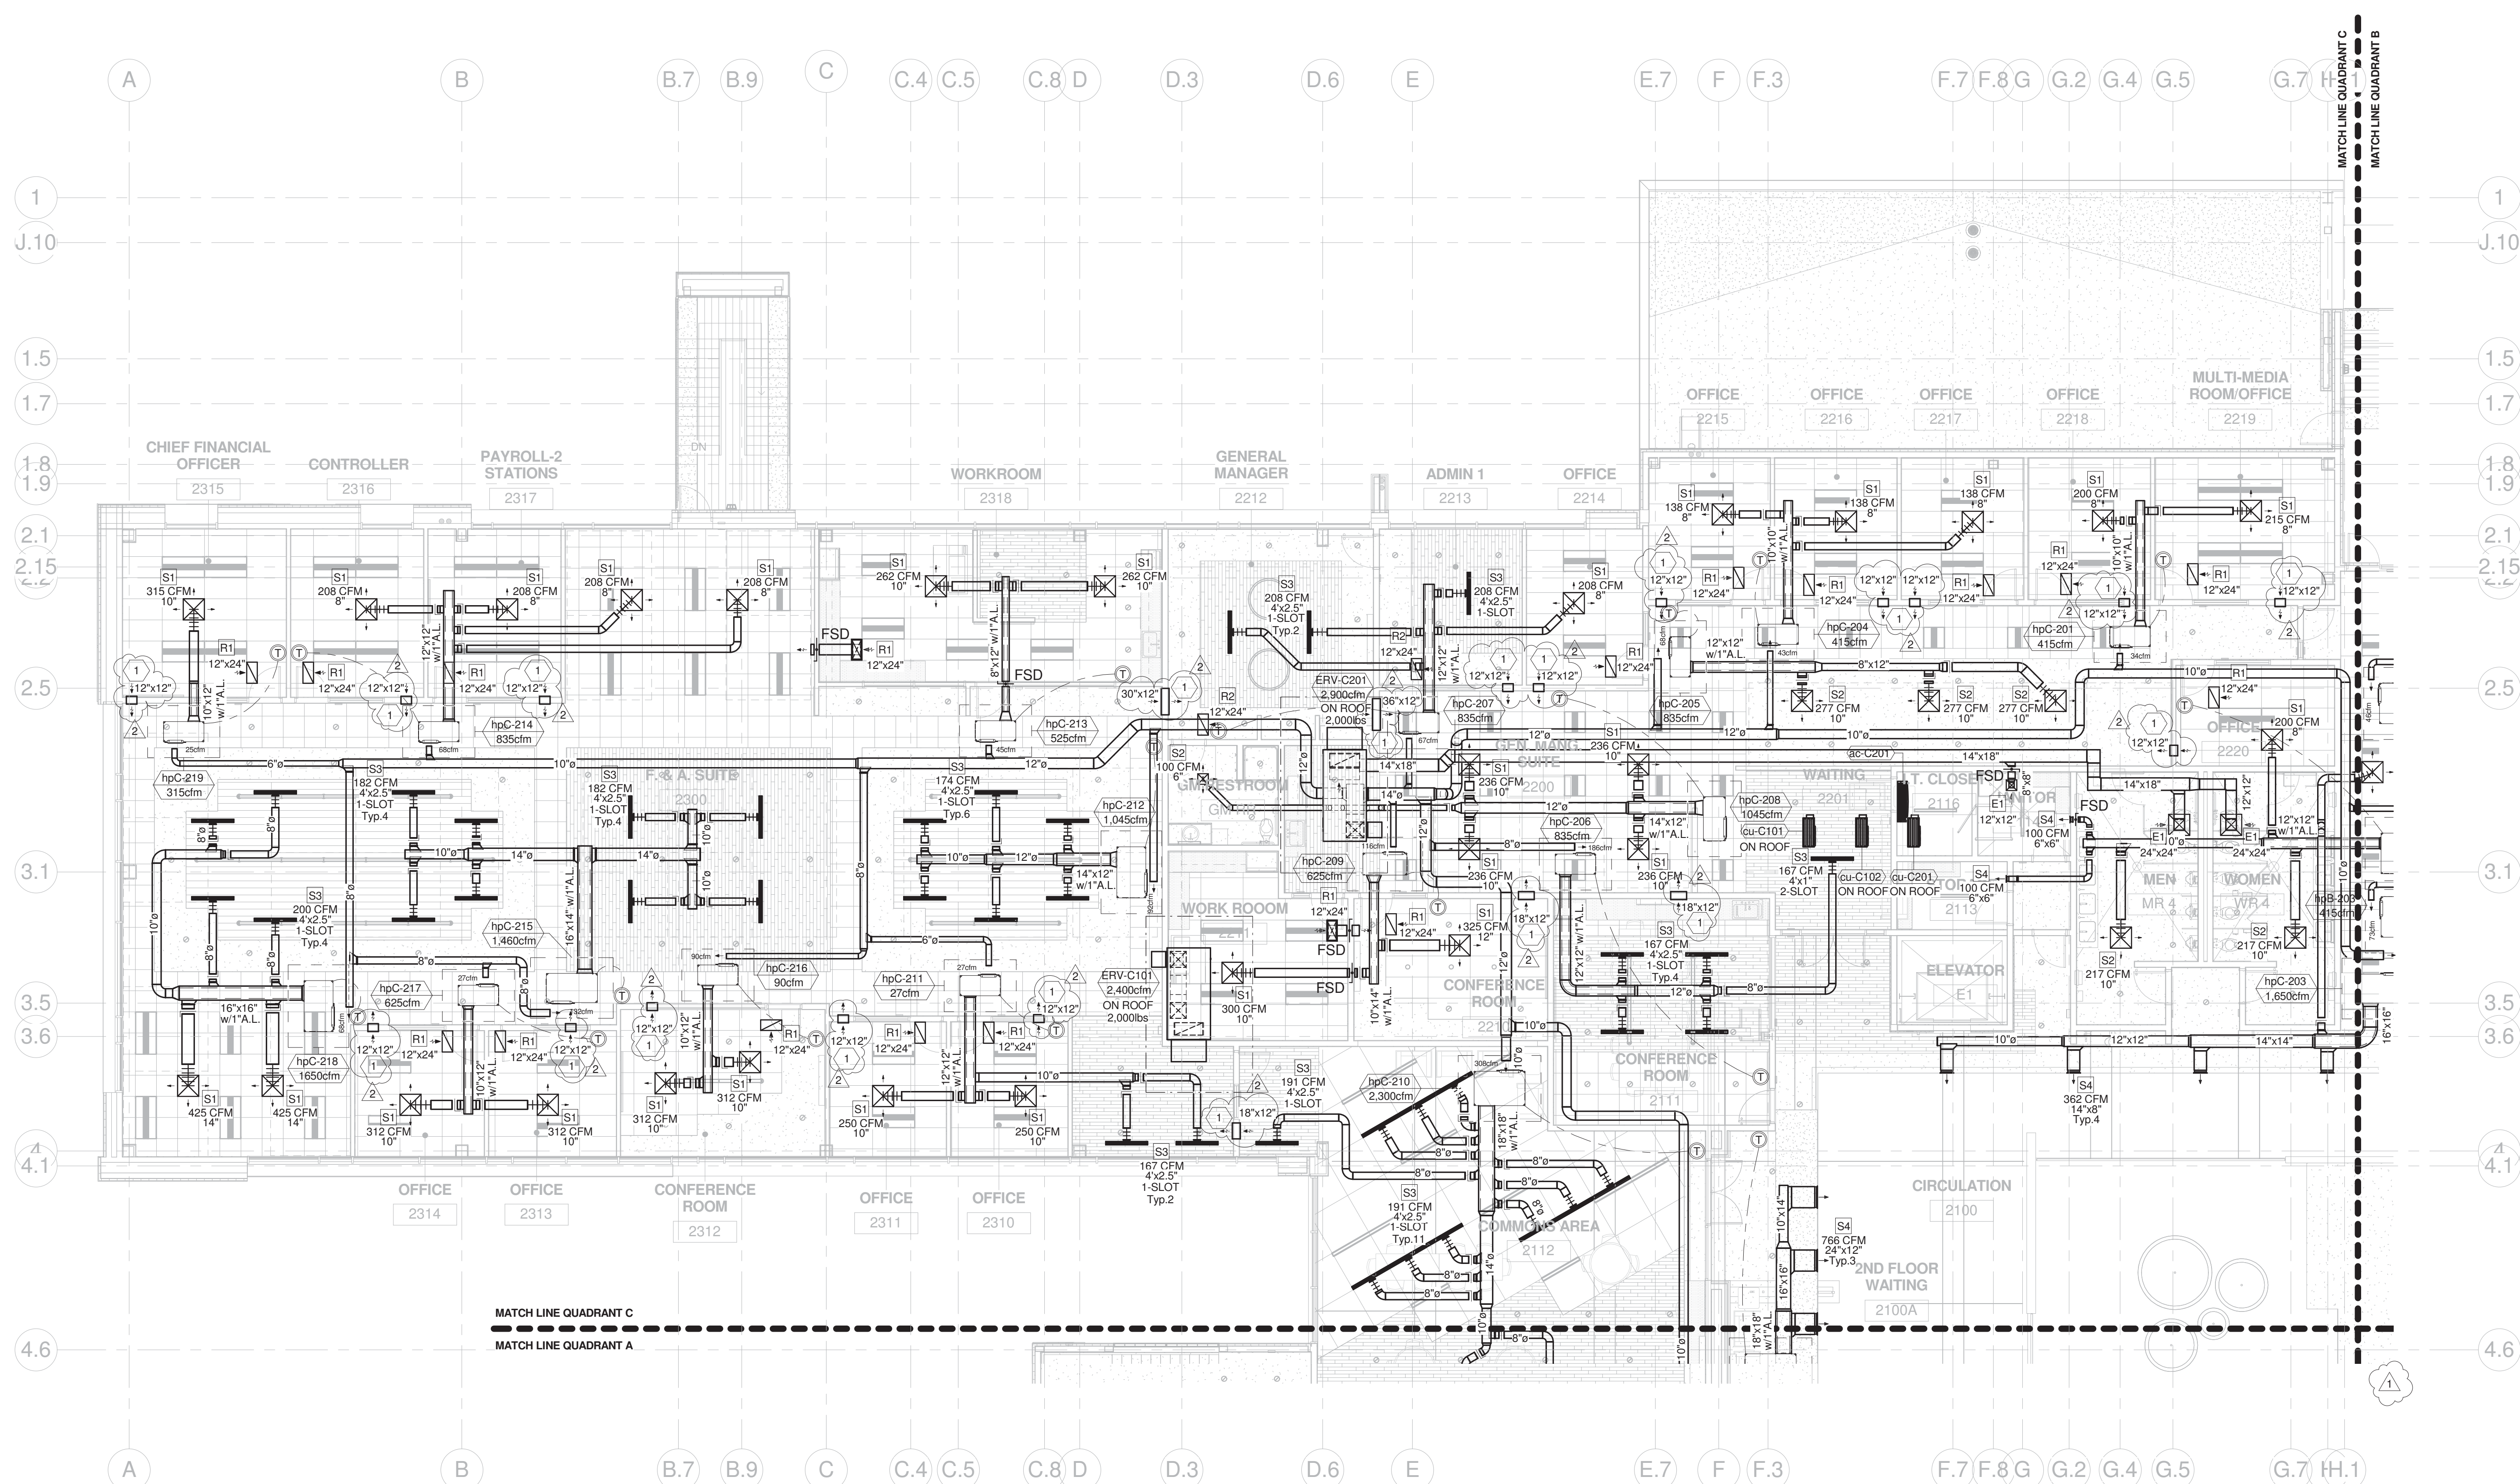

A5 MECHANICAL 2nd FLOOR HVAC PLAN - QUADRANT C
1/8" = 1'-0"



4700 Lincoln Road, NE 1 Suite 101 | Albuquerque, NM 87109 | 505.761.3100

DYRON MURPHY ARCHITECTS, P.C.



4505 Montbel Place NE, Albuquerque, New Mexico 87107

BRIAN ARNOLD
NEW MEXICO
14466
PROFESSIONAL ENGINEER
10/06/16

Revision Schedule		
Revision Number	Revision Date	Revision Description
1	10/27/16	ADD. 01
2	11/10/16	ADD.03

PROJECT NUMBER: 2015.05
DRAWN BY: DMT
PROJ MGR: BA
RVT FILE: C:\Users\dmtapia\Documents\ArSed\15-037 NTUA HQ\15-037 NTUA HQ Bldg_Local\15_dspall.rvt

Sheet Number

M102c


Sequence of

**MECHANICAL 2nd FLOOR
HVAC PLAN - QUADRANT C**



4700 Lincoln Road, NE | Suite 101 | Albuquerque, NM 87109 | 505.761.3100

DYRON MURPHY ARCHITECTS, P.C.

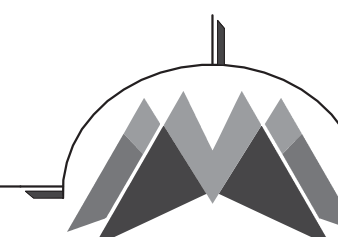

4505 Montbel Place NE, Albuquerque, New Mexico 87107



ENGINEER

Revision Schedule

Revision Number	Revision Date	Revision Description
1	11/10/16	ADD.03

PROJECT NUMBER 2015.05 DRAWN BY Author PROJ MGR Designer


RVT FILE C:\Users\ctapia\Documents\ArSed\15-037 NTUA HQ\15-037-NTUA-HQ-Bldg_Local-15_dspal1.rvt

Sheet Title

M104

Sequence of

**MECHANICAL 2nd FLOOR
HVAC PLAN - ALTERNATE
#2**

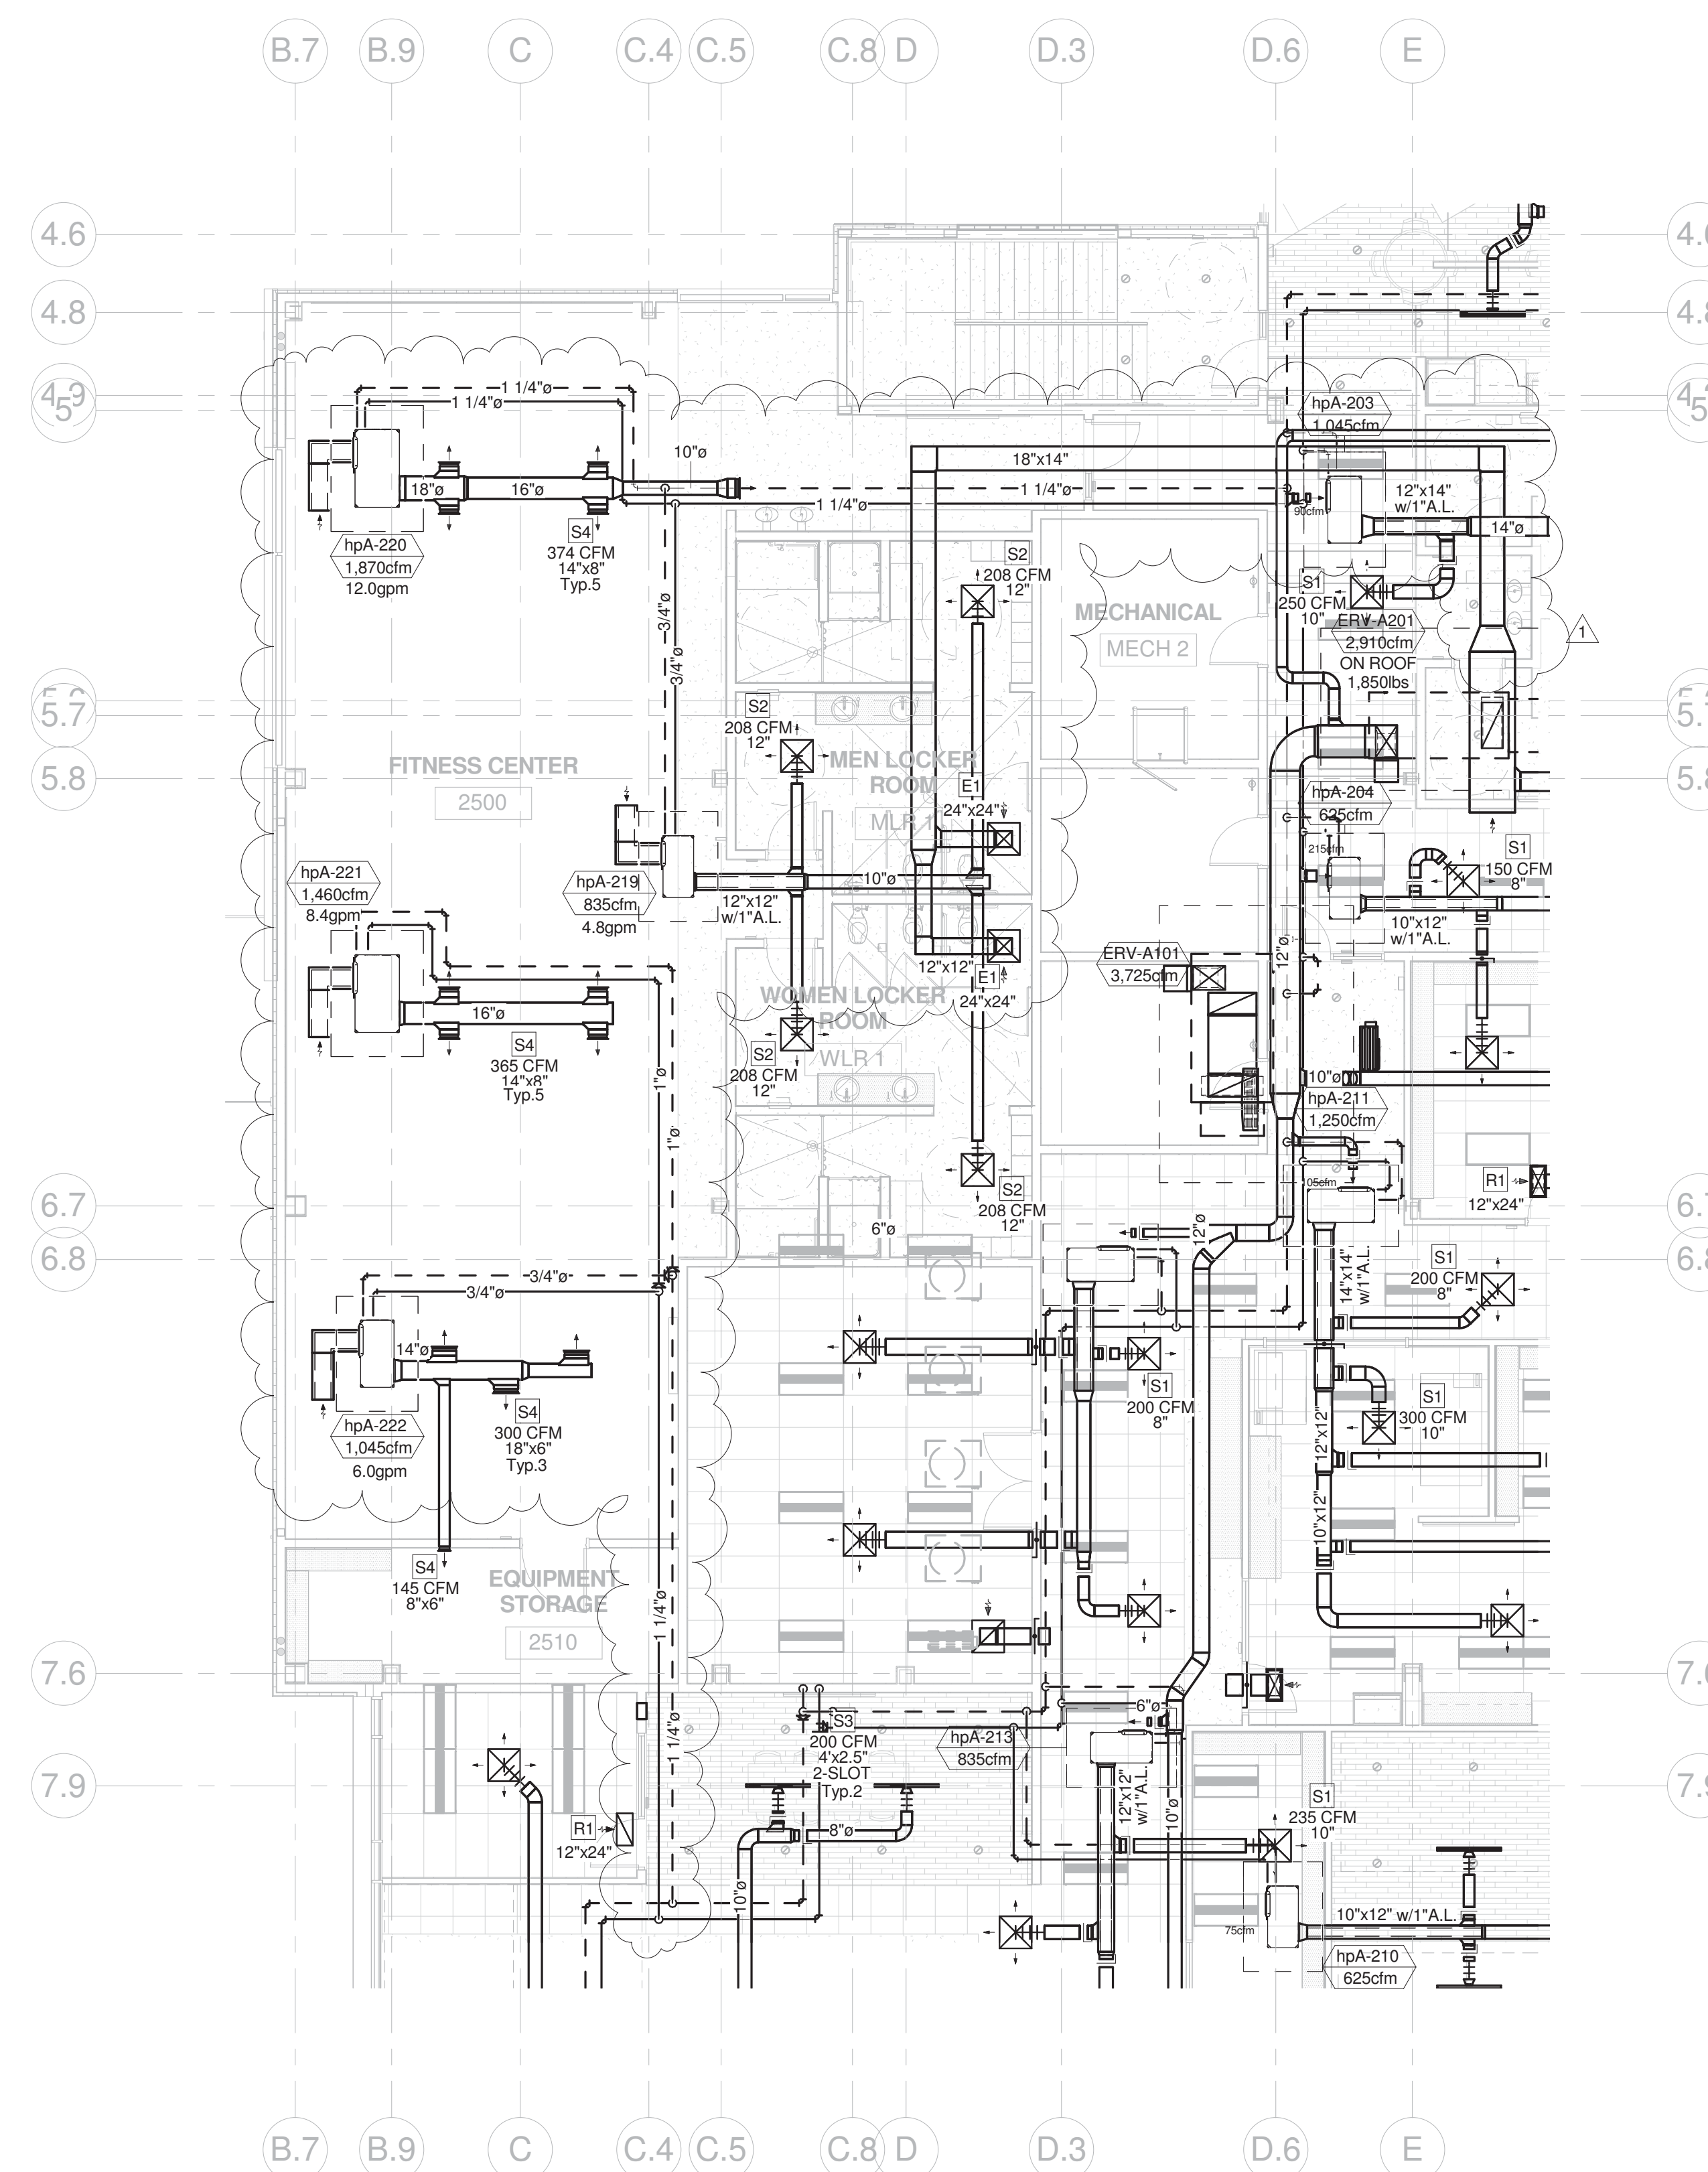


A4 MECHANICAL 2nd FLOOR HVAC PLAN - FITNESS - Alt 2
1/8" = 1'-0"


E
D
C
B
A

6 5 4 3 2 1

11/20/16 11:52 AM
C:\Users\ctapia\Documents\ArSed\15-037 NTUA HQ\15-037-NTUA-HQ-Bldg_Local-15_dspal1.rvt
DYRON MURPHY ARCHITECTS, P.C.

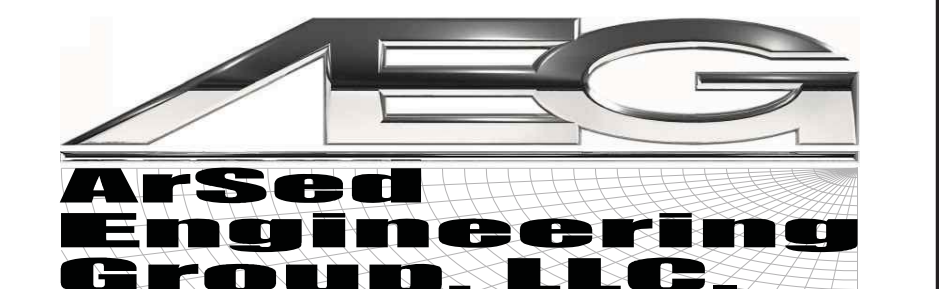

DYRON MURPHY ARCHITECTS, P.C.

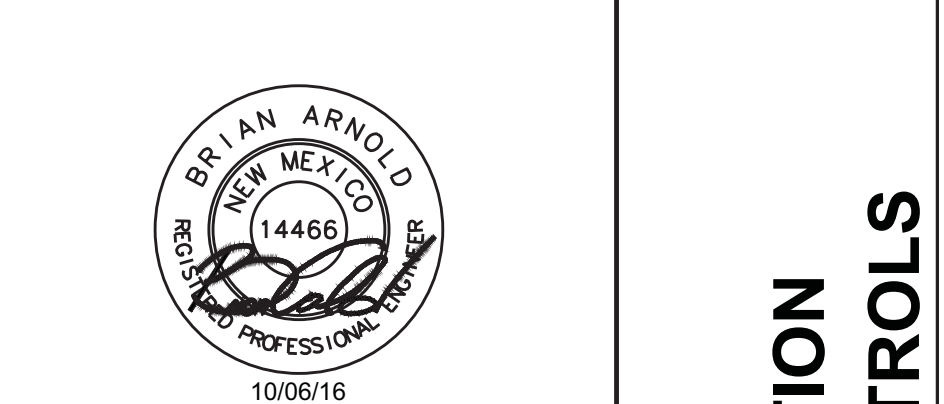

ENGINEER

Revision Schedule		
Revision Number	Revision Date	Revision Description
1	11/9/16	ADD.02
2	11/10/16	ADD.03

PROJECT NUMBER: 2015.05 | DRAWN BY: WOOD | PROJ/MGR: BA
RVT FILE

Sheet Number


M501

Sequence of


MECHANICAL:
BUILDING AUTOMATION
SYSTEM - DDC CONTROLS

SYMBOL	DESCRIPTION	SYMBOL	DESCRIPTION
BAS	NEW CONTROLS AND EQUIPMENT	SA	SUPPLY AIR
LAN	BUILDING AUTOMATION SYSTEM	RA	RETURN AIR
MBC	MODULAR BUILDING CONTROLLER	EA	EXHAUST AIR
LAN	LOCAL AREA NETWORK	OA	OUTSIDE AIR
UC	UNITARY CONTROLLER	VA	VENTILATION AIR
TEC	TERMINAL EQUIPMENT	HPR	HEAT PUMP WATER LOOP
AI	ANALOG INPUT	HRS	HEATING TOWER WATER
AO	BINARY INPUT	CTS	COOLING TOWER WATER
BO	ANALOG OUTPUT	CTR	RETURN
		VFD	VARIABLE FREQUENCY DRIVE
		VLV	VALVE
		WSPH	WATER SOURCE HEAT PUMP


M1 DDC SYMBOL LEGEND
SCALE: NONE

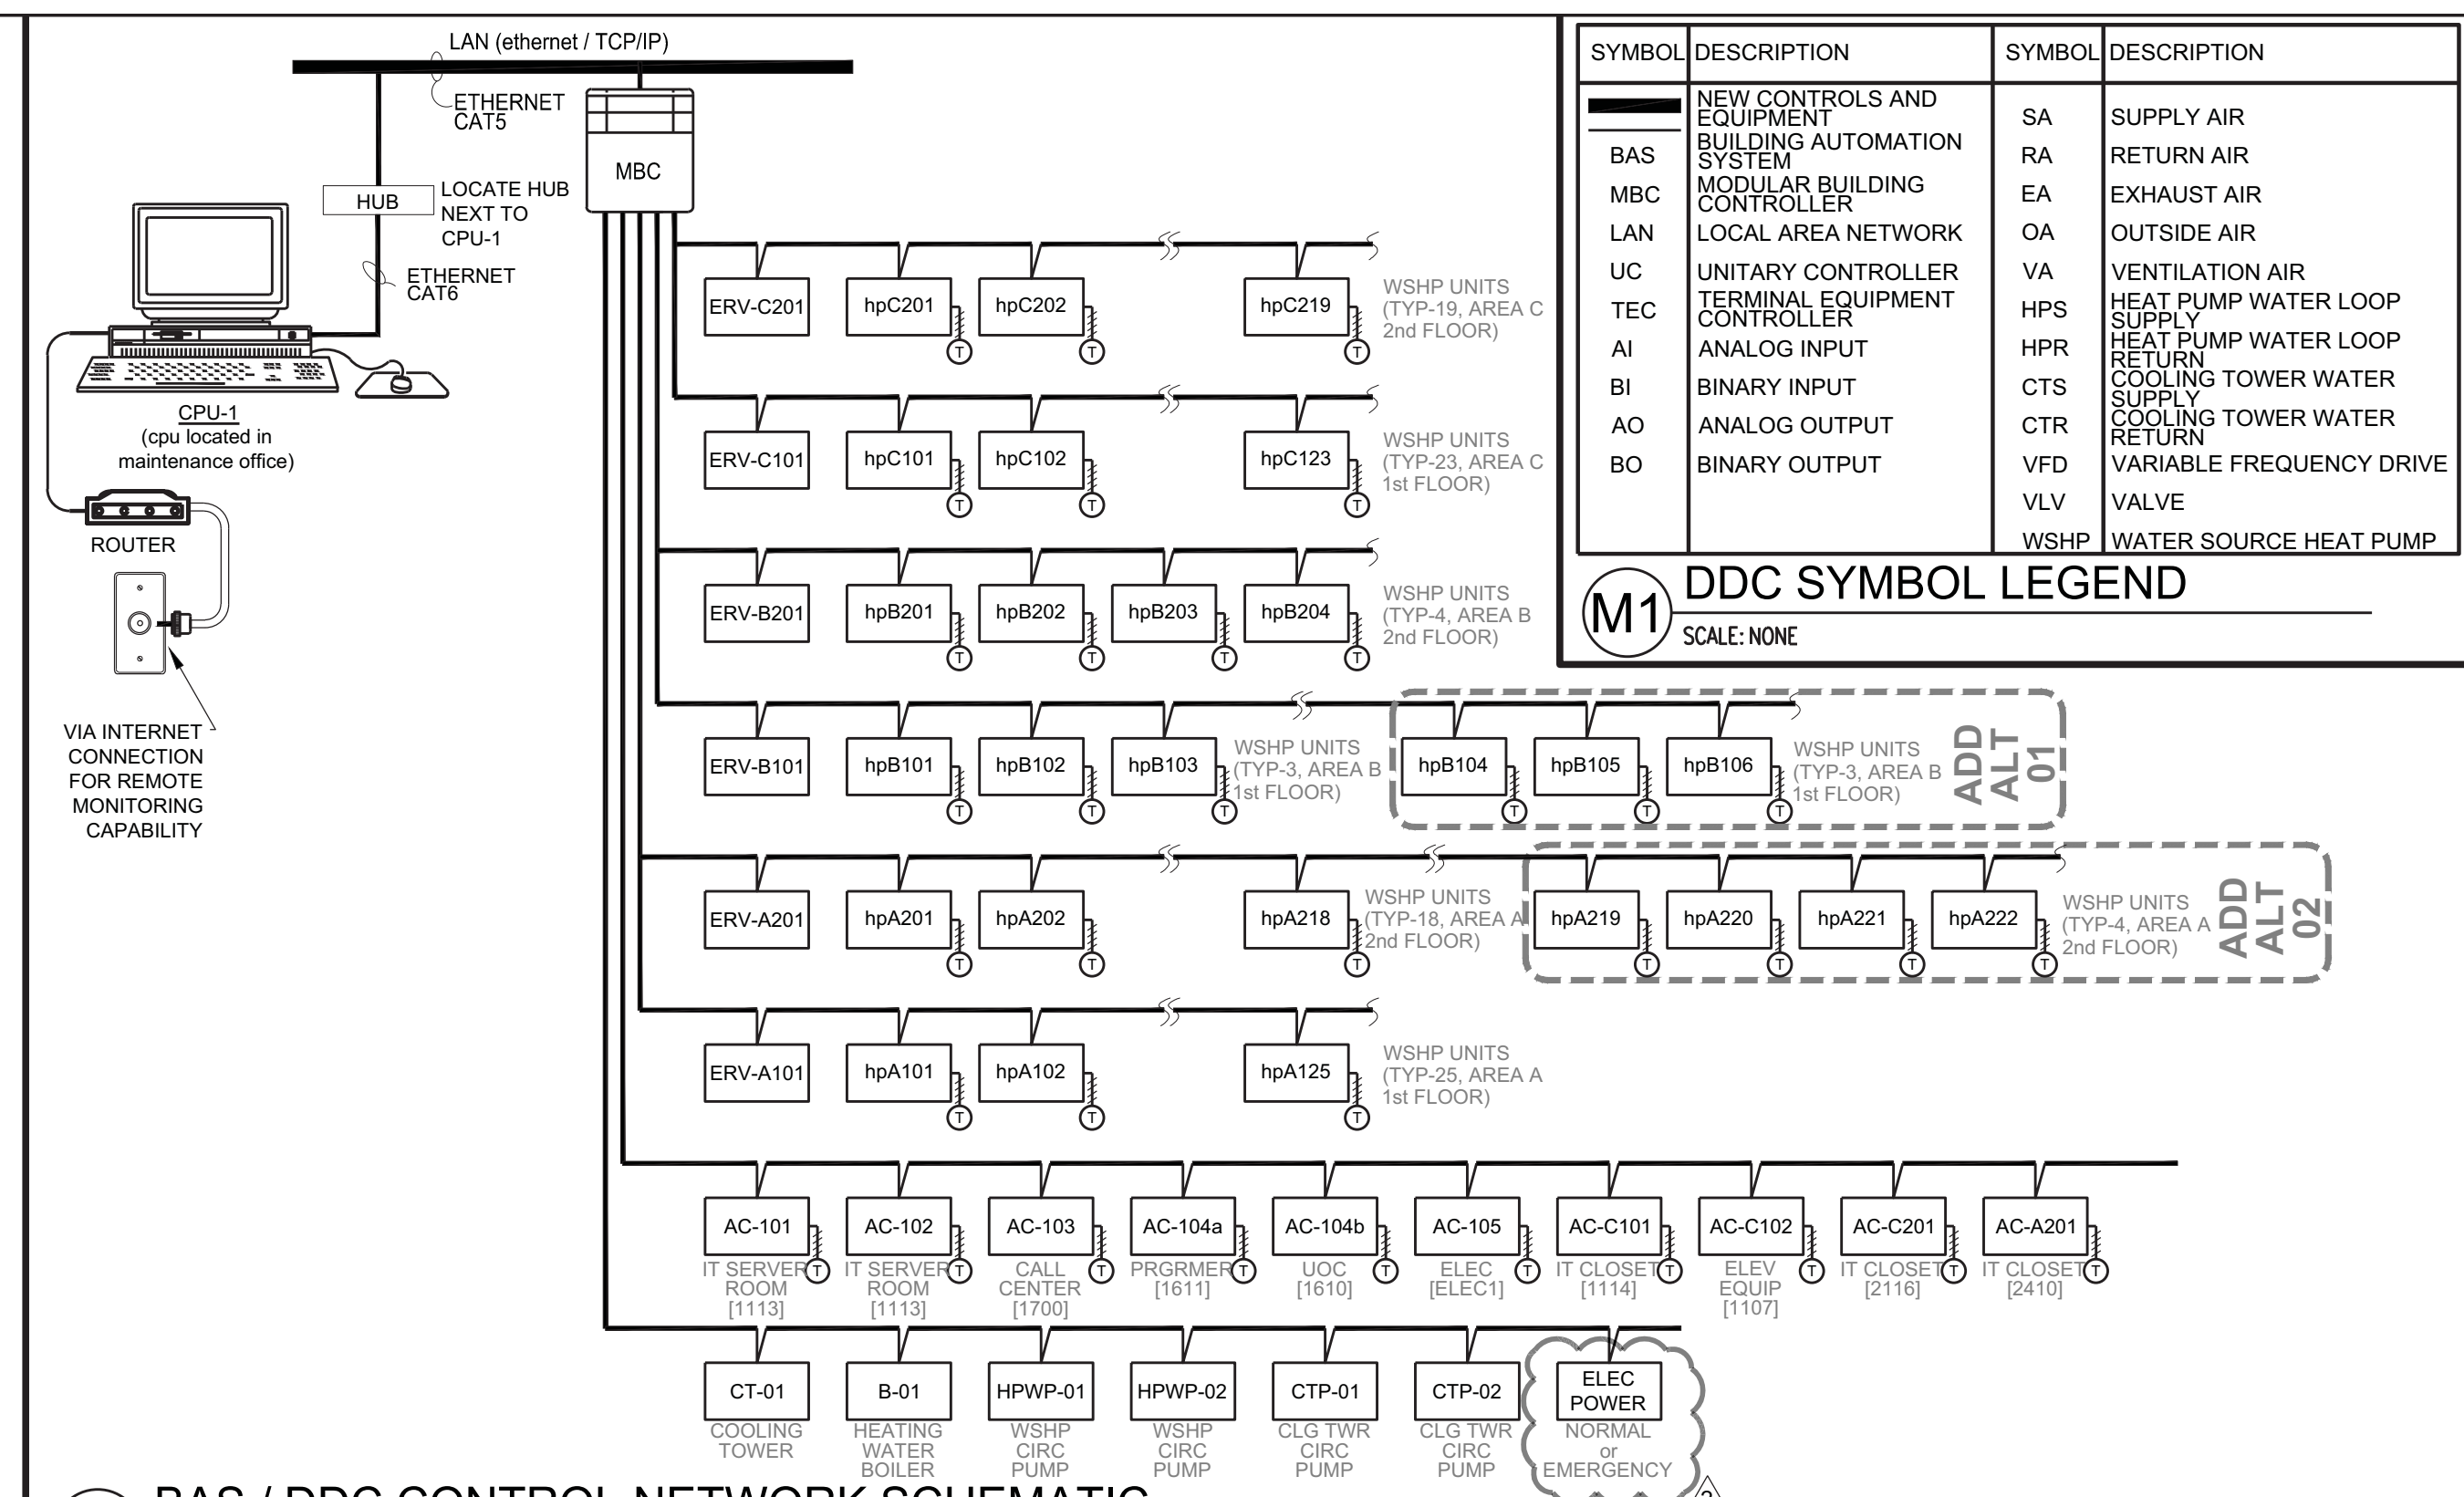

M2 BAS / DDC CONTROL NETWORK SCHEMATIC
SCALE: NONE

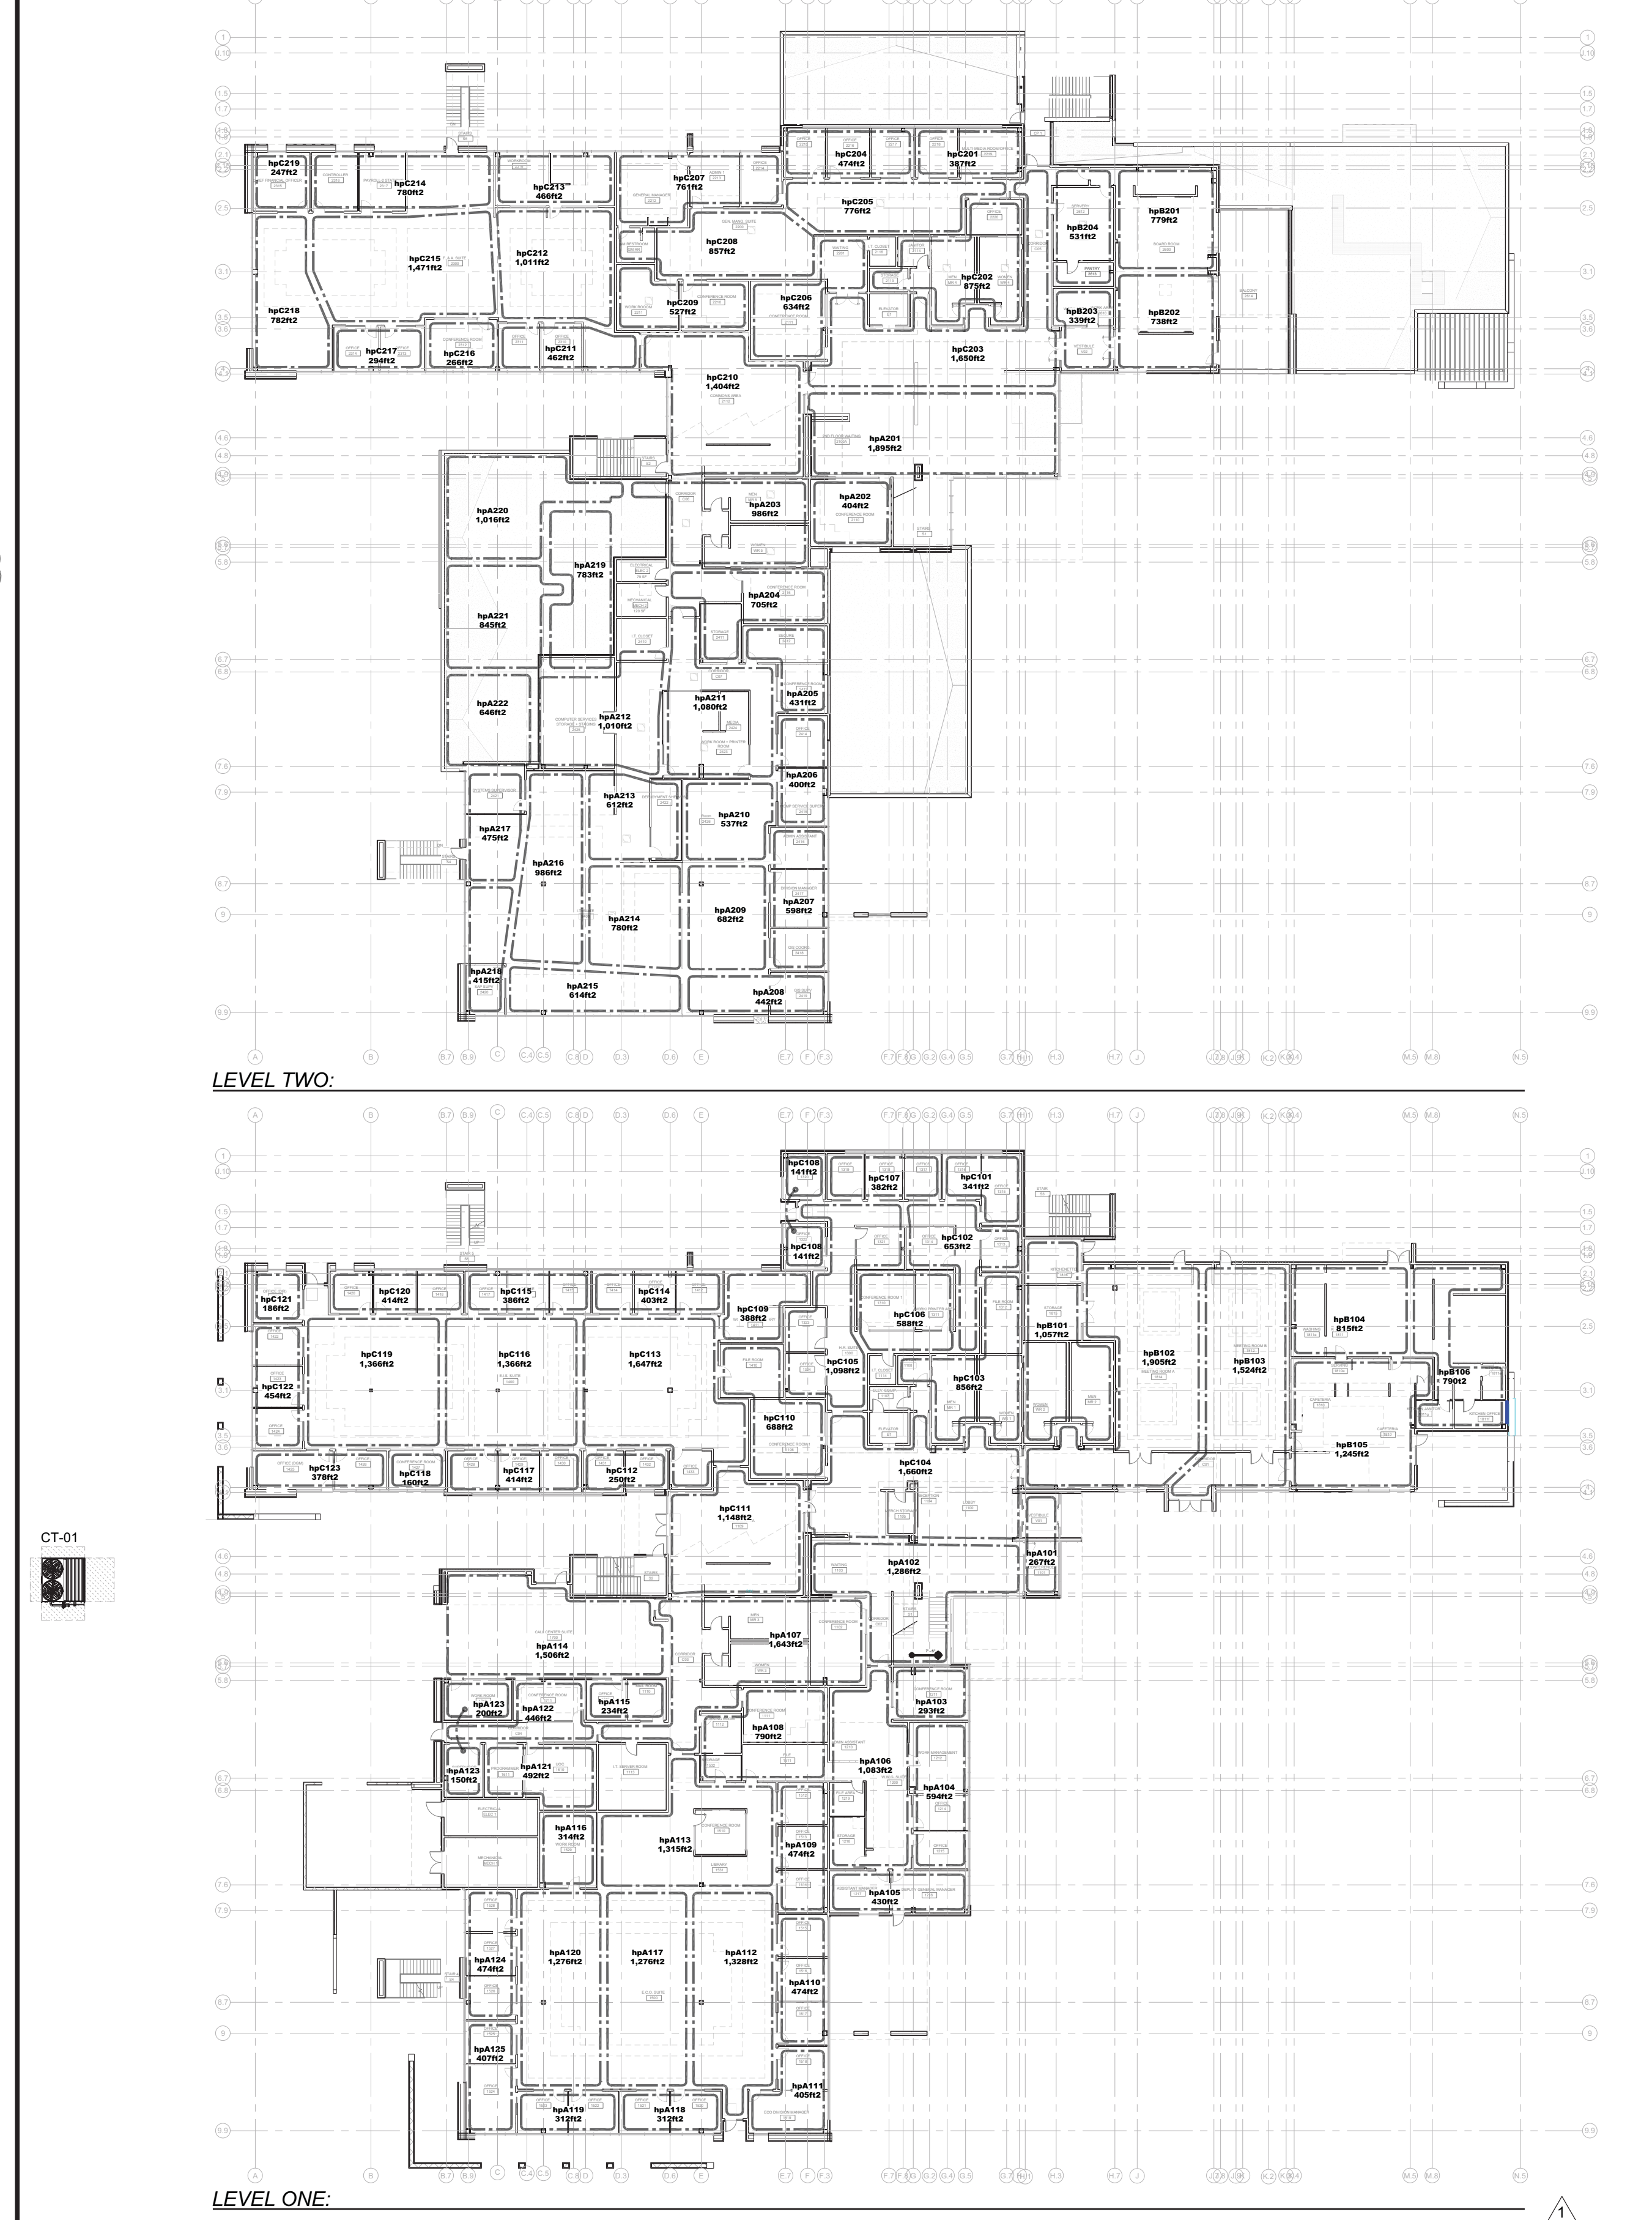

M3 BUILDING THERMAL ZONE PLAN
SCALE: NONE

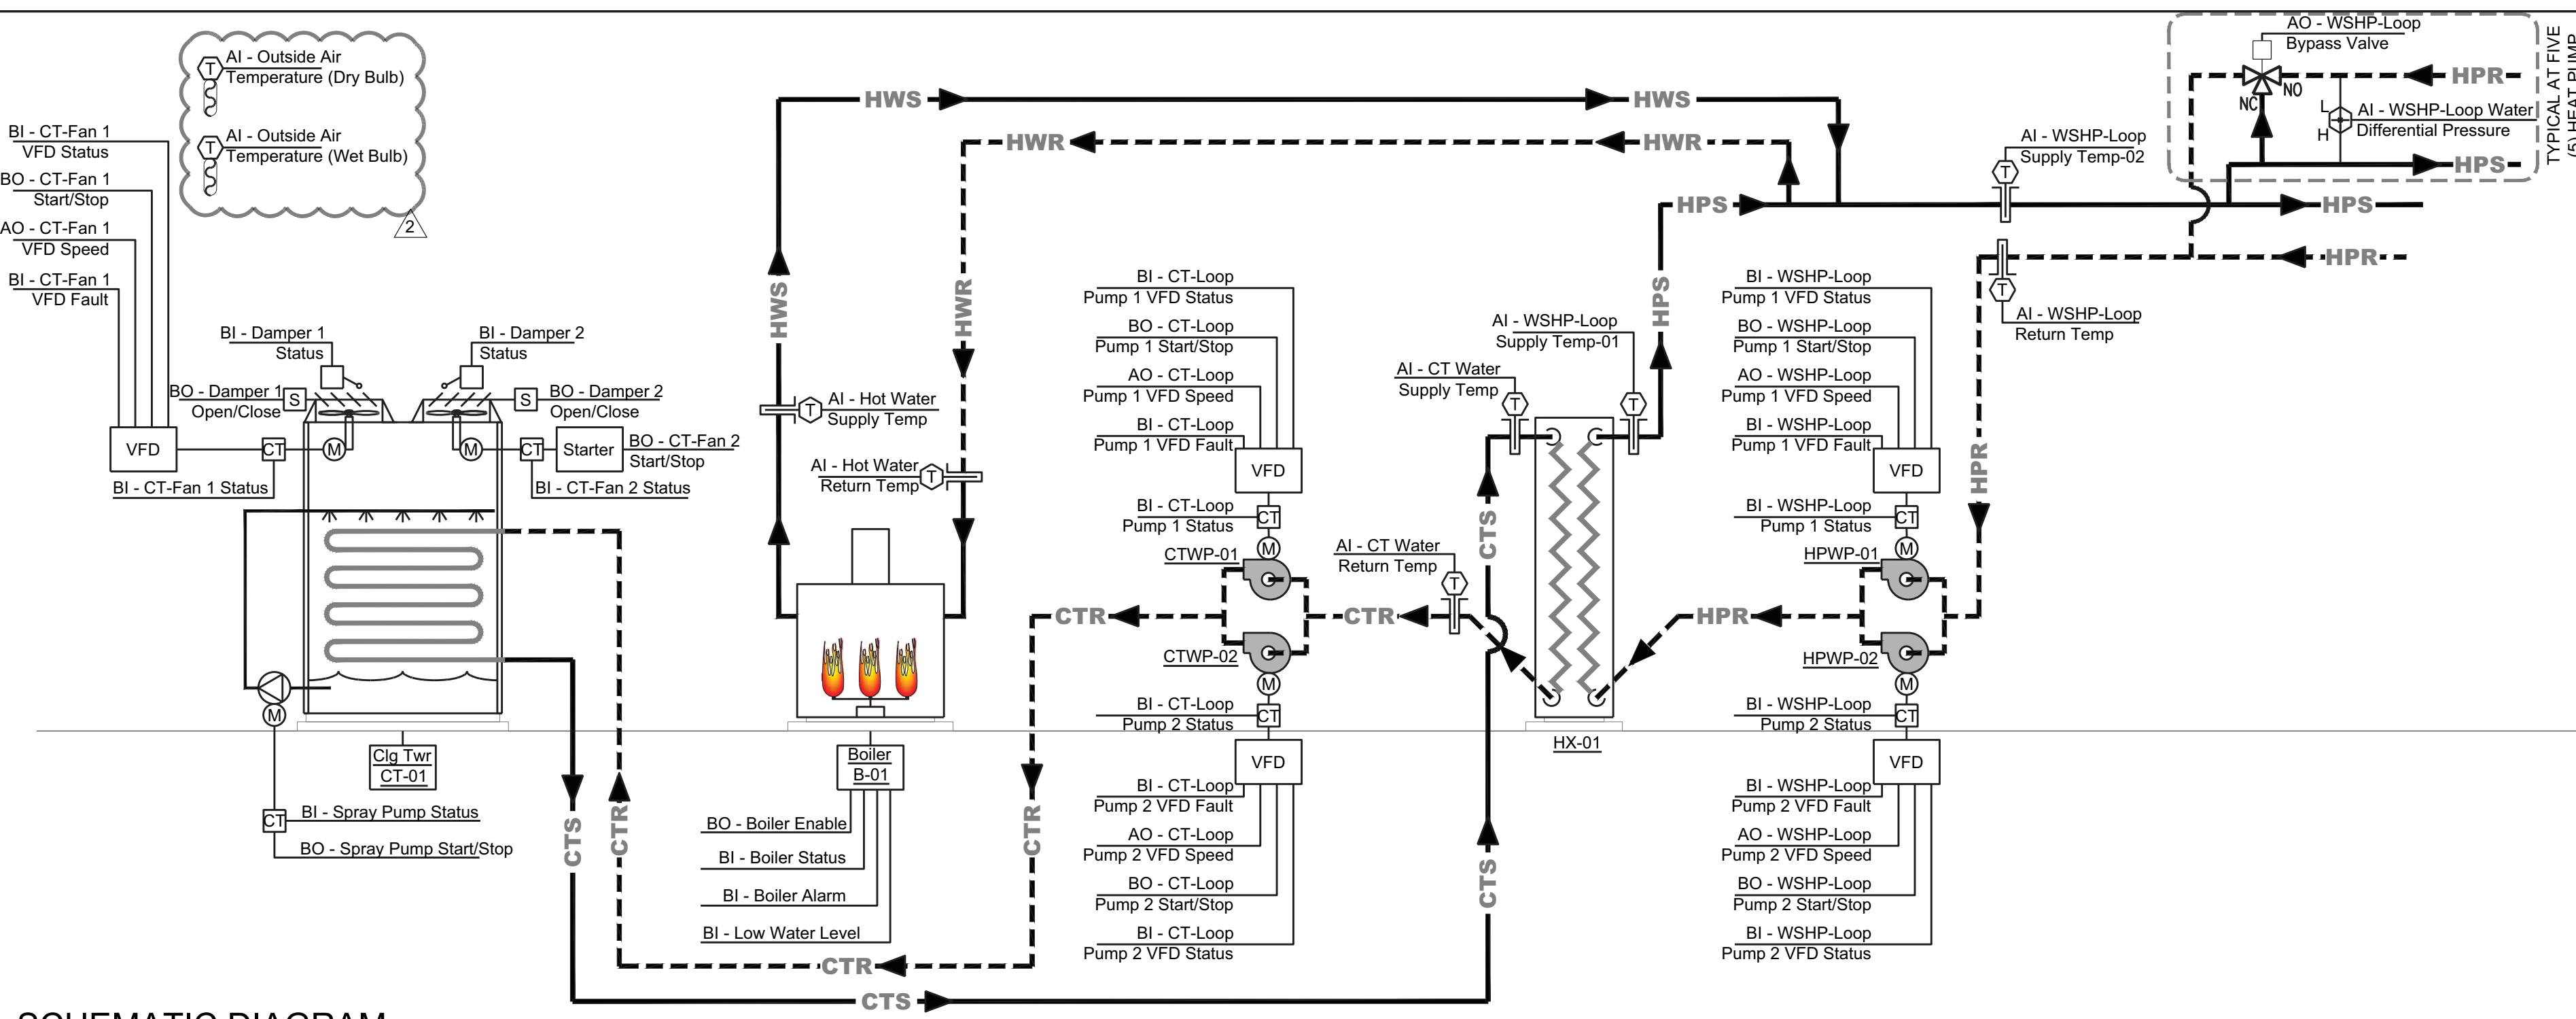

SCHEMATIC DIAGRAM:
SEQUENCE OF OPERATIONS:

WATER LOOP PIPING SYSTEMS - CONFIGURATION
A. TWO (2) CLOSED-LOOP WATER SYSTEMS SERVE THE FACILITY:
1. WATER SOURCE HEAT PUMP WATER LOOP SYSTEM (WSPH-LOOP);
a. PROVIDES COOLING OR HEATING ENERGY TO THE WSPH UNITS IN THE INTERIOR OF BUILDING.
2. HEATING ENERGY IS ADDED TO THE WSPH-LOOP USING A HIGH-EFFICIENCY, CONDENSING, HEATING WATER BOILER (B-01).
3. TWO (2) HEAT PUMP WATER PUMPS: HPWP-01 AND HPWP-02.
4. THE WSPH-LOOP IS ENTIRELY INSIDE THE BUILDING.
5. THERE ARE FIVE (5) WSPH-LOOPS INSTALLED IN THE BUILDING:
a. LEVEL 1, QUADRANT A AND C.
b. LEVEL 2, QUADRANT A AND C.
c. LEVEL 1 AND 2, QUADRANT B.
6. A DIFFERENTIAL PRESSURE SENSOR (DP) IS INSTALLED IN EACH OF THE FIVE (5) WSPH-LOOP SYSTEMS. (DIFFERENTIAL PRESSURE IS THE WATER PRESSURE DIFFERENCE BETWEEN WSPH-LOOP SUPPLY AND RETURN PIPING).
7. WHEN EACH WSPH UNIT COMPRESSOR IS ON, THE WATER VALVE AT WSPH UNIT IS OPEN (WSPH-LOOP WATER FLOWS THRU WSPH UNIT).
8. WHEN EACH WSPH UNIT COMPRESSOR IS OFF, THE WATER VALVE AT WSPH UNIT IS CLOSED. (WSPH-LOOP WATER DOES NOT FLOW THRU WSPH UNIT).
9. IN EACH INDIVIDUAL WSPH-LOOP: WHEN ALL OF THE WSPH UNIT COMPRESSORS ARE ON, THE DP SENSOR WILL BE AT LOWEST PRESSURE DIFFERENTIAL. (DP SETTING IS DETERMINED DURING TEST & BALANCE OF WATER SYSTEM).
10. AS THE INDIVIDUAL WSPH UNITS COMPRESSORS TURN OFF, THE WSPH WATER VALVES WILL CLOSE, AND DP WILL INCREASE.
11. AS THE INDIVIDUAL WSPH UNITS COMPRESSORS TURN ON, THE WSPH WATER VALVES WILL OPEN, AND DP WILL DECREASE.
12. A BY-PASS VALVE IS INSTALLED IN EACH OF THE FIVE (5) WSPH-LOOP SYSTEMS.
13. THE BY-PASS VALVE IS INSTALLED ADJACENT TO THE DP SENSOR.
14. THE BY-PASS VALVE IS A MODULATING, 3-WAY VALVE.
15. THE BY-PASS VALVE WILL OPEN / CLOSE POSITION, IN RESPONSE TO DP SENSOR READING.
2. COOLING TOWER WATER LOOP SYSTEM (CT-LOOP).
a. PROVIDES COOLING ENERGY TO THE WSPH-LOOP SYSTEM.
b. COOLING ENERGY IS ADDED TO THE CT-LOOP USING A CLOSED-CIRCUIT COOLING TOWER (CT-01).
c. TWO (2) COOLING TOWER WATER PUMPS: CTP-01 AND CTP-02.
d. THE MAJORITY OF THE CT-LOOP IS OUTSIDE THE BUILDING - THE ONLY PORTION OF CT-LOOP INSIDE THE BUILDING IS IN THE MAIN MECHANICAL ROOM.
B. THE TWO (2) CLOSED-LOOP WATER SYSTEMS ARE SEPARATED USING A PLATE-AND-FRAME HEAT EXCHANGER (HX-01).
1. THE CT-LOOP SIDE OF THE HEAT EXCHANGER HAS A 40% PROPYLENE GLYCOL SOLUTION TO MINIMIZE POTENTIAL FOR FREEZING THE CT-LOOP WATER -
a. PROVIDES FREEZE PROTECTION DOWN TO 3°F.
2. THE WSPH-LOOP SIDE OF THE HEAT EXCHANGER HAS 0% PROPYLENE GLYCOL (NO GLYCOL INSIDE OF BUILDING).
WATER SOURCE HEAT PUMP WATER LOOP SYSTEM (WSPH-LOOP) - RUN CONDITIONS - SCHEDULED:
A. THE WATER SOURCE HEAT PUMP WATER SYSTEM (WSPH-LOOP) SHALL BE ENABLED TO RUN WHENEVER:
1. THE WSPH UNITS ARE IN THE OCCUPIED MODE, OR
2. A DEFINABLE NUMBER OF WSPH UNITS ARE IN THE OCCUPANT-OVERRIDE MODE.
B. THE WSPH-LOOP SHALL RUN IN ONE OF THREE OPERATING MODES:
1. HEATING-DOMINANT MODE
2. COOLING-DOMINANT MODE
3. COOLING-ECONOMIZER MODE
C. THE BAS CONTROLLER SHALL MONITOR ALL OF THE WSPH UNITS, AND DETERMINE IF EACH INDIVIDUAL WSPH UNIT IS IN COOLING OR HEATING MODE.
1. IF 50% OR MORE (USER ADJ.) OF THE WSPH UNITS IS IN HEATING MODE, THE WSPH-LOOP WILL BE IN HEATING-DOMINANT MODE.
2. IF 50% OR MORE (USER ADJ.) OF THE WSPH UNITS IS IN COOLING MODE, THE WSPH-LOOP WILL BE IN COOLING-DOMINANT MODE.
3. IF THE WSPH-LOOP IS IN COOLING-DOMINANT MODE, AND THE OUTSIDE AMBIENT AIR CONDITIONS ARE SUCH THAT ECONOMIZER OPERATION IS AVAILABLE, THE WSPH-LOOP WILL BE IN THE COOLING-ECONOMIZER MODE.
D. WHEN THE BAS CONTROLLER COMMANDS THE WSPH-LOOP TO BE ON:
1. THE TWO (2) HPWP-xxx PUMPS SHALL OPERATE IN A LEAD/LAG FASHION.
a. THE LEAD PUMP SHALL RUN FIRST.
b. ON FAILURE OF THE LEAD PUMP, THE LAG PUMP SHALL RUN AND THE LEAD PUMP SHALL TURN OFF.
c. ON DECREASING WSPH-LOOP WATER DIFFERENTIAL PRESSURE, THE LAG PUMP SHALL STAGE ON AND RUN IN UNISON WITH THE LEAD PUMP TO MAINTAIN WSPH-LOOP WATER DIFFERENTIAL PRESSURE SETPOINT.
2. THE DESIGNATED LEAD PUMP SHALL ROTATE UPON ONE OF THE FOLLOWING CONDITIONS (USER SELECTABLE).
a. MANUALLY THROUGH A SOFTWARE SWITCH
b. IF PUMP RUNTIME (ADJ.) IS EXCEEDED
c. DAILY
d. WEEKLY
e. MONTHLY
3. ALARMS SHALL BE PROVIDED AS FOLLOWS:
a. HPWP-xx WATER PUMPS
- FAILURE: COMMANDED ON, BUT THE STATUS IS OFF.
- RUNNING IN HAND: COMMANDED OFF, BUT THE STATUS IS ON.
- RUNTIME EXCEEDED: STATUS RUNTIME EXCEEDS A USER DEFINABLE LIMIT.
b. VFD FAILURE.
4. THE FOLLOWING SETPOINTS ARE RECOMMENDED VALUES.
5. ALL SETPOINTS SHALL BE FIELD ADJUSTED DURING THE COMMISSIONING PERIOD TO MEET THE REQUIREMENTS OF ACTUAL FIELD CONDITIONS.
6. ON RISING CT-LOOP WATER SUPPLY TEMPERATURE, THE DAMPER, SPRAY PUMP AND FAN SHALL STAGE ON AT THE SETPOINTS GIVEN BELOW.
7. WHEN THE CT-LOOP WATER SUPPLY TEMPERATURE DROPS BACK BELOW THE SETPOINTS BY THE DIFFERENTIALS LISTED, THE FAN, PUMP AND DAMPER SHALL STAGE OFF.
8. TO PREVENT SHORT CYCLING AND BACK-EMF IN THE FAN MOTORS, THERE SHALL BE A MINIMUM DELAY (ADJ.) BETWEEN EACH STAGE.
9. WHEN OUTSIDE AIR TEMPERATURE IS BELOW 40°F (ADJ.), SPRAY PUMPS AND FANS SHALL BE DISABLED.
TOWER DAMPER SPRAY PUMP FAN
STAGE ON IF CT-LOOP TEMP RISES ABOVE SETPOINT OF: 80°F 83°F 88°F
STAGE OFF IF CT-LOOP TEMP DROPS BELOW SETPOINT BY: 4°F 5°F 5°F
C. ALARMS SHALL BE PROVIDED AS FOLLOWS:
1. DAMPER
- FAILURE: COMMANDED OPEN, BUT THE STATUS INDICATES CLOSED.
- OPEN IN HAND: COMMANDED CLOSED, BUT THE STATUS INDICATES OPEN.
- RUNTIME EXCEEDED: STATUS RUNTIME EXCEEDS A USER DEFINABLE LIMIT.
2. SPRAY PUMP
- FAILURE: COMMANDED ON, BUT THE STATUS IS OFF.
- RUNNING IN HAND: COMMANDED OFF, BUT THE STATUS IS ON.
- RUNTIME EXCEEDED: STATUS RUNTIME EXCEEDS A USER DEFINABLE LIMIT.
3. FAN
- FAILURE: COMMANDED ON, BUT THE STATUS IS OFF.
- IN HAND: COMMANDED OFF, BUT THE STATUS IS ON.
- RUNTIME EXCEEDED: STATUS RUNTIME EXCEEDS A USER DEFINABLE LIMIT.
4. HIGH CONDENSER WATER SUPPLY TEMP: IF THE CONDENSER WATER SUPPLY TEMPERATURE IS GREATER THAN 90°F (ADJ.).
BOILER SYSTEM: RUN CONDITIONS - COMMANDED
A. THE BOILER SYSTEM SHALL BE ENABLED TO RUN WHENEVER:
1. THE WSPH-LOOP IS IN THE HEATING-DOMINANT MODE, AND
2. OUTSIDE AIR TEMPERATURE IS LESS THAN 60°F (USER ADJ.).
B. TO PREVENT SHORT CYCLING, THE BOILER SYSTEM SHALL RUN FOR, AND BE OFF FOR MINIMUM ADJUSTABLE TIMES (BOTH USER DEFINABLE), UNLESS SHUTDOWN ON SAFETIES OR OUTSIDE AIR CONDITIONS.
C. BOILER ALARMS:
1. THE BAS CONTROLLER SHALL MONITOR THE WSPH-LOOP TEMPERATURE.
a. BOILER SHALL BE COMMANDED ON WHEN THE WSPH-LOOP SYSTEM REQUIRES HEATING TO BE ADDED.
b. THE BOILER SYSTEM SHALL ALSO BE AVAILABLE TO RUN FOR FREEZE PROTECTION WHENEVER OUTSIDE AIR TEMPERATURE IS LESS THAN 38°F (ADJ.).
2. THE BOILER SHALL RUN SUBJECT TO ITS OWN INTERNAL SAFETIES AND CONTROLS.
D. BOILER SAFETIES:
1. THE FOLLOWING SAFETIES SHALL BE MONITORED:
a. BOILER ALARM.
b. LOW WATER LEVEL.
c. LOW WATER LEVEL.
E. ALARMS SHALL BE PROVIDED AS FOLLOWS:
1. BOILER ALARM.
2. LOW WATER LEVEL ALARM.
3. BOILER FAILURE: COMMANDED ON, BUT THE STATUS IS OFF.
4. BOILER RUNNING IN HAND: COMMANDED OFF, BUT THE STATUS IS ON.
5. BOILER RUNTIME EXCEEDED: STATUS RUNTIME EXCEEDS A USER DEFINABLE LIMIT.
WSPH-LOOP DIFFERENTIAL PRESSURE CONTROL
A. THE BAS CONTROLLER SHALL MEASURE WSPH-LOOP WATER DIFFERENTIAL PRESSURE AND MODULATE THE WSPH-LOOP WATER PUMP VFDS IN SEQUENCE TO MAINTAIN THE DIFFERENTIAL PRESSURE SETPOINT.
1. THE FOLLOWING SETPOINTS ARE RECOMMENDED VALUES. ALL SETPOINTS SHALL BE FIELD ADJUSTED DURING THE COMMISSIONING PERIOD TO MEET THE REQUIREMENTS OF ACTUAL FIELD CONDITIONS.
B. THE BAS CONTROLLER SHALL MODULATE WSPH-LOOP PUMP SPEEDS TO MAINTAIN A WATER DIFFERENTIAL PRESSURE OF 12LBF/IN² (ADJ.).
1. THE VFDS MINIMUM SPEED SHALL NOT DROP BELOW 20% (ADJ.).
C. ON DROPPING HOT WATER DIFFERENTIAL PRESSURE, THE VFDS SHALL STAGE ON AND RUN TO MAINTAIN SETPOINT AS FOLLOWS:
1. THE CONTROLLER SHALL MODULATE THE LEAD VFD TO MAINTAIN SETPOINT.
2. IF THE LEAD VFD SPEED IS GREATER THAN A SETPOINT OF 90% (ADJ.), THE LAG VFD SHALL STAGE ON.
3. THE LAG VFD SHALL RAMP UP TO MATCH THE LEAD VFD SPEED AND THEN RUN IN UNISON WITH THE LEAD VFD TO MAINTAIN SETPOINT.
D. ON RISING WSPH-LOOP DIFFERENTIAL PRESSURE, THE VFDS SHALL STAGE OFF AS FOLLOWS:
1. IF THE VFDS SPEEDS DROPS BACK TO 60% (ADJ.) BELOW SETPOINT, THE LAG VFD SHALL STAGE OFF.
2. THE LEAD VFD SHALL CONTINUE TO RUN TO MAINTAIN SETPOINT.
E. ALARMS SHALL BE PROVIDED AS FOLLOWS:
1. HIGH WSPH-LOOP DIFFERENTIAL PRESSURE: IF 25% (ADJ.) GREATER THAN SETPOINT.
2. LOW WSPH-LOOP DIFFERENTIAL PRESSURE: IF 25% (ADJ.) LESS THAN SETPOINT.
BYPASS VALVE
A. THE BYPASS VALVE SHALL NORMALLY BE CLOSED.
B. THE BYPASS VALVE SHALL BE ENABLED WHENEVER THE WSPH-LOOP SYSTEM IS CALLED TO RUN.
1. THE CONTROLLER SHALL MEASURE THE OUTSIDE AIR TEMPERATURE.
a. IF THE OUTSIDE AIR TEMPERATURE IS 37°F OR BELOW (ADJ.), AND ALL OF THE HEAT PUMPS ARE NOT OPERATING, THE BYPASS VALVE WILL OPEN TO THE 100% OPEN POSITION, AND ONE OF THE VFDS WILL RAMP DOWN TO THE 20% SPEED POSITION.
b. IF EITHER VFD-1 AND/OR VFD-2 IS SENSORED TO BE IN THE HAND POSITION AND HIGH WSPH-LOOP DIFFERENTIAL PRESSURE HAS REACHED, (OR EXCEEDS), SETPOINT, THE BYPASS VALVE WILL MODULATE OPEN TO MAINTAIN SETPOINT.

M4 WATER LOOP PIPING SYSTEMS: COOLING AND HEATING CONTROLS
SCALE: NONE

DOMESTIC WATER HEATER

SYMBOL	MANUFACTURER (OR EQUAL)	MODEL	TANK CAPACITY GALLONS	1ST HOUR DELIVERY	INPUT BTUH	CW INLET	HW OUTLET	FLUE/INTAKE DIAMETER	ELECTRICAL		GAS CONN	T&P RELIEF
									VOLTS	PHASE		
WH-1 WH-2	A.O. SMITH	BTH-100	75	166 GALLONS	100,000	1"	1"	4 1/4"	120	1	3/4"	3/4"
WH-3	A.O. SMITH FOR BID ALTERNATE 1	BTH-150	100	297 GALLONS	150,000	1-1/2"	1-1/2"	4 1/4"	120	1	1"	1"
COMMENTS												
FURNISH COMPLETE PACKAGED WATER HEATER AND ASME STORAGE TANK WITH ALL CONTROLS, ASME RELIEF VALVE, HEAT EXCHANGER, TANK THERMOMETER, GLASS-LINED STEEL TANK CONSTRUCTION, INLET AND OUTLET THERMOMETERS, & PRE-PIPED WITH FITTINGS. COMPLETE ASSEMBLY SHALL FACTORY ASSEMBLED. HEATERS SHALL BE SET FOR OPERATION AT SITE ELEVATION, AGA RATED, LOW WATER CUTOFF, STANDARD EQUIPMENT, STANDARD CONTROLS-120V, 90% EFFICIENCY RATING, 5 YEAR WARRANTY. BLOWER: 2.2 AMPS, IGNITER: 4.0 AMPS CONTRACTOR TO PROVIDE HEAT TRAPS AND SEISMIC RESTRAINT STRAPS.												

EXPANSION TANK SCHEDULE

SYMBOL	MANUFACTURER (OR EQUAL)	MODEL	DIMENSIONS (IN)		TANK VOLUME (GAL)	MOUNTING	TYPE	OPER. PRESS. (PSIG)		OPER. TEMP. (°F)		COMMENTS
			DIA.	HEIGHT				MIN.	MAX.	MIN.	MAX.	
EXP-1	AMTROL	ST-20V-C	12"	19-1/2"	8.0	VERTICAL	BLADDER	-	125	-	180	CONSTRUCTED PER ASME SECTION VII, DIV.1
EXP-2	AMTROL FOR BID ALTERNATE 1	ST-12-C	12"	12-1/2"	4.0	IN-LINE	BLADDER	-	125	-	180	

HOT WATER CIRCULATION PUMP SCHEDULE

SYMBOL	MANUFACTURER (OR EQUAL)	MODEL	GPM	HEAD (FT.)	MOTOR				COMMENTS
					HP	VOLTS	PHASE	HZ	
HWCP-1	TACO	008	10	12	1/8	120	1	60	FLANGED CONNECTIONS, IN-LINE UNIT, ALL BRONZE CONSTRUCTION, PROVIDE 7-DAY TIME CLOCK AND AQUASTAT.

ELEVATOR DUPLEX SUMP PUMPS

SYMBOL	MANUFACTURER	MODEL	GPM	HEAD (FT.)	ELECTRICAL				SYSTEM	COMMENTS
					HP	VOLTS	PHASE	HZ		
SP-1 SP-1A	LIBERTY	ELV-280	50	10	1/2	115	1	60	ELEVATOR	UNITS INTERLOCKED TO OPERATE AS DUPLEX UNIT. FURNISH COMPLETE WITH 30" DIAx24" SUMP OR 30"x30"x24" CONCRETE FORMED SUMP. CSI DUPLEX CONTROL PANEL-SEE OIL DETECTION BELOW, NEC 1 ENCLOSURE, LOCKABLE LATCH, H-O-A SWITCHES, CIRCUIT BREAKER, STARTERS, OVERLOAD RELAYS, 20V FLOAT CIRCUIT, UL 508 RATED PANEL, AND PUMP RUN OPERATION INDICATION LIGHTS. PROVIDE WITH ALARM LIGHT AND HORN INDICATION, HIGH WATER ALARM ACTIVATION, TIMER METERS FOR PUMPS, AUX. ALARM CONTACT, AND FLOAT SWITCHES/BRACKET. FURNISH WITH OIL DETECTION SYSTEM COMPLETE WITH CONTROL PANEL. REMOTE ALARM TO BE LOCATED AT ADMINISTRATION. MECHANICAL FLOAT TO SHUT-DOWN PUMPS AT DETECTION OF OIL.

KITCHEN EQUIPMENT PLUMBING SCHEDULE

SYMBOL	FIXTURE TYPE*	ROUGH-IN CONNECTIONS				COMMENTS
		CW	HW	WASTE	GAS	
A02.1, A03.1	WALK-IN EVAP. COIL	---	---	---	---	HEAT TAPE, INSULATE, & JACKET FREEZER DRAIN, INSULATE & JACKET COOLER DRAIN ROUTED TO FLOOR SINK
B01, C02, D01, D39	HAND SINKS	1/2"	1/2"	2"	1-1/2"	---
B02.1, D06.1	FIRE SUPP. SYSTEM	1"	---	---	---	PROVIDE WATTS LF009 BFP, ALARM SWITCH TO HOOD SUPPRESSION SYSTEM
B03	COMBIN. OVEN/STEAMER	(4) 3/4"	---	INDIRECT	---	(2) 190,000 BTUH EACH = 380,000 TOTAL GAS LOAD, INDIRECT DRAINS ROUTED TO FLOOR SINK
B04	30 GAL TILT SKILLET	1/2"	1/2"	---	1/2"	104,000 TOTAL GAS LOAD, DUMPS TO FLOOR TROUGH B05
B05	FLOOR TROUGH	---	---	3" MIN.	2"	FOR B04, GREASE WASTE REQUIRED
B06, D15	GRIDDLE RANGE	---	---	---	3/4"	72,000 TOTAL GAS LOAD EACH
B07	6 BURNER RANGE/OVEN	---	---	---	3/4"	210,000 BTUH TOTAL GAS LOAD
B13, B17, B24, D37	TABLE AND SINK	1/2"	1/2"	INDIRECT	---	INDIRECT DRAINS ROUTED TO FLOOR SINK(S)
B16, D24, D28	HOT FOOD WELLS	1/2"	---	INDIRECT	---	INDIRECT DRAINS ROUTED TO FLOOR SINK(S)
B34, B35, B35.1	ICE BIN, MAKER, FILTER	3/4"	---	INDIRECT	---	INDIRECT DRAINS TO FLOOR SINK
C03	SOILED DISH TABLE	---	---	INDIRECT	---	INDIRECT DRAIN TO FLOOR SINK
C05, C06	DISPOSER, PRE-WASH	(2) 1/2"	1/2"	2"	1-1/2"	COLD WATER TO DISPOSER AND COLD WATER TO PRE-WASH
C07	DISH MACHINE	---	1/2"	INDIRECT	---	110°F WATER MINIMUM, 140°F RECOMMENDED, BOOSTER HEATER, DRAIN WATER TEMPERING WITH UNIT
C13, C14	3-COMP. SINK, PRE-WASH	3/4"	3/4"	INDIRECT	---	INDIRECT DRAIN(S) TO FLOOR SINK (GREASE WASTE REQUIRED)
D05	SODA SYSTEM	1/2"	---	INDIRECT	---	INDIRECT DRAIN TO FLOOR SINK
D11	FRYER SYSTEM	---	---	---	3/4"	220,000 BTUH TOTAL GAS LOAD
D14	CHARBROILER RANGE	---	---	---	3/4"	80,000 TOTAL GAS LOAD
D42	SODA/ICE DISPENSER	1/2"	---	INDIRECT	---	INDIRECT DRAIN TO FLOOR SINK
D43, D43.1	ICE MACHINE/FILTER	1/2"	---	INDIRECT	---	INDIRECT DRAIN TO FLOOR SINK
D45	ICED TEA BREWER	1/4"	---	---	---	BRANCH WATER FROM D47
D47	COFFEE BREWER	1/2"	---	---	---	BRANCH 1/4" WATER TO D45
MUA-B02	MAKE-UP AIR UNIT (B02)	---	---	---	3/4"	254,500 BTUH TOTAL GAS LOAD
MUA-D06	MAKE-UP AIR UNIT (D06)	---	---	---	3/4"	176,200 BTUH TOTAL GAS LOAD

*KITCHEN EQUIPMENT FURNISHED BY OTHERS, ROUGH-INS AND FINAL CONNECTIONS BY PLUMBING CONTRACTOR-COORDINATE WITH FOOD SERVICE DRAWINGS FOR SIZES & LOCATIONS

PLUMBING FIXTURE SCHEDULE


SYMBOL	FIXTURE TYPE	MANUF/MODEL (OR EQUAL)	FIXTURE MOUNTING HEIGHT	CONNECTIONS				COMMENTS
				CW	HW	WASTE	VENT	
P-1	WATER CLOSET	AMERICAN STANDARD NO. 3451.001 "MADERA"	15" TOP OF RIM	1"	---	4"	---	VITREOUS CHINA, FLUSH VALVE, FLOOR MOUNTED, ELONGATED BOWL, SIPHON JET ACTION, WHITE FINISH, OLSONITE NO. 95 OPEN FRONT SEAT, SLOAN CROWN NO. 111-1-28, 1.28 GPF HIGH EFF. WATER SAVER FLUSH VALVE (PISTON ACTIVATED).
P-1A	WATER CLOSET (ADA)	AMERICAN STANDARD NO. 3451.001 "MADERA"	16-1/2" TOP OF RIM	1"	---	4"	2" OR 4" SEE DWG.	VITREOUS CHINA, FLUSH VALVE, FLOOR MOUNTED, ELONGATED BOWL, SIPHON JET ACTION, WHITE FINISH, OLSONITE NO. 95 OPEN FRONT SEAT, SLOAN CROWN NO. 111-1-28, 1.28 GPF HIGH EFF. WATER SAVER FLUSH VALVE (PISTON ACTIVATED).
P-2	URINAL	AMERICAN STANDARD NO. 8950.005 "WASHBROOK"	24" TOP OF RIM	3/4"	---	2"	1-1/2"	VITREOUS CHINA, FLUSH VALVE, WALL HUNG, TOP SPUD, WASHOUT FLUSH ACTION, WHITE FINISH, SLOAN CROWN NO. 189-0-125, 0.125 GPF HIGH EFF. WATER SAVER FLUSH VALVE (PISTON ACTIVATED), ZURN OR SMITH URINAL CARRIER SYSTEM.
P-3	LAVATORY (ADA)	AMERICAN STANDARD NO. 0614.003 "STUDIO"	UNDERCOUNTER SEE ARCH. FOR COUNTER HEIGHT	1/2"	1/2"	2"	1-1/2"	VITREOUS CHINA, 21-25"X15-25"X6-75", SELF-RIMMING, WHITE FINISH, ZURN Z-86500-XL-25M METERING FAUCET WITH ADA PUSH-BUTTON HANDLES AND 0.35 GPM VP AERATOR. PROVIDE WITH LOOSE KEY STOPS AND SUPPLIES, 1-1/4" P-TRAP, GRID STRAINER, TRUEBRO #102 LAV-GUARD KIT, & WATTS MMV THERMOSTATIC MIXING VALVE SET AT 105°F PER ASSE-1070.
P-4	LAVATORY (ADA)	AMERICAN STANDARD NO. 0321.075 "DECYLN"	WALL MOUNTED 34" TO RIM	1/2"	1/2"	2"	1-1/2"	VITREOUS CHINA, 20"x18" CONCEALED ARM, WHITE FINISH, ZURN Z-86500-XL-25M METERING FAUCET WITH ADA PUSH-BUTTON HANDLES AND 0.35 GPM VP AERATOR. PROVIDE WITH LOOSE KEY STOPS AND SUPPLIES, 1-1/4" P-TRAP, GRID STRAINER, TRUEBRO #102 LAV-GUARD KIT, & WATTS MMV THERMOSTATIC MIXING VALVE SET AT 105°F PER ASSE-1070.
P-5	LAVATORY (ADA)	AMERICAN STANDARD NO. 0491.019 "RONDALYN"	COUNTERTOP SEE ARCH. FOR COUNTER HEIGHT	1/2"	1/2"	2"	1-1/2"	VITREOUS CHINA, 20"x17" OVAL, SELF-RIMMING, WHITE FINISH, ZURN Z-86500-XL-25M METERING FAUCET WITH ADA PUSH-BUTTON HANDLES AND 0.35 GPM VP AERATOR. PROVIDE WITH LOOSE KEY STOPS AND SUPPLIES, 1-1/4" P-TRAP, GRID STRAINER, TRUEBRO #102 LAV-GUARD KIT, & WATTS MMV THERMOSTATIC MIXING VALVE SET AT 105°F PER ASSE-1070.
P-6	DRINKING FOUNTAIN (ADA)	HAWS MODEL NO. 1001MS	WALL MOUNTED SEE ARCH. FOR MOUNTING HEIGHTS	1/2"	---	2"	1-1/2"	WALL MOUNTED BARRIER-FREE, 18 GAUGE TYPE 304 SATIN STAINLESS STEEL FINISH W/ BUBBLER WITH HEAD, FRONT PUSH-BUTTON, GRID STRAINER, VANDAL RESISTANT BOTTOM PLATES AND ACCESS PANELS TO TRAP AND STOP. FURNISH WITH DF1 MOUNTING PLATE. PROVIDE WALL STOP & SUPPLY, AND P-TRAP.
P-7	SINGLE SINK (ADA)	ELKAY MODEL LRAD252	COUNTERTOP SEE ARCH. FOR HEIGHT	1/2"	1/2"	2"	1-1/2"	25"x22"x6.5" DEEP, SINGLE BOWL, 18 GAUGE TYPE 304 STAINLESS STEEL, 3 HOLES, LK35 DRAIN, FURNISH WITH MOEN MODEL NO. 8790 HIGH-ARC FAUCET WITH 1.0 GPM AERATOR, PROVIDE WITH LOOSE KEY STOPS & SUPPLIES, P-TRAP, AND TRUEBRO #102 LAV-GUARD KIT (IF REQUIRED)
P-8	DOUBLE SINK (ADA)	ELKAY MODEL LRAD250	COUNTERTOP SEE ARCH. FOR HEIGHT	1/2"	1/2"	2"	1-1/2"	33"x22"x6.5" DEEP, DOUBLE BOWL, 18 GAUGE TYPE 304 STAINLESS STEEL, 4 HOLES, LK35 DRAIN, FURNISH WITH MOEN MODEL NO. 8792 HIGH-ARC FAUCET WITH SIDE SPRAY AND 1.0 GPM AERATOR, PROVIDE WITH IN-SINK ERATOR BADGER 5-1/2 HP MOTOR, 120V-1-PH-60 HZ DISPOSAL, PROVIDE WITH CONTINUOUS WASTE, LOOSE KEY STOPS & SUPPLIES, P-TRAP, AND TRUEBRO #102 HANDI LAV-GUARD KIT & #107 CONTINUOUS WASTE COVER (IF REQUIRED)
P-9	SHOWER	COMFORT DESIGN MODEL XSS-3636 SH 4.0	STANDARD	1/2"	1/2"	2"	1-1/2"	POLYESTER GELCOATED SURFACE WITH CENTER DRAIN, NON-ADA WITH 4" THRESHOLD, AND CURTAIN ROD. PROVIDE WITH AMERICAN STANDARD NO. 1662.211 PB VALVE W/ STOPS, VALVE TRIM W/ LEVER HANDLE, 1.5 GPM HANDHELD SHOWERHEAD WITH FLEXIBLE 60" METAL HOSE, WALL CONNECTION WITH FLANGE, VAC. BREAKER, 36" SLIDE BAR-POLISHED CHROME FINISH, CURTAIN AND HOOKS FURNISHED BY OTHERS, PROVIDE WITH ZURN Z-415 DRAIN WITH ROUND STRAINER.
P-10	SHOWER (ADA)	COMFORT DESIGN MODEL XST-6232-BF-5P	STANDARD	1/2"	1/2"	2"	1-1/2"	POLYESTER GELCOATED SURFACE WITH CENTER DRAIN, ADA: BACK AND SIDE GRAB BARS, L-SHAPED FOLD-UP SEAT. PROVIDE WITH AMERICAN STANDARD NO. 1662.211 PB VALVE W/ STOPS, VALVE TRIM W/ LEVER HANDLE, 1.5 GPM HANDHELD SHOWERHEAD WITH FLEXIBLE 60" METAL HOSE, WALL CONNECTION WITH FLANGE, VAC. BREAKER, 36" SLIDE BAR-POLISHED CHROME FINISH, CURTAIN ROD AND CURTAIN WITH HOOKS BY OTHERS. PROVIDE WITH ZURN Z-415 DRAIN WITH ROUND STRAINER.
P-11	MOP BASIN	FIAT MODEL T5BC6010	FLOOR	1/2"	1/2"	3"	2"	WITH 1453-BB STRAINER, NO. 830-AA FAUCET AT 42" AFF, NO. 832-AA HOSE AND HOSE BRACKET, STAINLESS STEEL CAP, NO. 889-CC MOP HANGER, AND SEALED AROUND WITH NO. 833-AA SILICONE SEAL.

MISCELLANEOUS PLUMBING FIXTURE SCHEDULE

SYMBOL	FIXTURE TYPE	MODEL	CONNECTIONS				COMMENTS
			CW	HW	WASTE	VENT	
FCO	FLOOR CLEANOUT (BUILDING, SEE ARCH. FOR FINISH)	ZURN NO. ZN-1400 NH	---	---	SEE PLANS	---	ZURN NO. ZN-1400-X NH, RECESSED FOR TILE. ZURN NO. ZN-1400-CF NH FOR CARPET, WITH MARKER
CO	CLEANOUT (OUTSIDE OR AT UNFINISHED AREA)	ZURN NO. Z-1400-HD NH CAST IRON TAP	---	---	SEE PLANS	---	BRONZE TOP IN OUTSIDE AREAS, CAST IRON TOP, VANDAL PROOF SCREWS.
WCO	WALL CLEANOUT	ZURN NO. Z-1468 ZS	---	---	SEE PLANS	---	INSTALL WHERE C.O. BELOW FIXTURE CONNECTION IS REQUIRED BY CODE AND WHERE SHOWN ON PLANS. BRONZE PLUG WITH STAINLESS STEEL FACE WALL PLATE, WITH VANDAL-PROOF SCREWS.
FD-1	FLOOR DRAIN	ZURN ZN-415 W/TYP B	---	---	2"	2"	ROUND TOP WITH VENTED P-TRAP. PROVIDE WITH PROSET TRAP GUARD. (EXCEPT IN KITCHEN)
FS-1	FLOOR SINK	ZURN NO. Z-1900	---	---	3" OR 4"	2"	A.R.E. BODY (12"x12"x8") TOP GRATE, 8" DEEP SUMP, WITH PROSET TRAP GUARD (EXCEPT IN KITCHEN)
WHA-1	WATER HAMMER ARRESTOR	ZURN SHOKTROL	AS REQ'D	---	---	---	SIZED PER FIXTURE UNIT LOAD
AP	ACCESS PANEL	ELMDOR SLK 8"x8"	---	---	---	---	DRY WALL INSTALLATION, 14 GA MILD STEEL WITH PRIME COAT FINISH, PROVIDE AUTOMATIC SPRING BOLT TYPE LOCK AND KEY, INSTALL DOOR DIRECTLY IN FRONT OF WATER HAMMER ARRESTOR IN WALL.
WHY-1	WALL HYDRANT FREEZE RESISTANT	ZURN NO. Z-1310	3/4"	---	---	---	NON-FREEZE, ANTI-SIPHON, AND AUTOMATIC DRAINING, WITH P.B. BOX AND LOOSE KEY. SEE ARCH. PLAN FOR WALL THICKNESS, 18" MOUNTING HEIGHT.
PRV-1	PRESSURE REDUCING VALVE	FEBCO 500YSBR	3"	---	---	---	25 TO 75 PSI SPRING, 110 GPM AT 15 PSI PRESSURE DROP, SET TO DELIVER 55 PSI TO BUILDING. PROVIDE WITH STRAINER AT INLET.
RPBP-1	REDUCED PRESSURE BACKFLOW PREVENTER	FEBCO 880V VERTICAL	3"	---	---	---	REDUCED PRESSURE PRINCIPLE BACKFLOW PREVENTER, Y STRAINER AND REPLACABLE SEATS. BRONZE BODY CONSTRUCTION, MAXIMUM WORKING PRESSURE OF 175 PSI. USC CERTIFIED, DOMESTIC WATER SERVICE.
RPBP-2	REDUCED PRESSURE BACKFLOW PREVENTER	FEBCO 880V VERTICAL	6"	---	---	---	REDUCED PRESSURE PRINCIPLE BACKFLOW PREVENTER, Y STRAINER AND REPLACABLE SEATS. BRONZE BODY CONSTRUCTION, MAXIMUM WORKING PRESSURE OF 175 PSI. USC CERTIFIED, FIRE PROTECTION WATER SERVICE.
RD	ROOF DRAIN	ZURN NO. Z-100	---	---	SEE PLANS	---	15" DIAMETER DUAL OUTLET ROOF DRAIN WITH PRIMARY OUTLET CONNECTION, DURA-COATED CAST IRON DEEP SUMP WITH COMBINATION MEMBRANE FLASHING CLAMP/ GRAVEL GUARD, AND LOW SILHOUTTE CAST IRON DOME.
ORD	OVERFLOW ROOF DRAIN	ZURN NO. Z-100-W2	---	---	SEE PLANS	---	15" DIAMETER DUAL OUTLET ROOF DRAIN WITH PRIMARY OUTLET CONNECTION, DURA-COATED CAST IRON DEEP SUMP WITH COMBINATION MEMBRANE FLASHING CLAMP/ GRAVEL GUARD, 2" HIGH INTERNAL WATER DAM, AND LOW SILHOUTTE CAST IRON DOME.
DSN	DOWNSPOUT NOZZLE	ZURN NO. Z199-SS	---	---	SEE PLANS	---	NICKEL BRONZE BODY, THREADED INLET AND DECORATIVE FACE WALL FLANGE AND NOZZLE, SCREEN
GI-1	GREASE INTERCEPTOR	SCHIER MODEL NO. GB-250 TRAFFIC	---	---	4"	2"	100 GPM FLOW RATE, 1060 LBS. MAXIMUM CAPACITY, SEAMLESS MOLDED POLYETHYLENE TANK WITH BUILT-IN FLOW CONTROL, INLET AND OUTLET DIFFUSERS REMOVABLE FOR INSPECTING AND CLEANING, INTEGRAL AIR RELIEF/ANTI-SIPHON/INSULATION INSPECTION, PROVIDE RISERS AS REQUIRED, TRAFFIC RATED.
TMV-1	THERMOSTATIC MIXING VALVE	LEONARD NO. TM-186-8015-PRV-RO-G	1"	1"	---	---	1-1/4" OUTLET, HIGH-LOW MANIFOLD FACTORY PREASSEMBLED/TESTED



DYRON MURPHY ARCHITECTS, P.C.

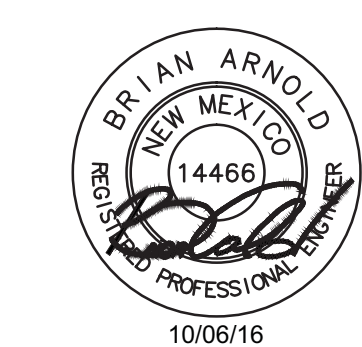

ENGINEER

Revision Schedule		
Revision Number	Revision Date	Revision Description
1	11/10/16	ADD.03

PROJECT NUMBER: 2015.05
DRAWN BY: HRM
PROJ/MGR: BA
RVT FILE

Sheet Number

P002

Sequence of

ENTIRE SHEET IS RE-ISSUED FOR CLARIFICATION

PLUMBING SCHEDULES

E

D

C

B

A

DYRON MURPHY ARCHITECTS, P.C.

6

5

4

3

2

1

NTUA HQ COMPLEX
OFFICE BUILDING

FT. DEFIANCE, ARIZONA
100% CONSTRUCTION DOCUMENTS
OCTOBER 6, 2016


E

D


C

B

A

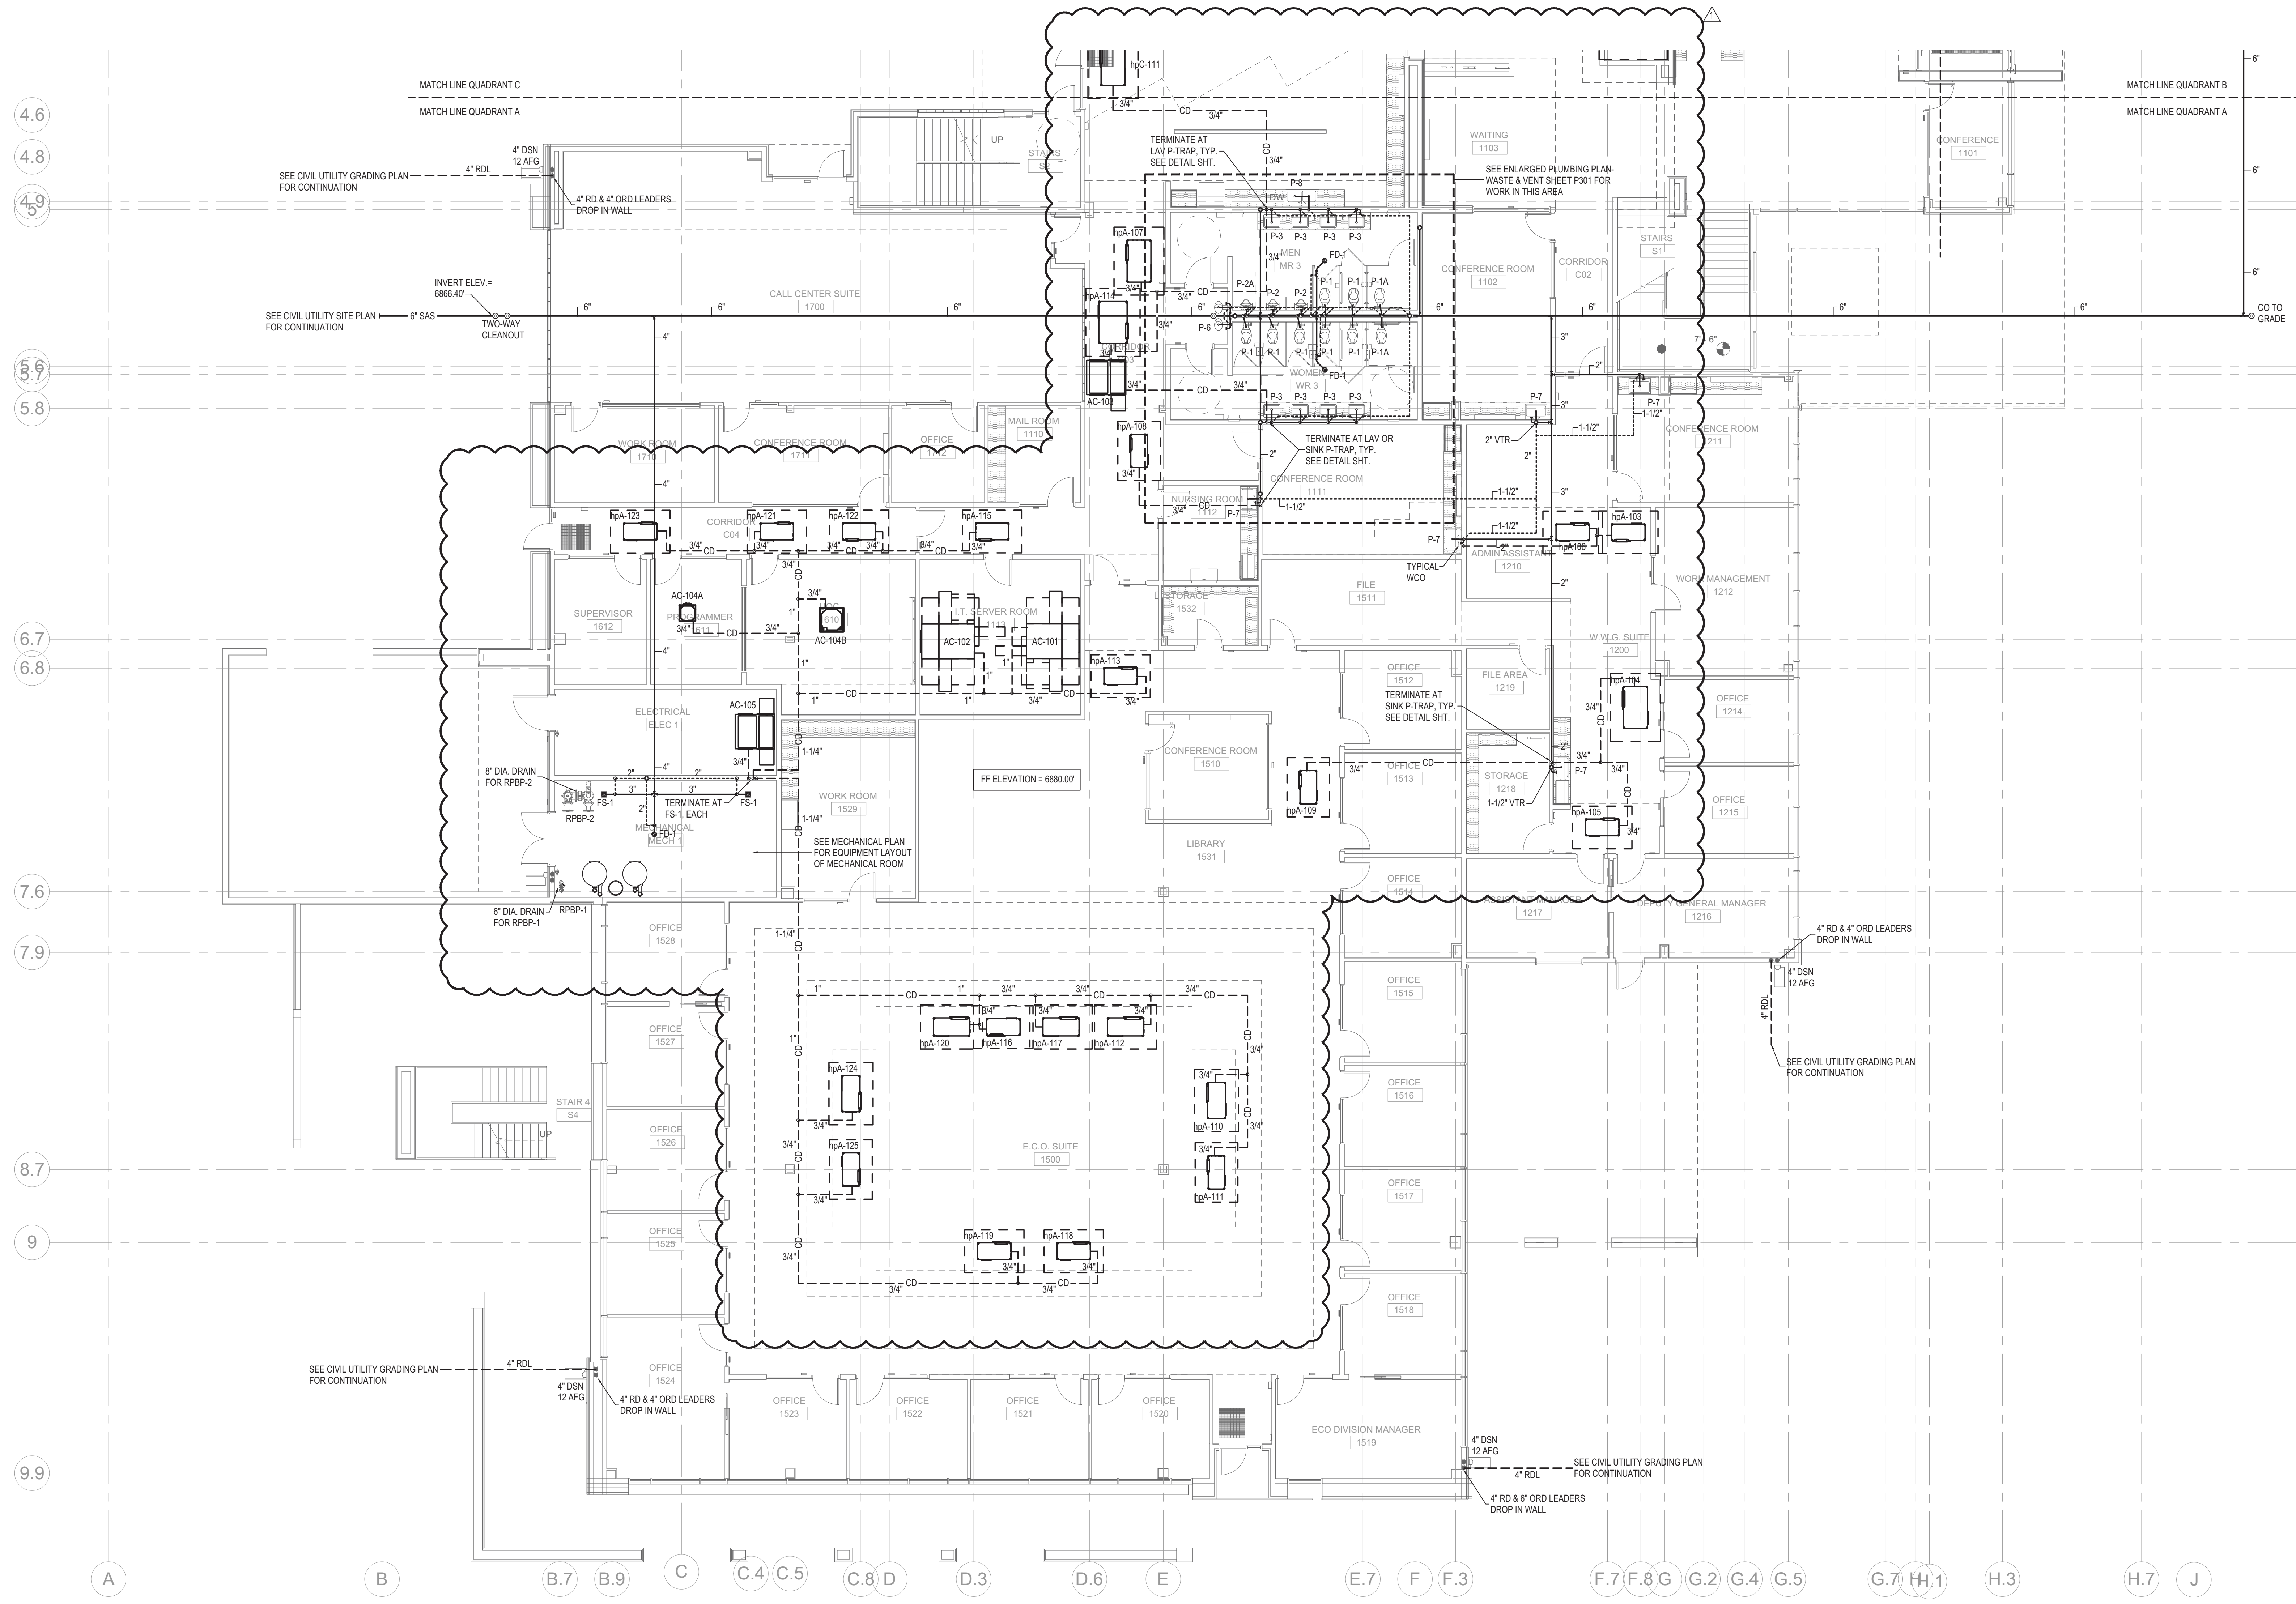

DYRON MURPHY ARCHITECTS, P.C.

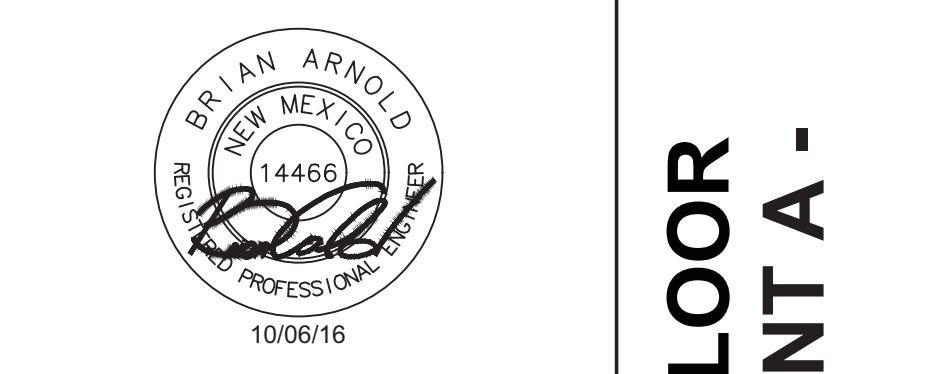

Revision Schedule		
Revision Number	Revision Date	Revision Description
1	11/10/16	ADD. 03

PROJECT NUMBER	DRAWN BY	PROJ MGR
2015.05	HRM	BA
RVT FILE		

Sheet Number

P101a

Sequence of

PLUMBING 1st FLOOR PLAN - QUADRANT A - WASTE & VENT

A6 PLUMBING 1st FLOOR PLAN - QUADRANT A - WASTE & VENT
1/8" = 1'-0"

DYRON MURPHY ARCHITECTS, P.C.

6 5 4 3 2 1

E


D

C

B

A


DYRON MURPHY ARCHITECTS, P.C.

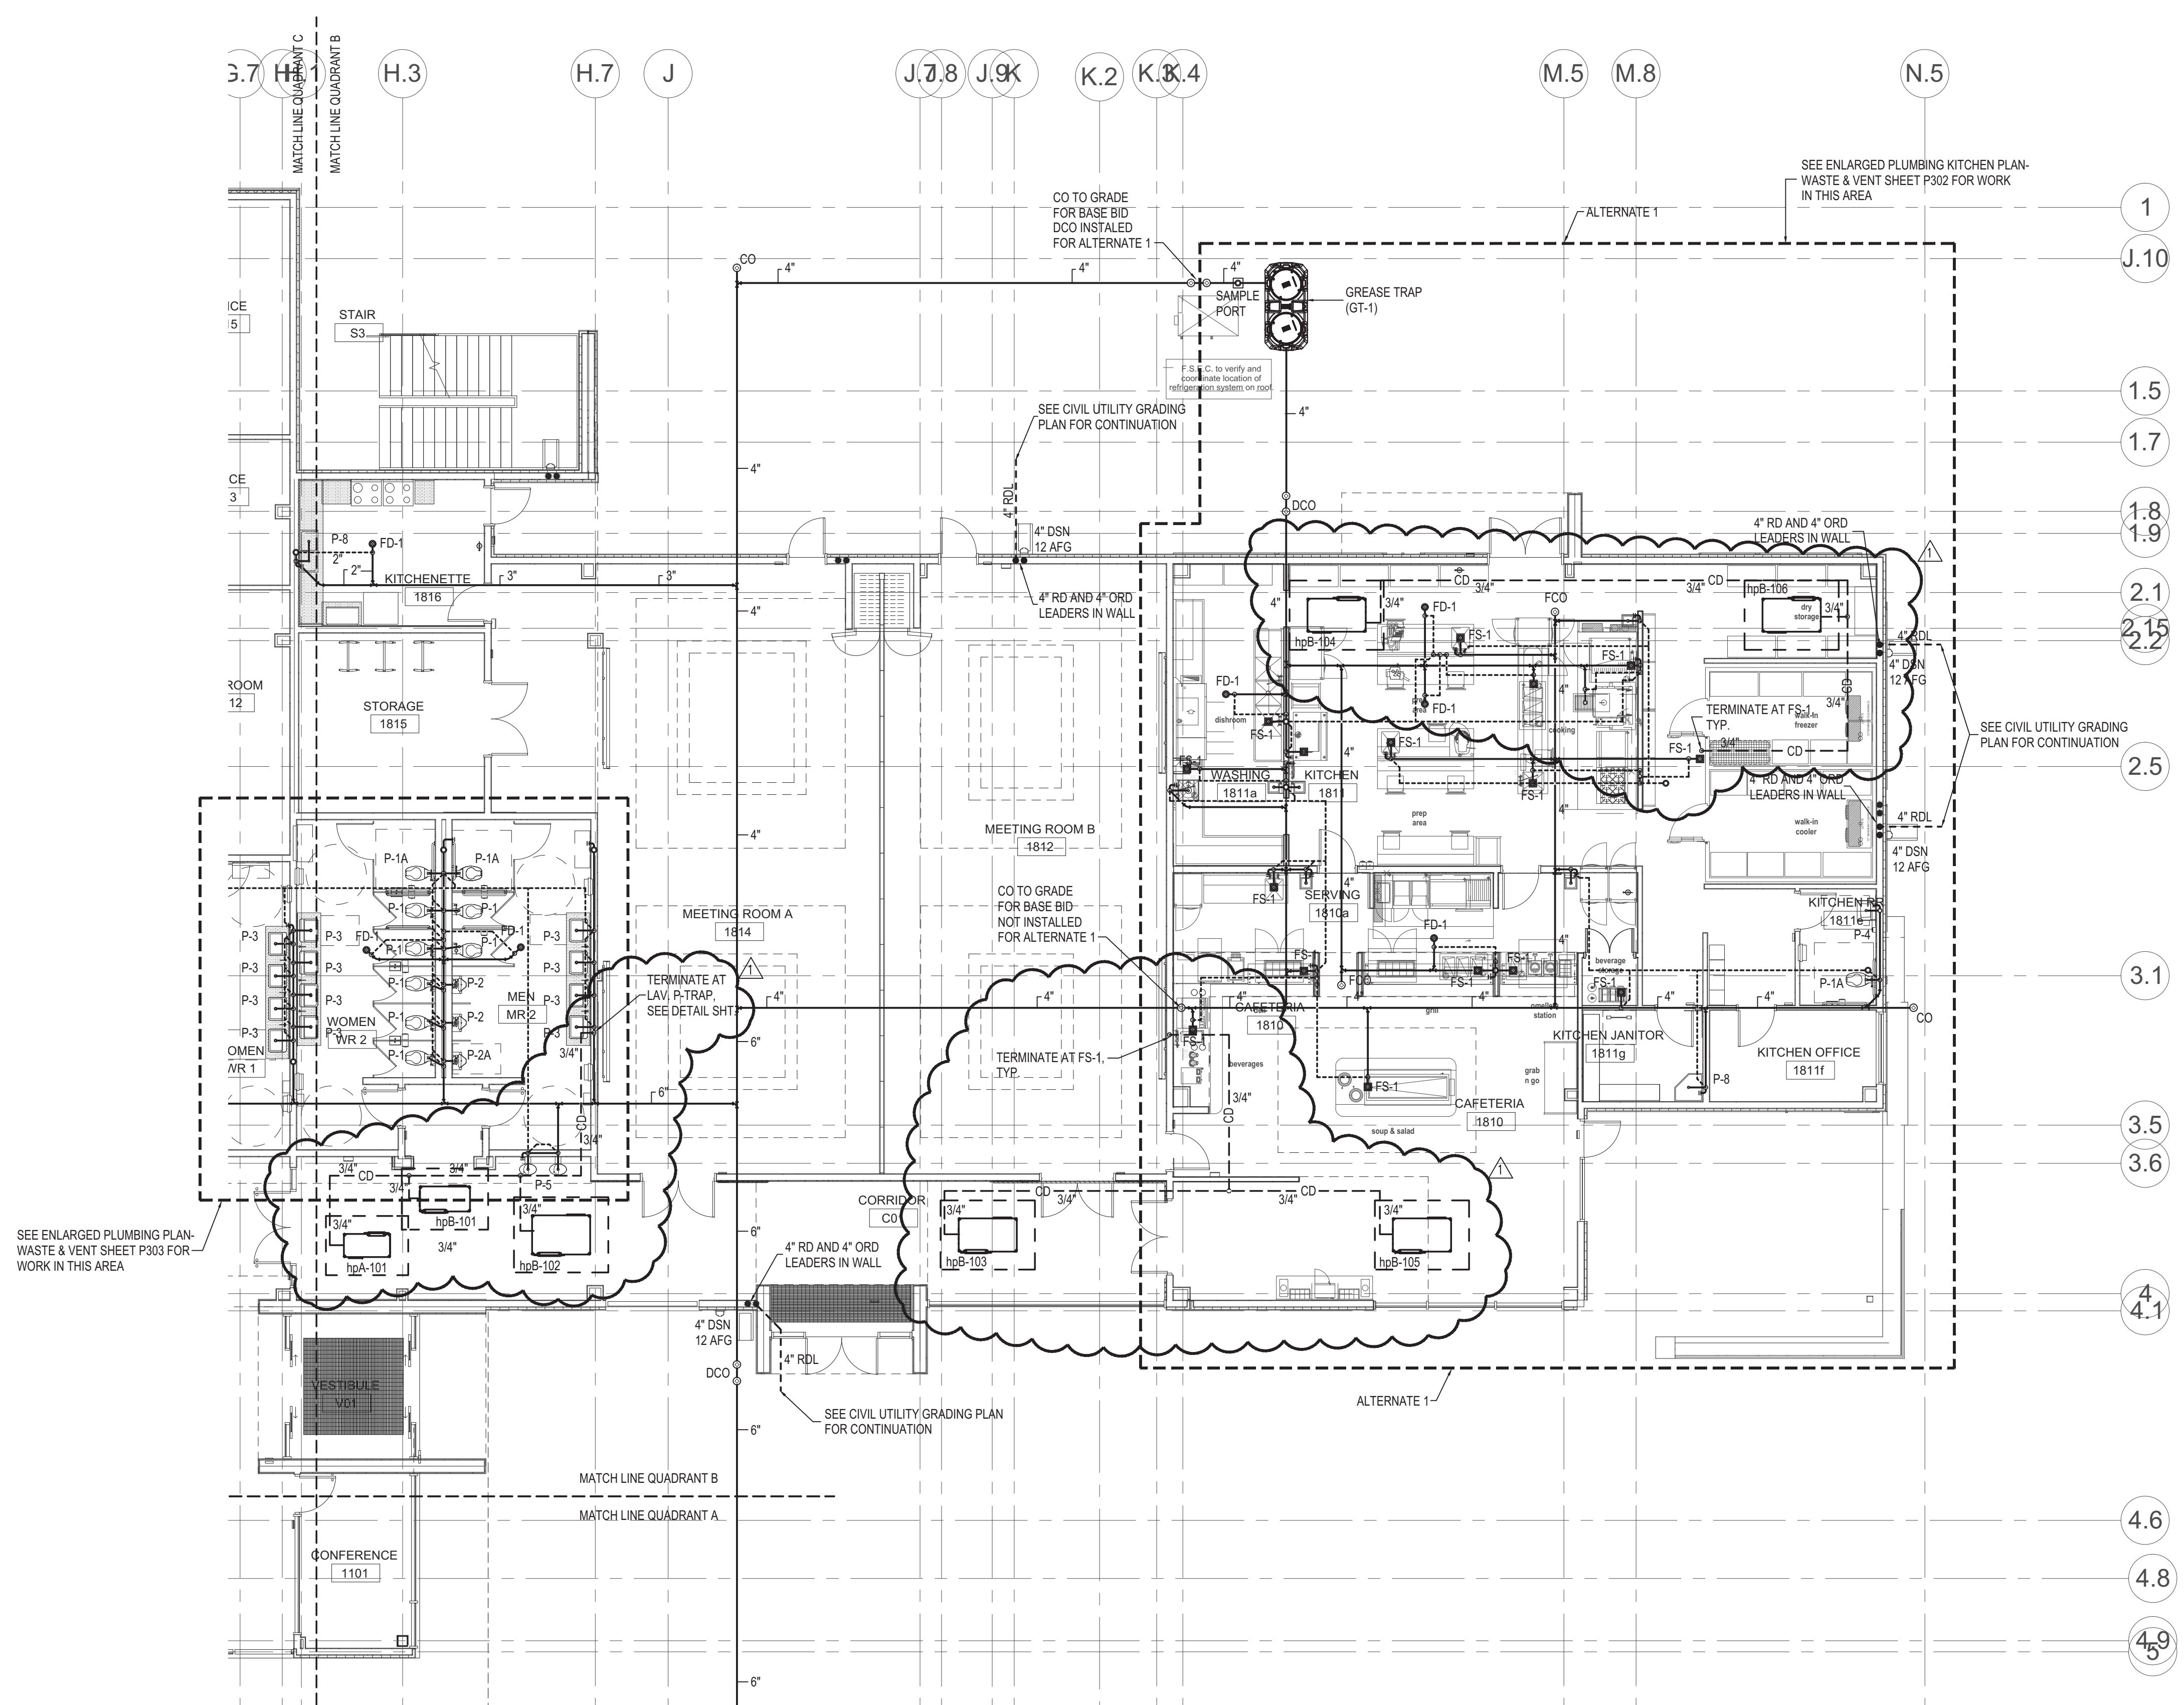


A4 PLUMBING 1st FLOOR PLAN - QUADRANT B - WASTE & VENT
1/8" = 1'-0"



DYRON MURPHY ARCHITECTS, P.C.

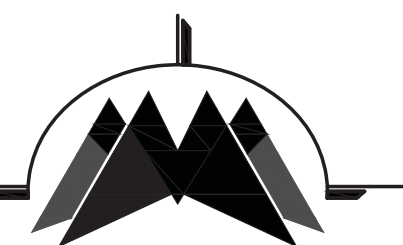

4505 Montbel Place NE, Albuquerque, New Mexico 87107

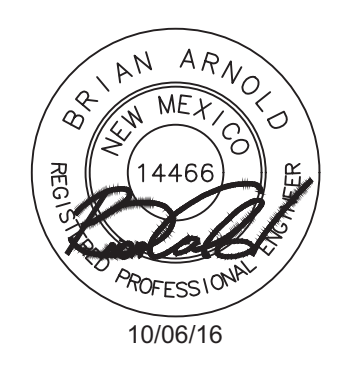

ENGINEER

Revision Schedule		
Revision Number	Revision Date	Revision Description
1	11/10/16	ADD. G3

PROJECT NUMBER	DRAWN BY	PROJ MGR
2015.05	HRM	BA
RVT FILE		

Sheet Number

P101b

Sequence of

PLUMBING 1st FLOOR PLAN - QUADRANT B - WASTE & VENT

6

5

4

3

2

1

NTUA HQ COMPLEX
OFFICE BUILDING

FT. DEFIANCE, ARIZONA
100% CONSTRUCTION DOCUMENTS
OCTOBER 6, 2016


E

D

C

B

A

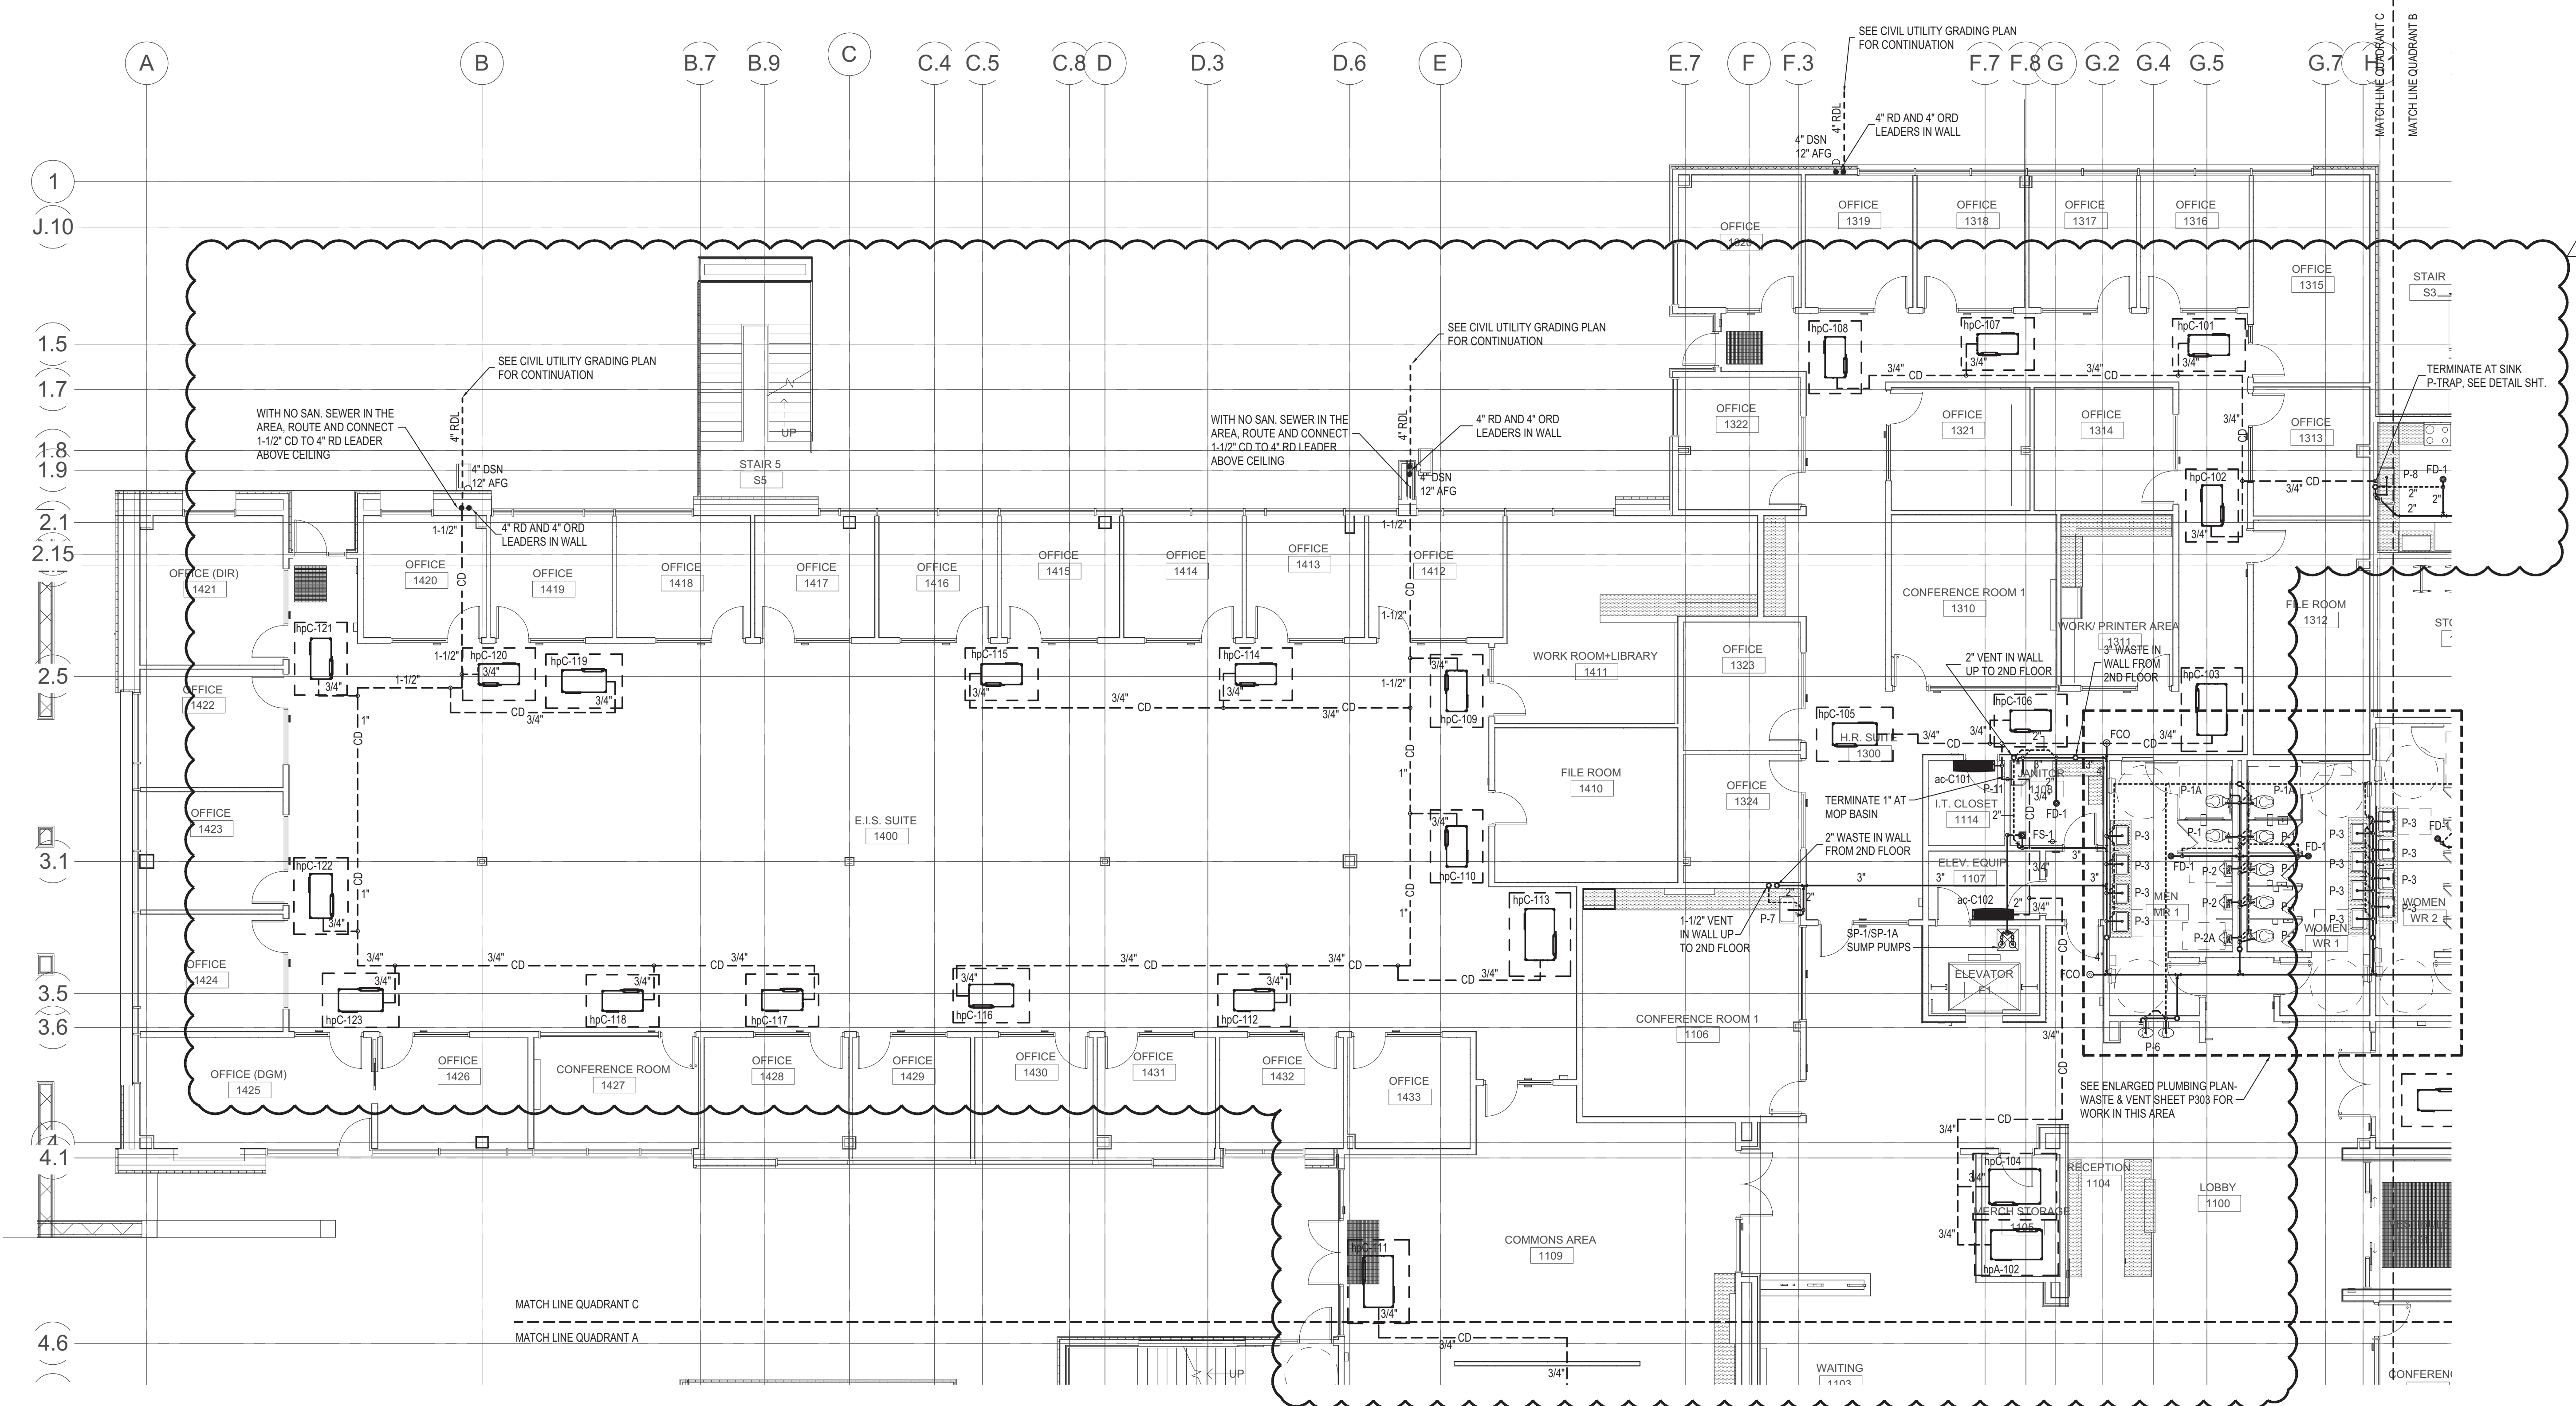

A6 PLUMBING 1st FLOOR PLAN - QUADRANT C - WASTE & VENT
1/8" = 1'-0"



DYRON MURPHY ARCHITECTS, P.C.



Revision Schedule		
Revision Number	Revision Date	Revision Description
1	11/10/16	ADD. G3

PROJECT NUMBER	DRAWN BY	PROJ MGR
2015.05	HRM	BA
RVT FILE		

Sheet Number

P101c

Sequence of

PLUMBING 1st FLOOR PLAN - QUADRANT C - WASTE & VENT

DYRON MURPHY ARCHITECTS, P.C.

6 5 4 3 2 1


E

D

C


B

A

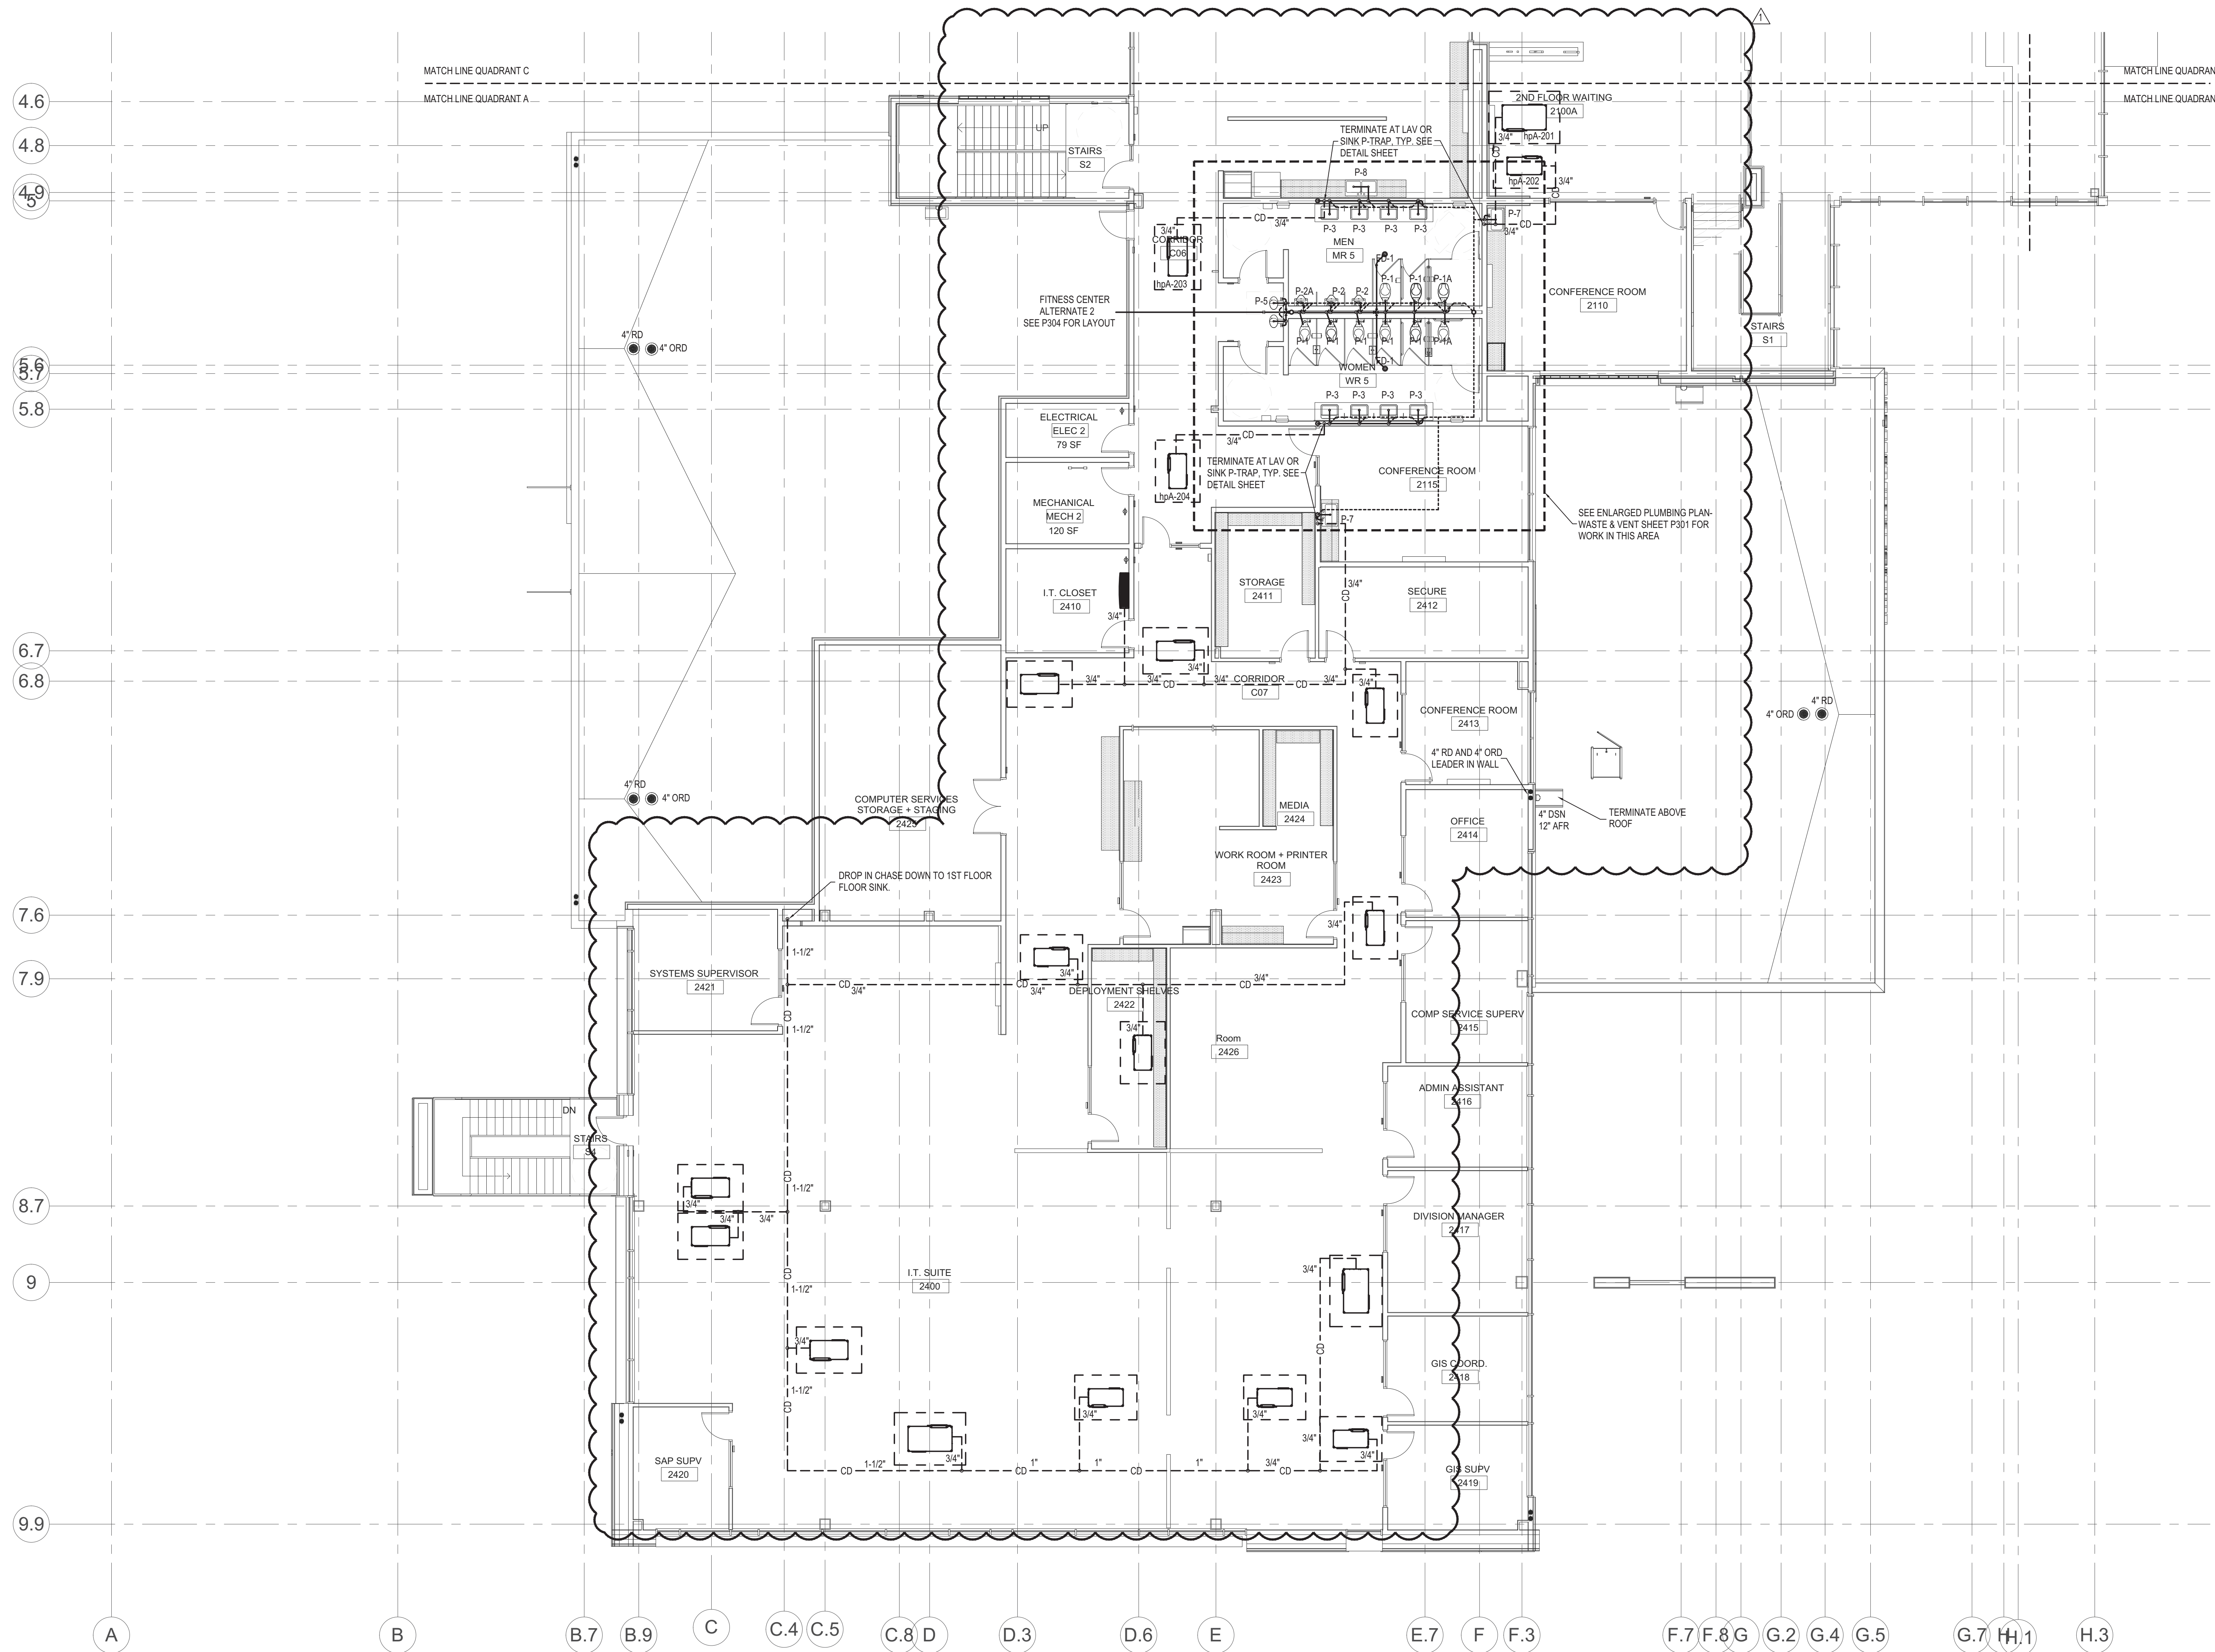

4700 Lincoln Road, NE 1 Suite 101 Albuquerque, NM 87109 | 505.761.3100

DYRON MURPHY ARCHITECTS, P.C.

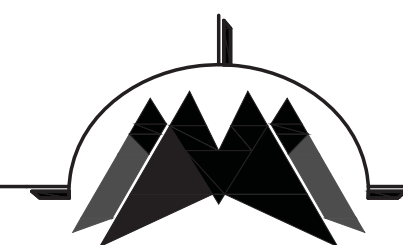

4505 Montbel Place NE, Albuquerque, New Mexico 87107



ENGINEER

Revision Schedule		
Revision Number	Revision Date	Revision Description
1	11/10/16	ADD. GS

PROJECT NUMBER 2015.05	DRAWN BY HRM	PROJ MGR BA
RVT FILE		

Sheet Number

P102a

Sequence of

**PLUMBING 2nd FLOOR
PLAN - QUADRANT A -
WASTE & VENT**

A6 PLUMBING 2nd FLOOR PLAN - QUADRANT A - WASTE & VENT
1/8" = 1'-0"

6

5

4

3

2

1

DYRON MURPHY ARCHITECTS, P.C.

NTUA HQ COMPLEX
OFFICE BUILDING

FT. DEFIANCE, ARIZONA
100% CONSTRUCTION DOCUMENTS
OCTOBER 6, 2016


E

D

C

B

A

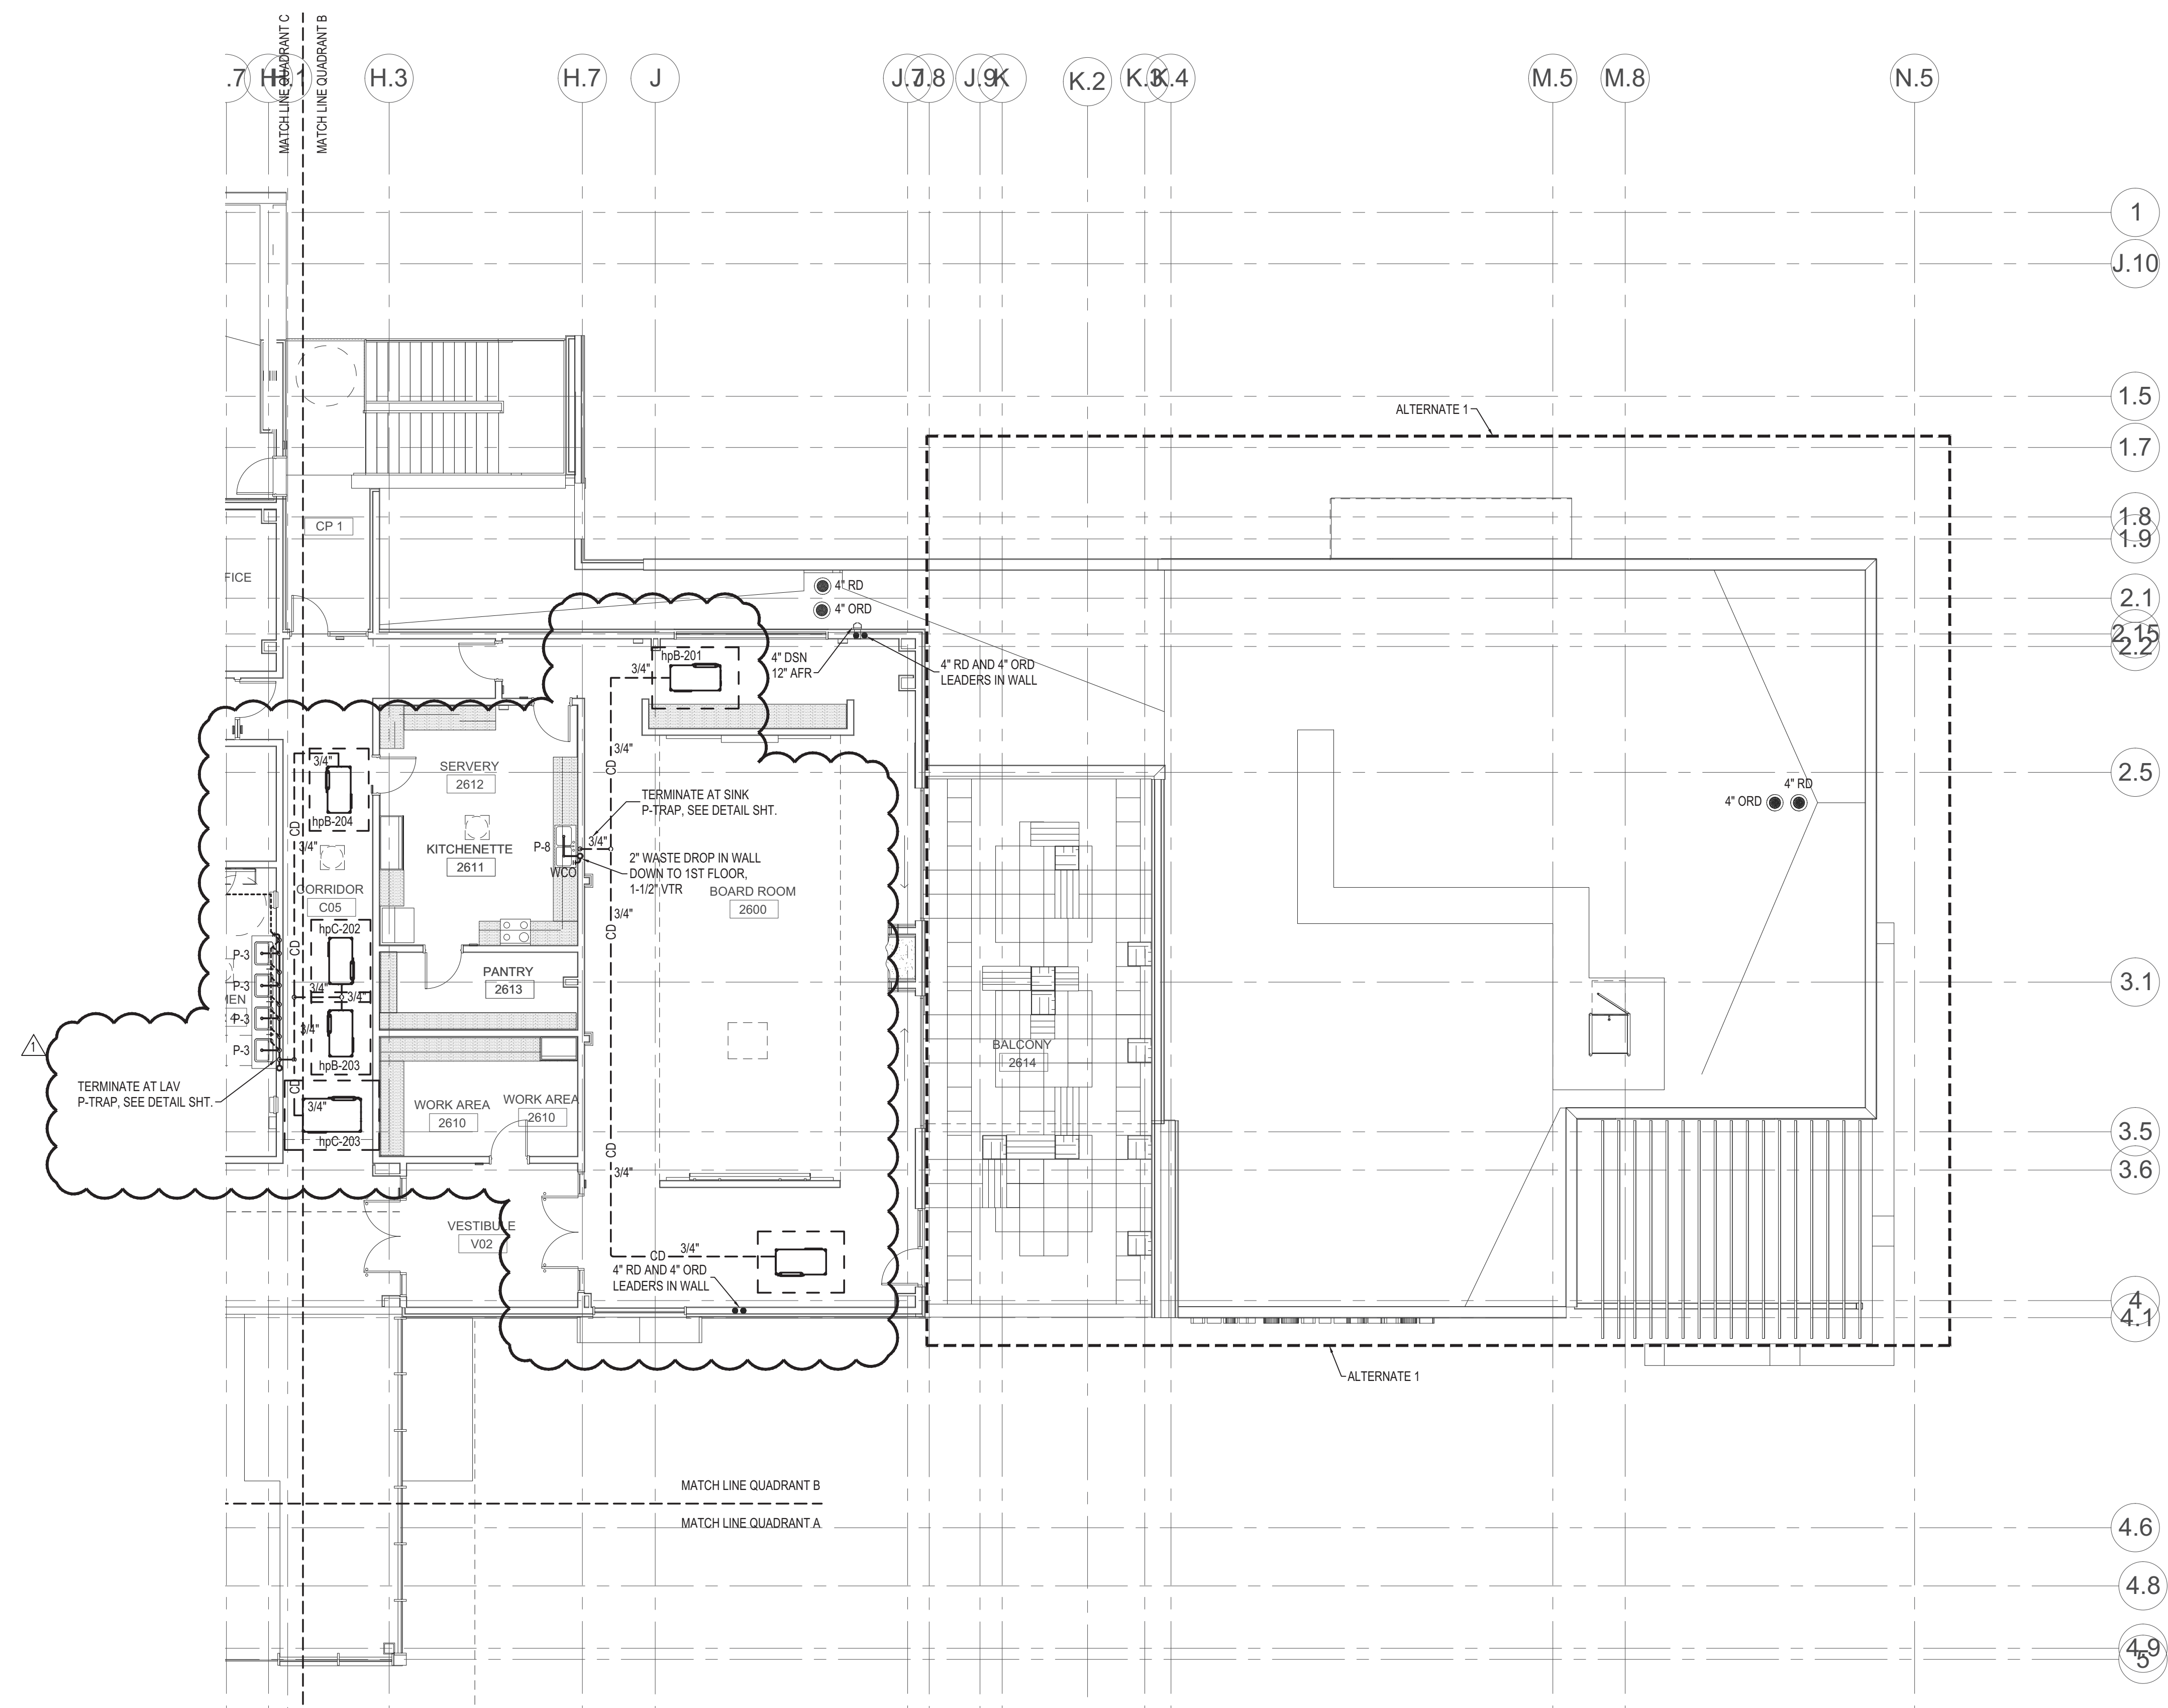

A4 PLUMBING 2nd FLOOR PLAN - QUADRANT B - WASTE & VENT
1/8" = 1'-0"



DYRON MURPHY ARCHITECTS, P.C.



4505 Montbel Place NE, Albuquerque, New Mexico 87107



ENGINEER

Revision Schedule		
Revision Number	Revision Date	Revision Description
1	11/10/16	ADD. 03

PROJECT NUMBER 2015.05	DRAWN BY HRM	PROJ MGR BA
RVT FILE		

Sheet Number

P102b

Sequence of

PLUMBING 2nd FLOOR PLAN - QUADRANT B - WASTE & VENT

NTUA HQ COMPLEX
OFFICE BUILDING

FT. DEFIANCE, ARIZONA
100% CONSTRUCTION DOCUMENTS
OCTOBER 6, 2016


E

D

C

B

A

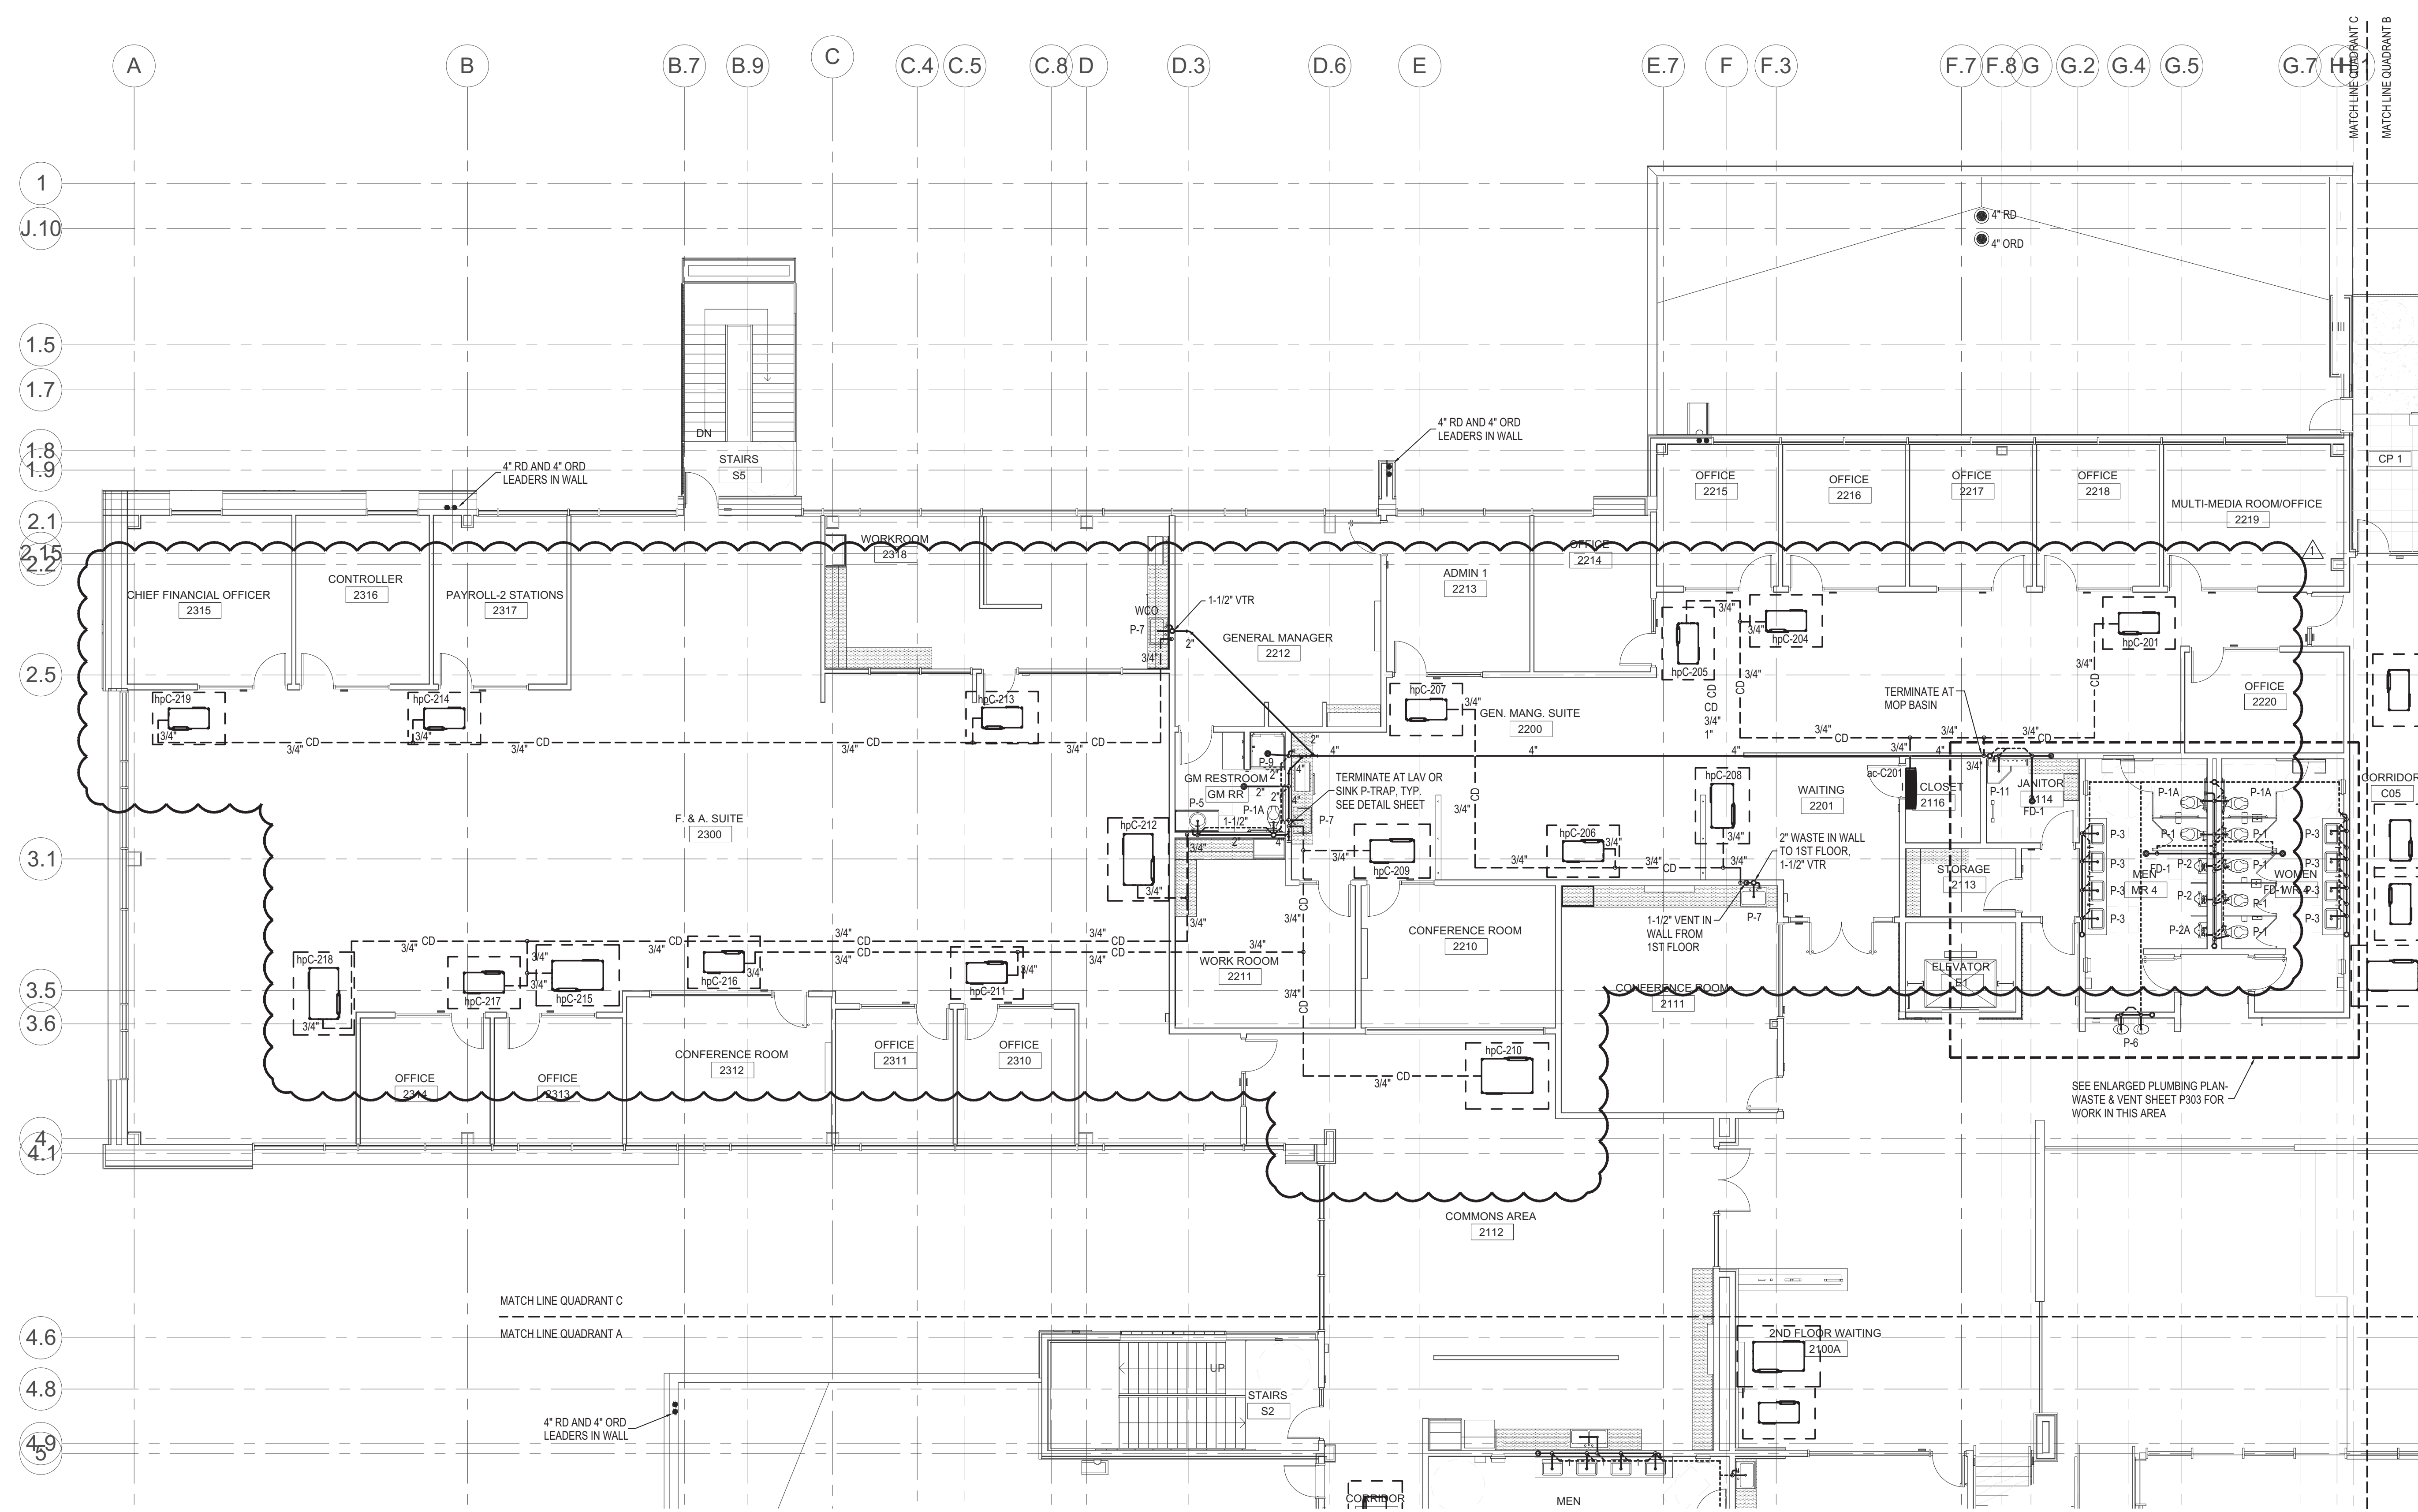


A6 PLUMBING 2nd FLOOR PLAN - QUADRANT C - WASTE & VENT
1/8" = 1'-0"




4700 Lincoln Road, NE 1 Suite 101 Albuquerque, NM 87109 | 505.761.3100

DYRON MURPHY ARCHITECTS, P.C.

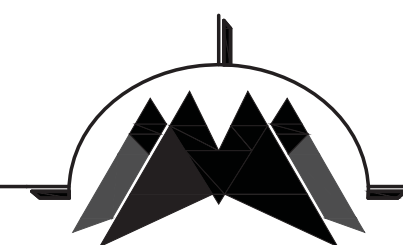

4505 Montbel Place NE, Albuquerque, New Mexico 87107

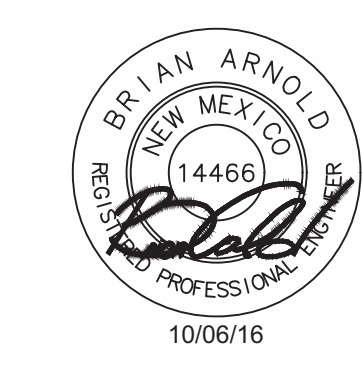

Revision Schedule		
Revision Number	Revision Date	Revision Description
1	11/10/16	ADD. G3

PROJECT NUMBER	DRAWN BY	PROJ MGR
2015.05	HRM	BA
RVT FILE		

Sheet Number

P102c

Sequence of

PLUMBING 2nd FLOOR PLAN - QUADRANT C - WASTE & VENT

6

5

4

3

2

1

DYRON MURPHY ARCHITECTS, P.C.

NTUA HQ COMPLEX
OFFICE BUILDING

FT. DEFIANCE, ARIZONA
100% CONSTRUCTION DOCUMENTS
OCTOBER 6, 2016


E

D

C

B

A

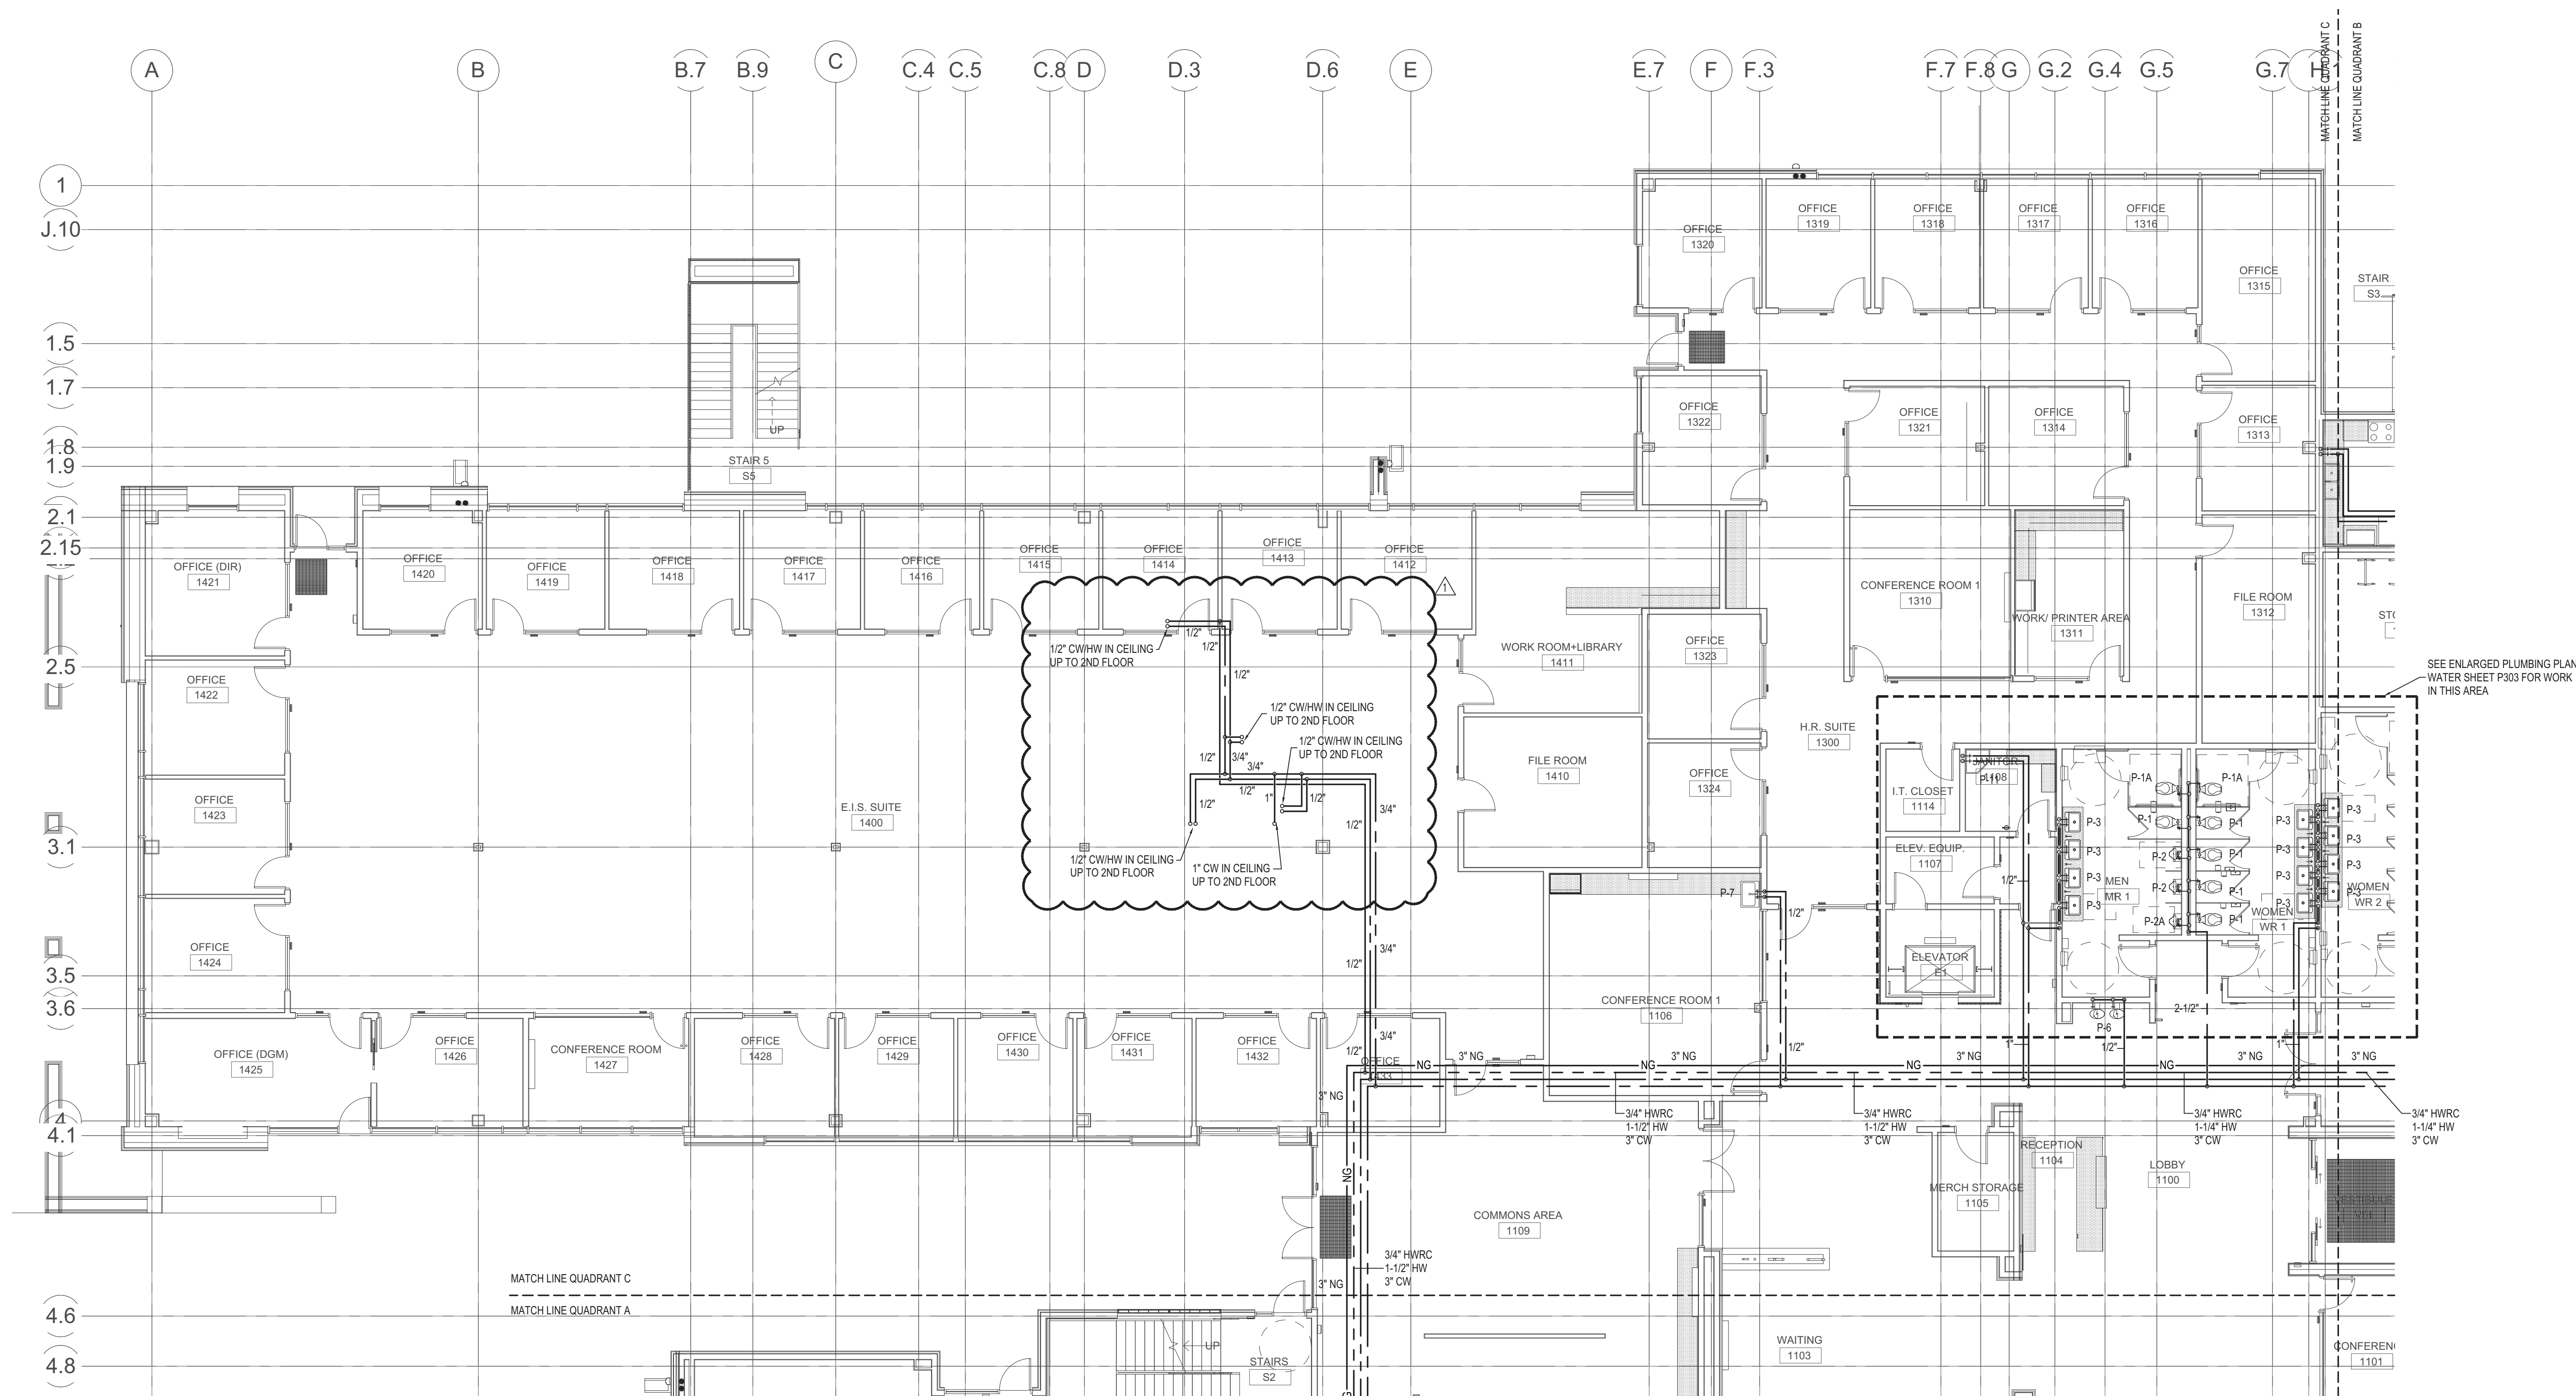

A6 PLUMBING 1st FLOOR PLAN - QUADRANT C - WATER & GAS
1/8" = 1'-0"



4700 Lincoln Road, NE 1 Suite 101 | Albuquerque, NM 87109 | 505.761.3100

DYRON MURPHY ARCHITECTS, P.C.



4505 Montbel Place NE, Albuquerque, New Mexico 87107



Revision Schedule		
Revision Number	Revision Date	Revision Description
1	11/10/16	ADD. G3

PROJECT NUMBER	DRAWN BY	PROJ MGR
2015.05	HRM	BA
RVT FILE		

Sheet Number

P111c

Sequence of

PLUMBING 1st FLOOR PLAN - QUADRANT C - WATER & GAS

DYRON MURPHY ARCHITECTS, P.C.

6

5

4

3

2

1

NTUA HQ COMPLEX
OFFICE BUILDING

FT. DEFIANCE, ARIZONA
100% CONSTRUCTION DOCUMENTS
OCTOBER 6, 2016


E

D

C

B

A

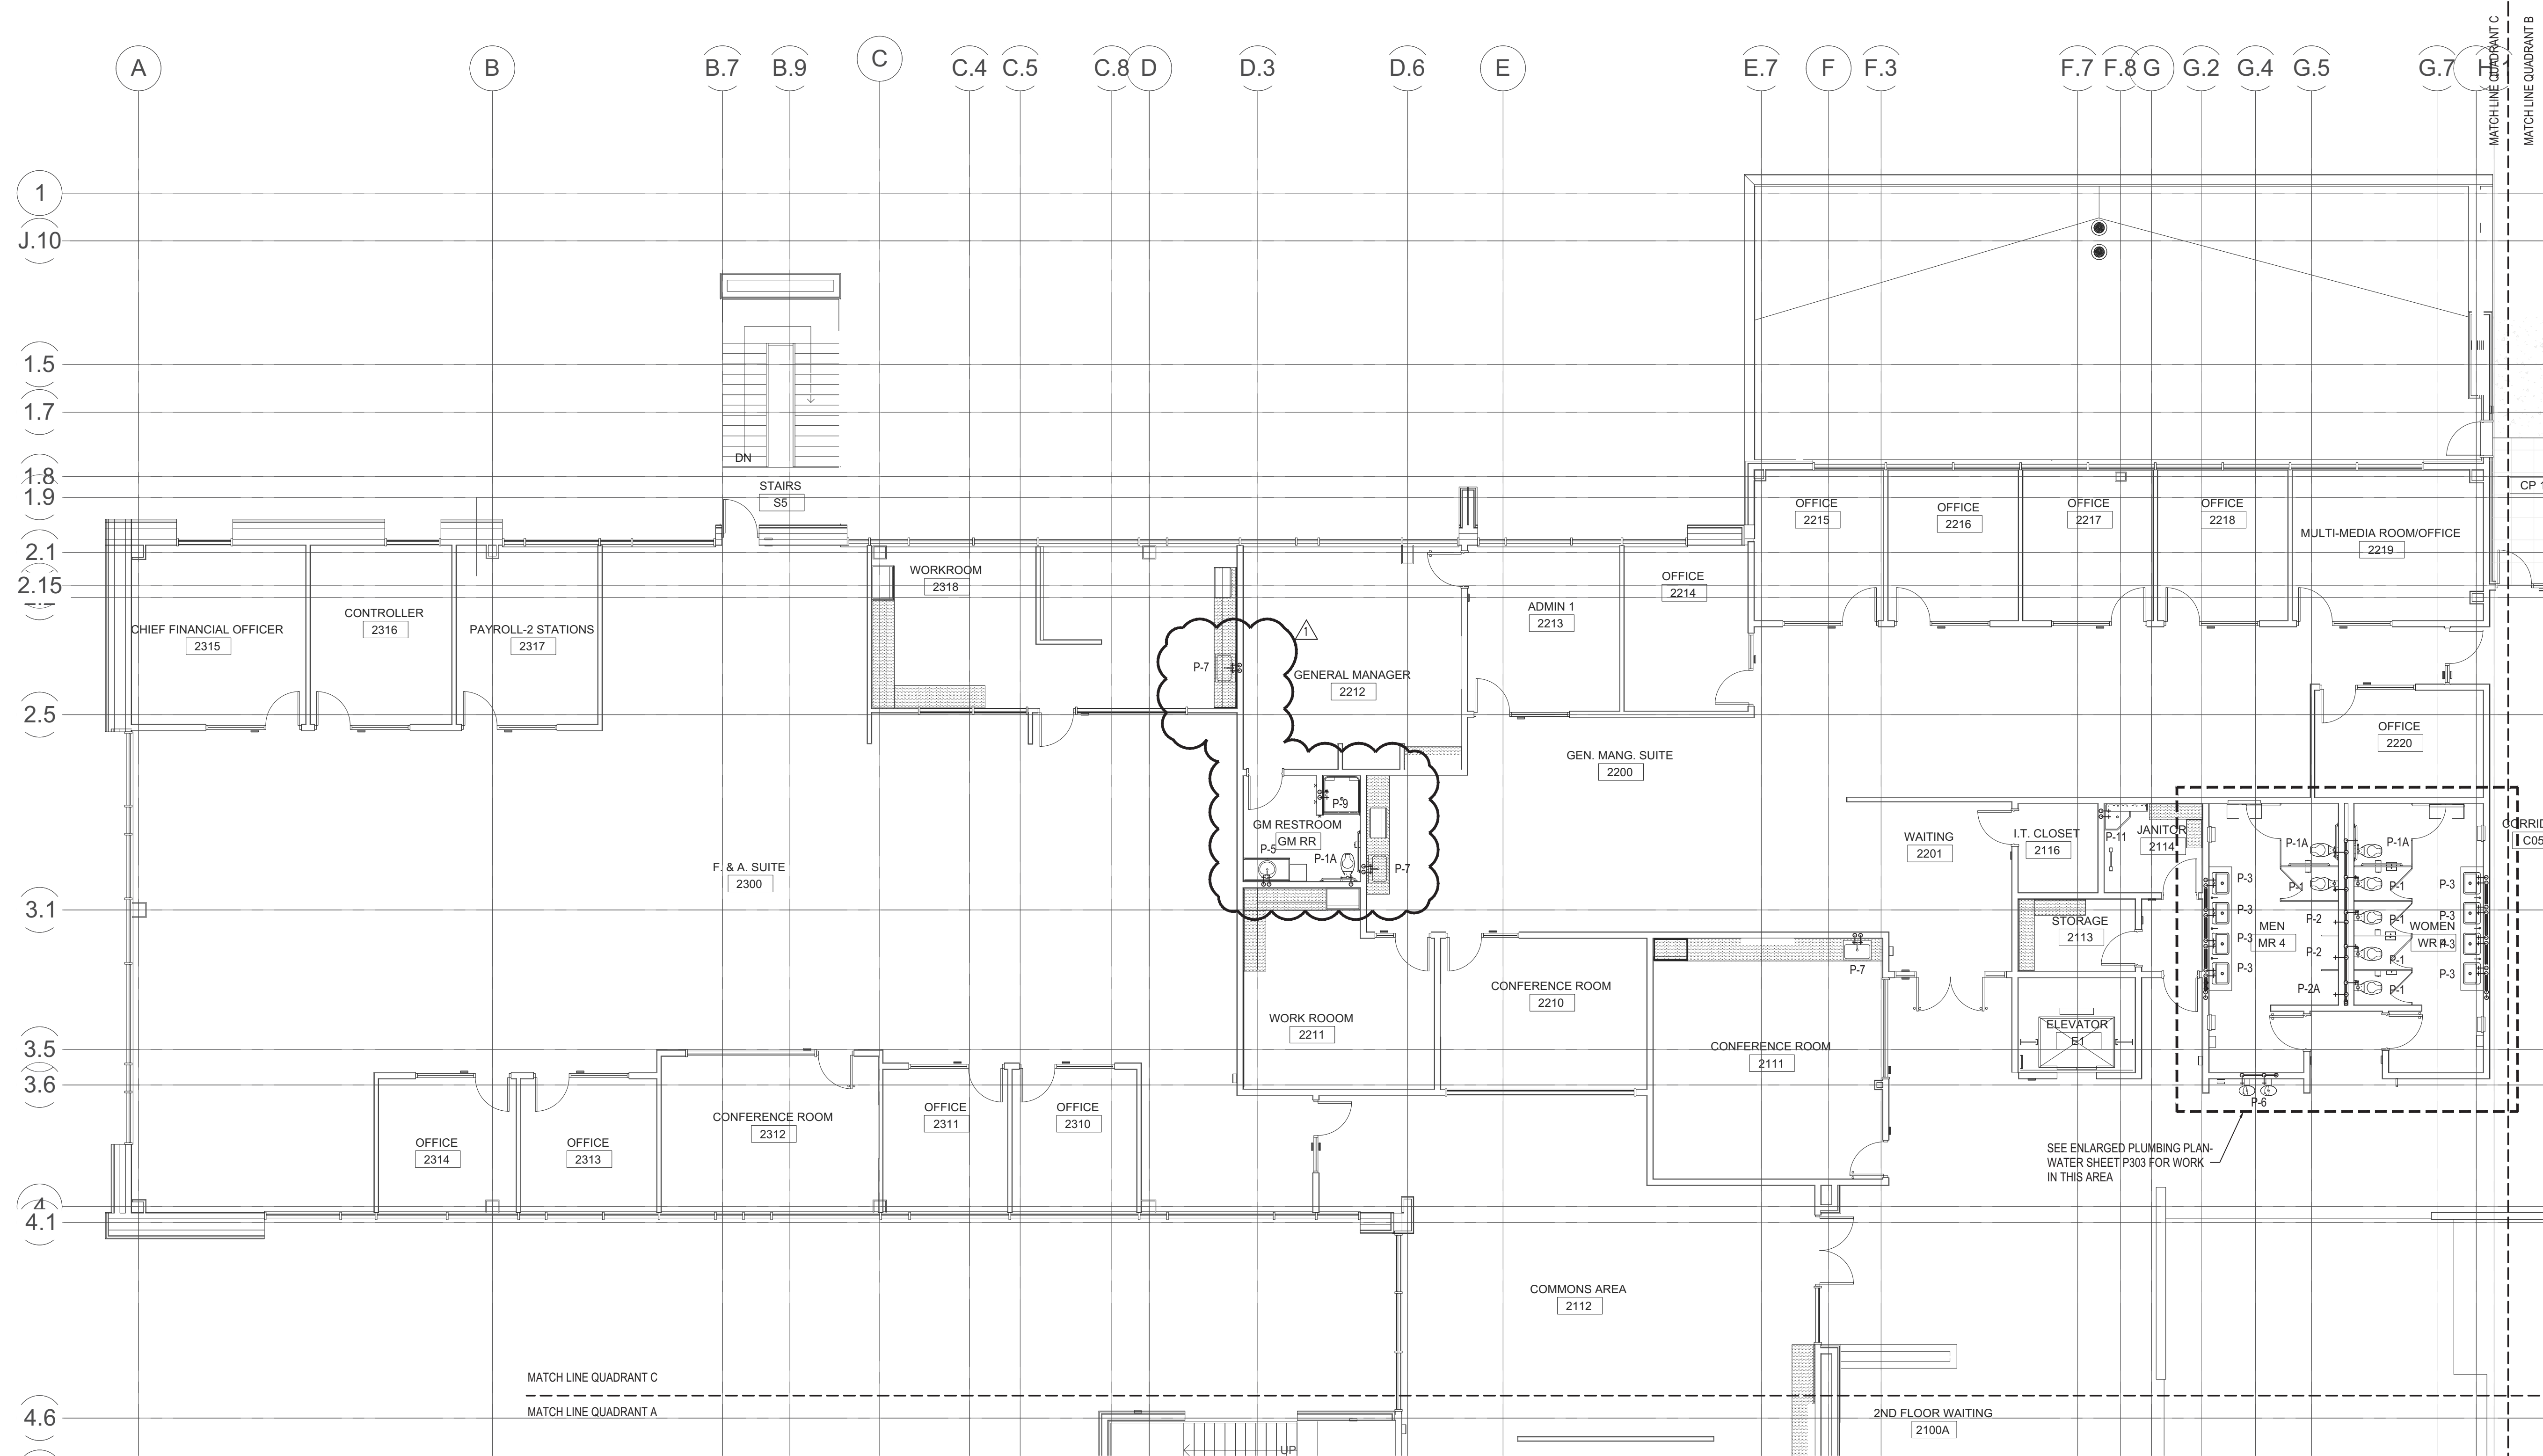

A6 PLUMBING 2nd FLOOR PLAN - QUADRANT C - WATER
1/8" = 1'-0"



DYRON MURPHY ARCHITECTS, P.C.



Revision Schedule		
Revision Number	Revision Date	Revision Description
1	11/10/16	ADD. 03

PROJECT NUMBER 2015.05	DRAWN BY HRM	PROJ MGR BA
RVT FILE		

Sheet Number

P112c

Sequence of

PLUMBING 2nd FLOOR PLAN - QUADRANT C - WATER

6 5 4 3 2 1


E

D


C

B

A

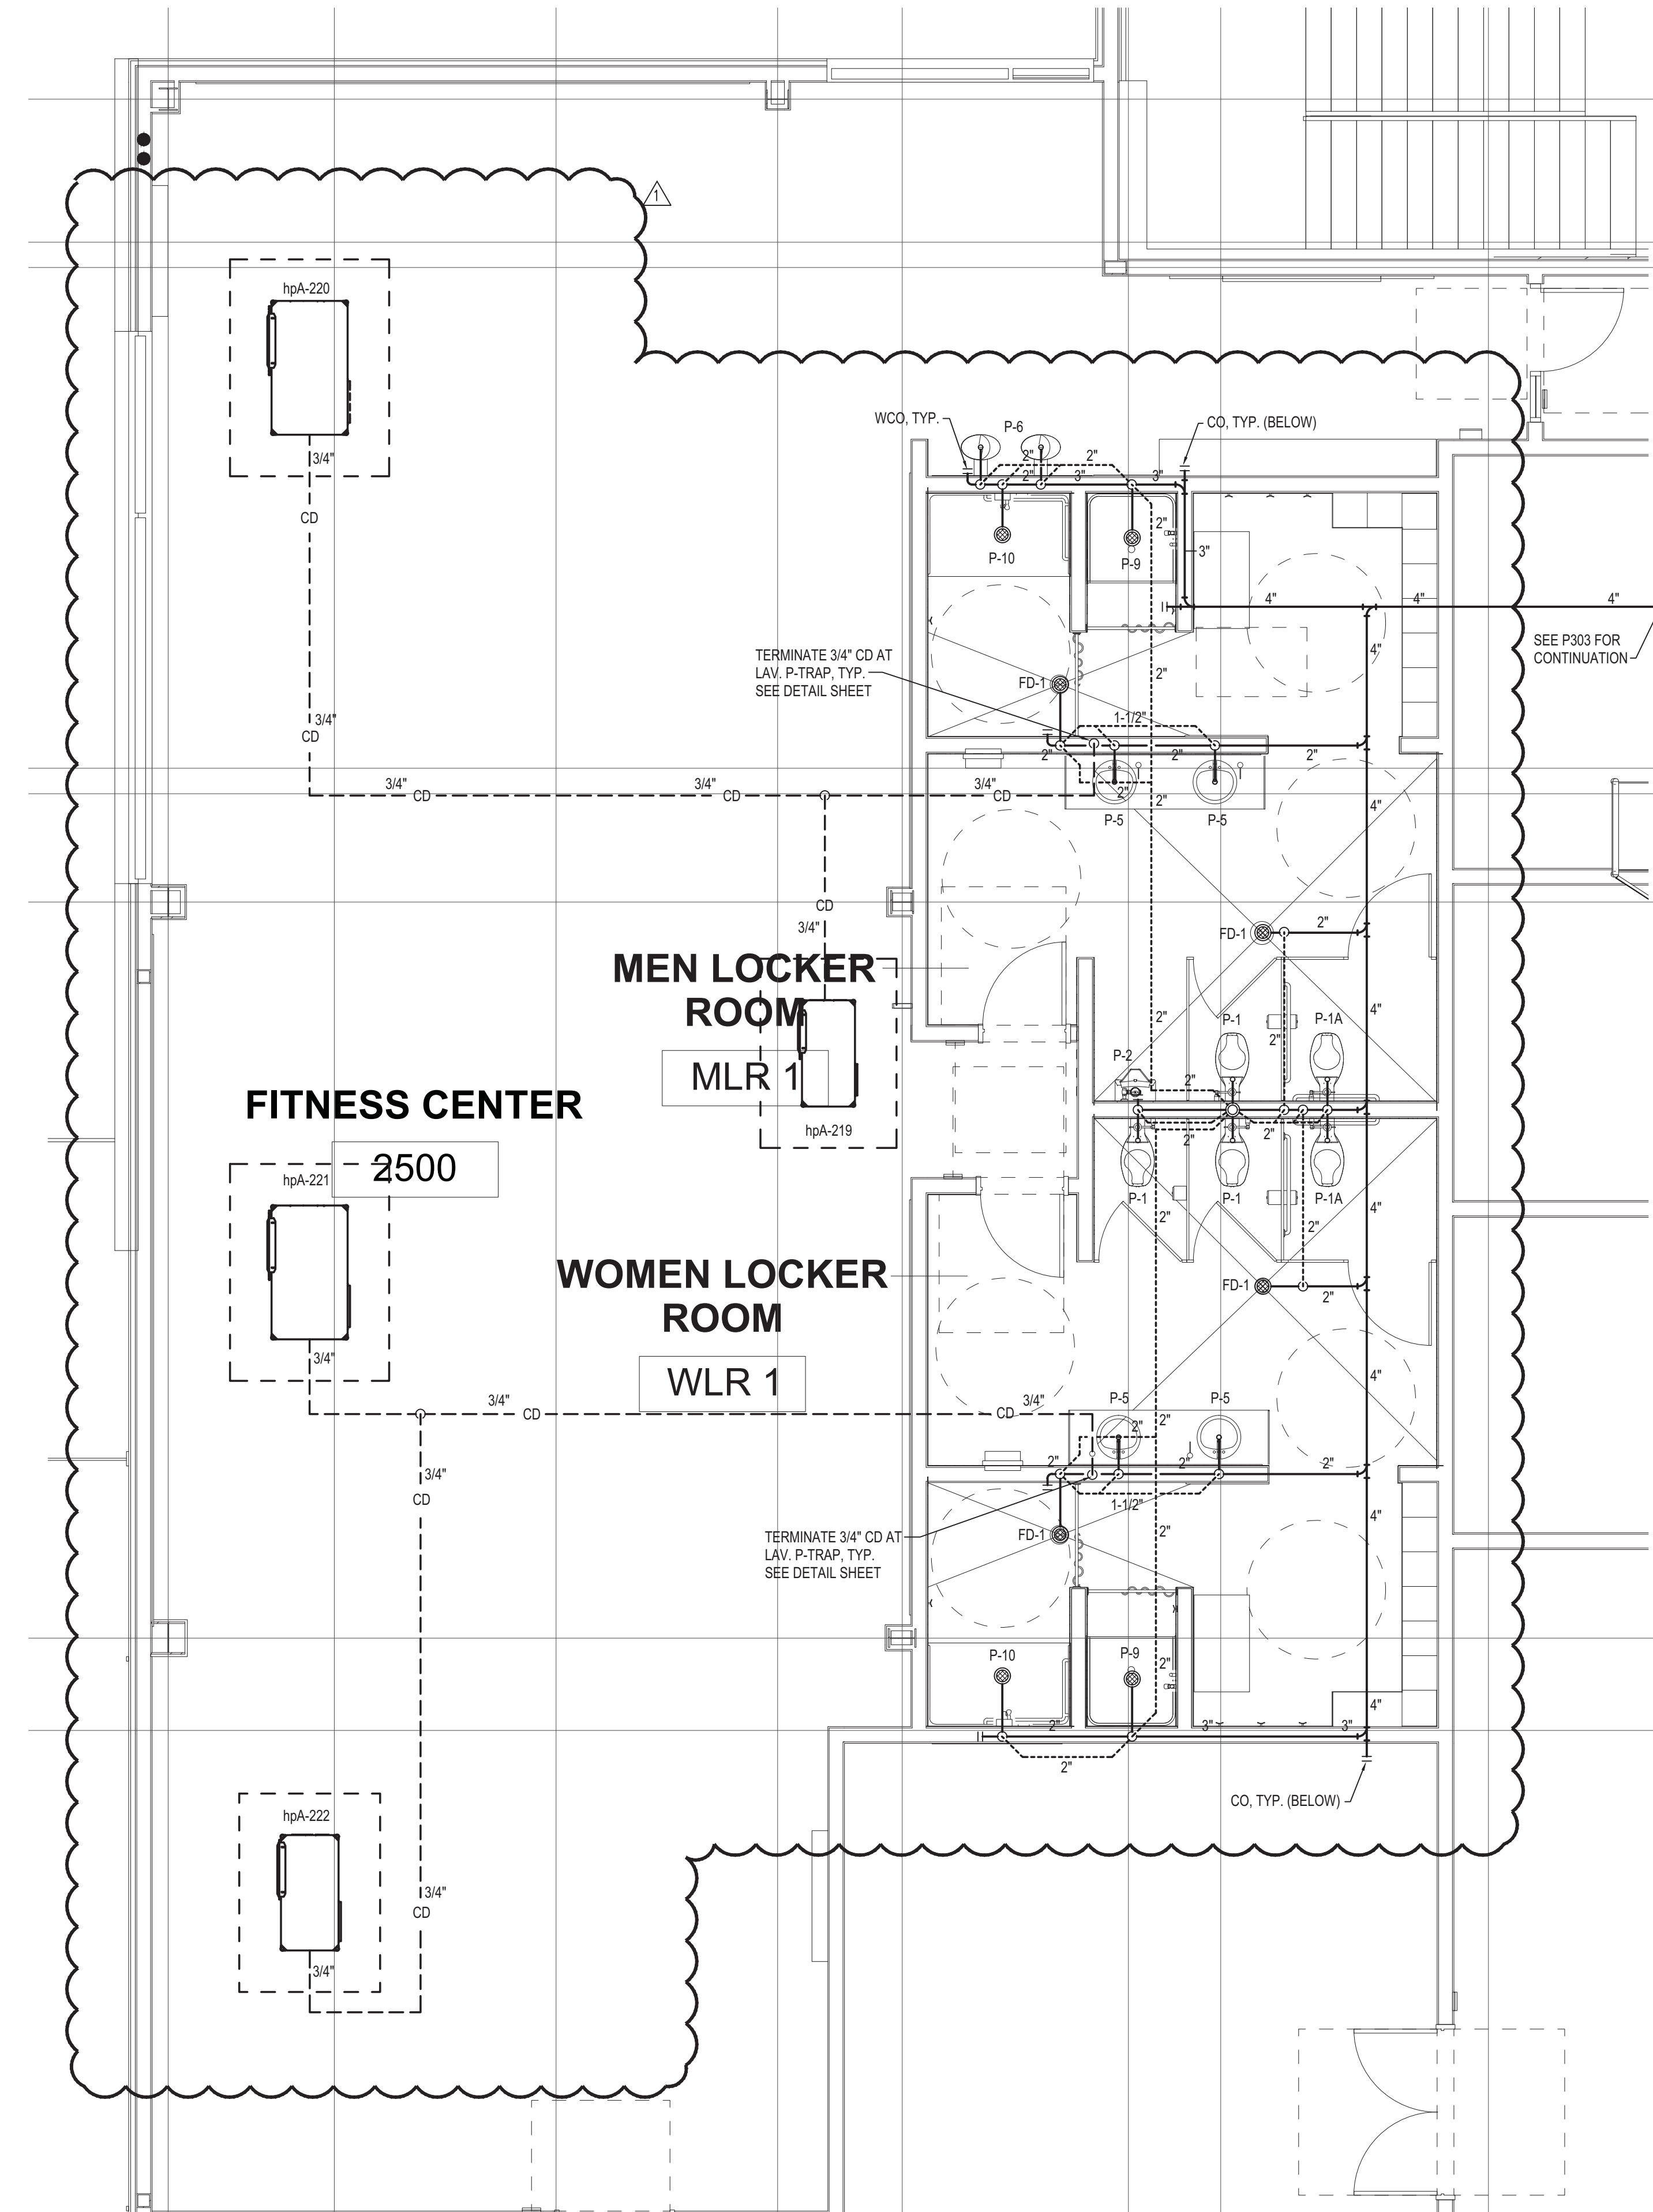


A6 ENLARGED PLUMBING 1ST FLOOR PLAN - WASTE & VENT
1/4" = 1'-0"

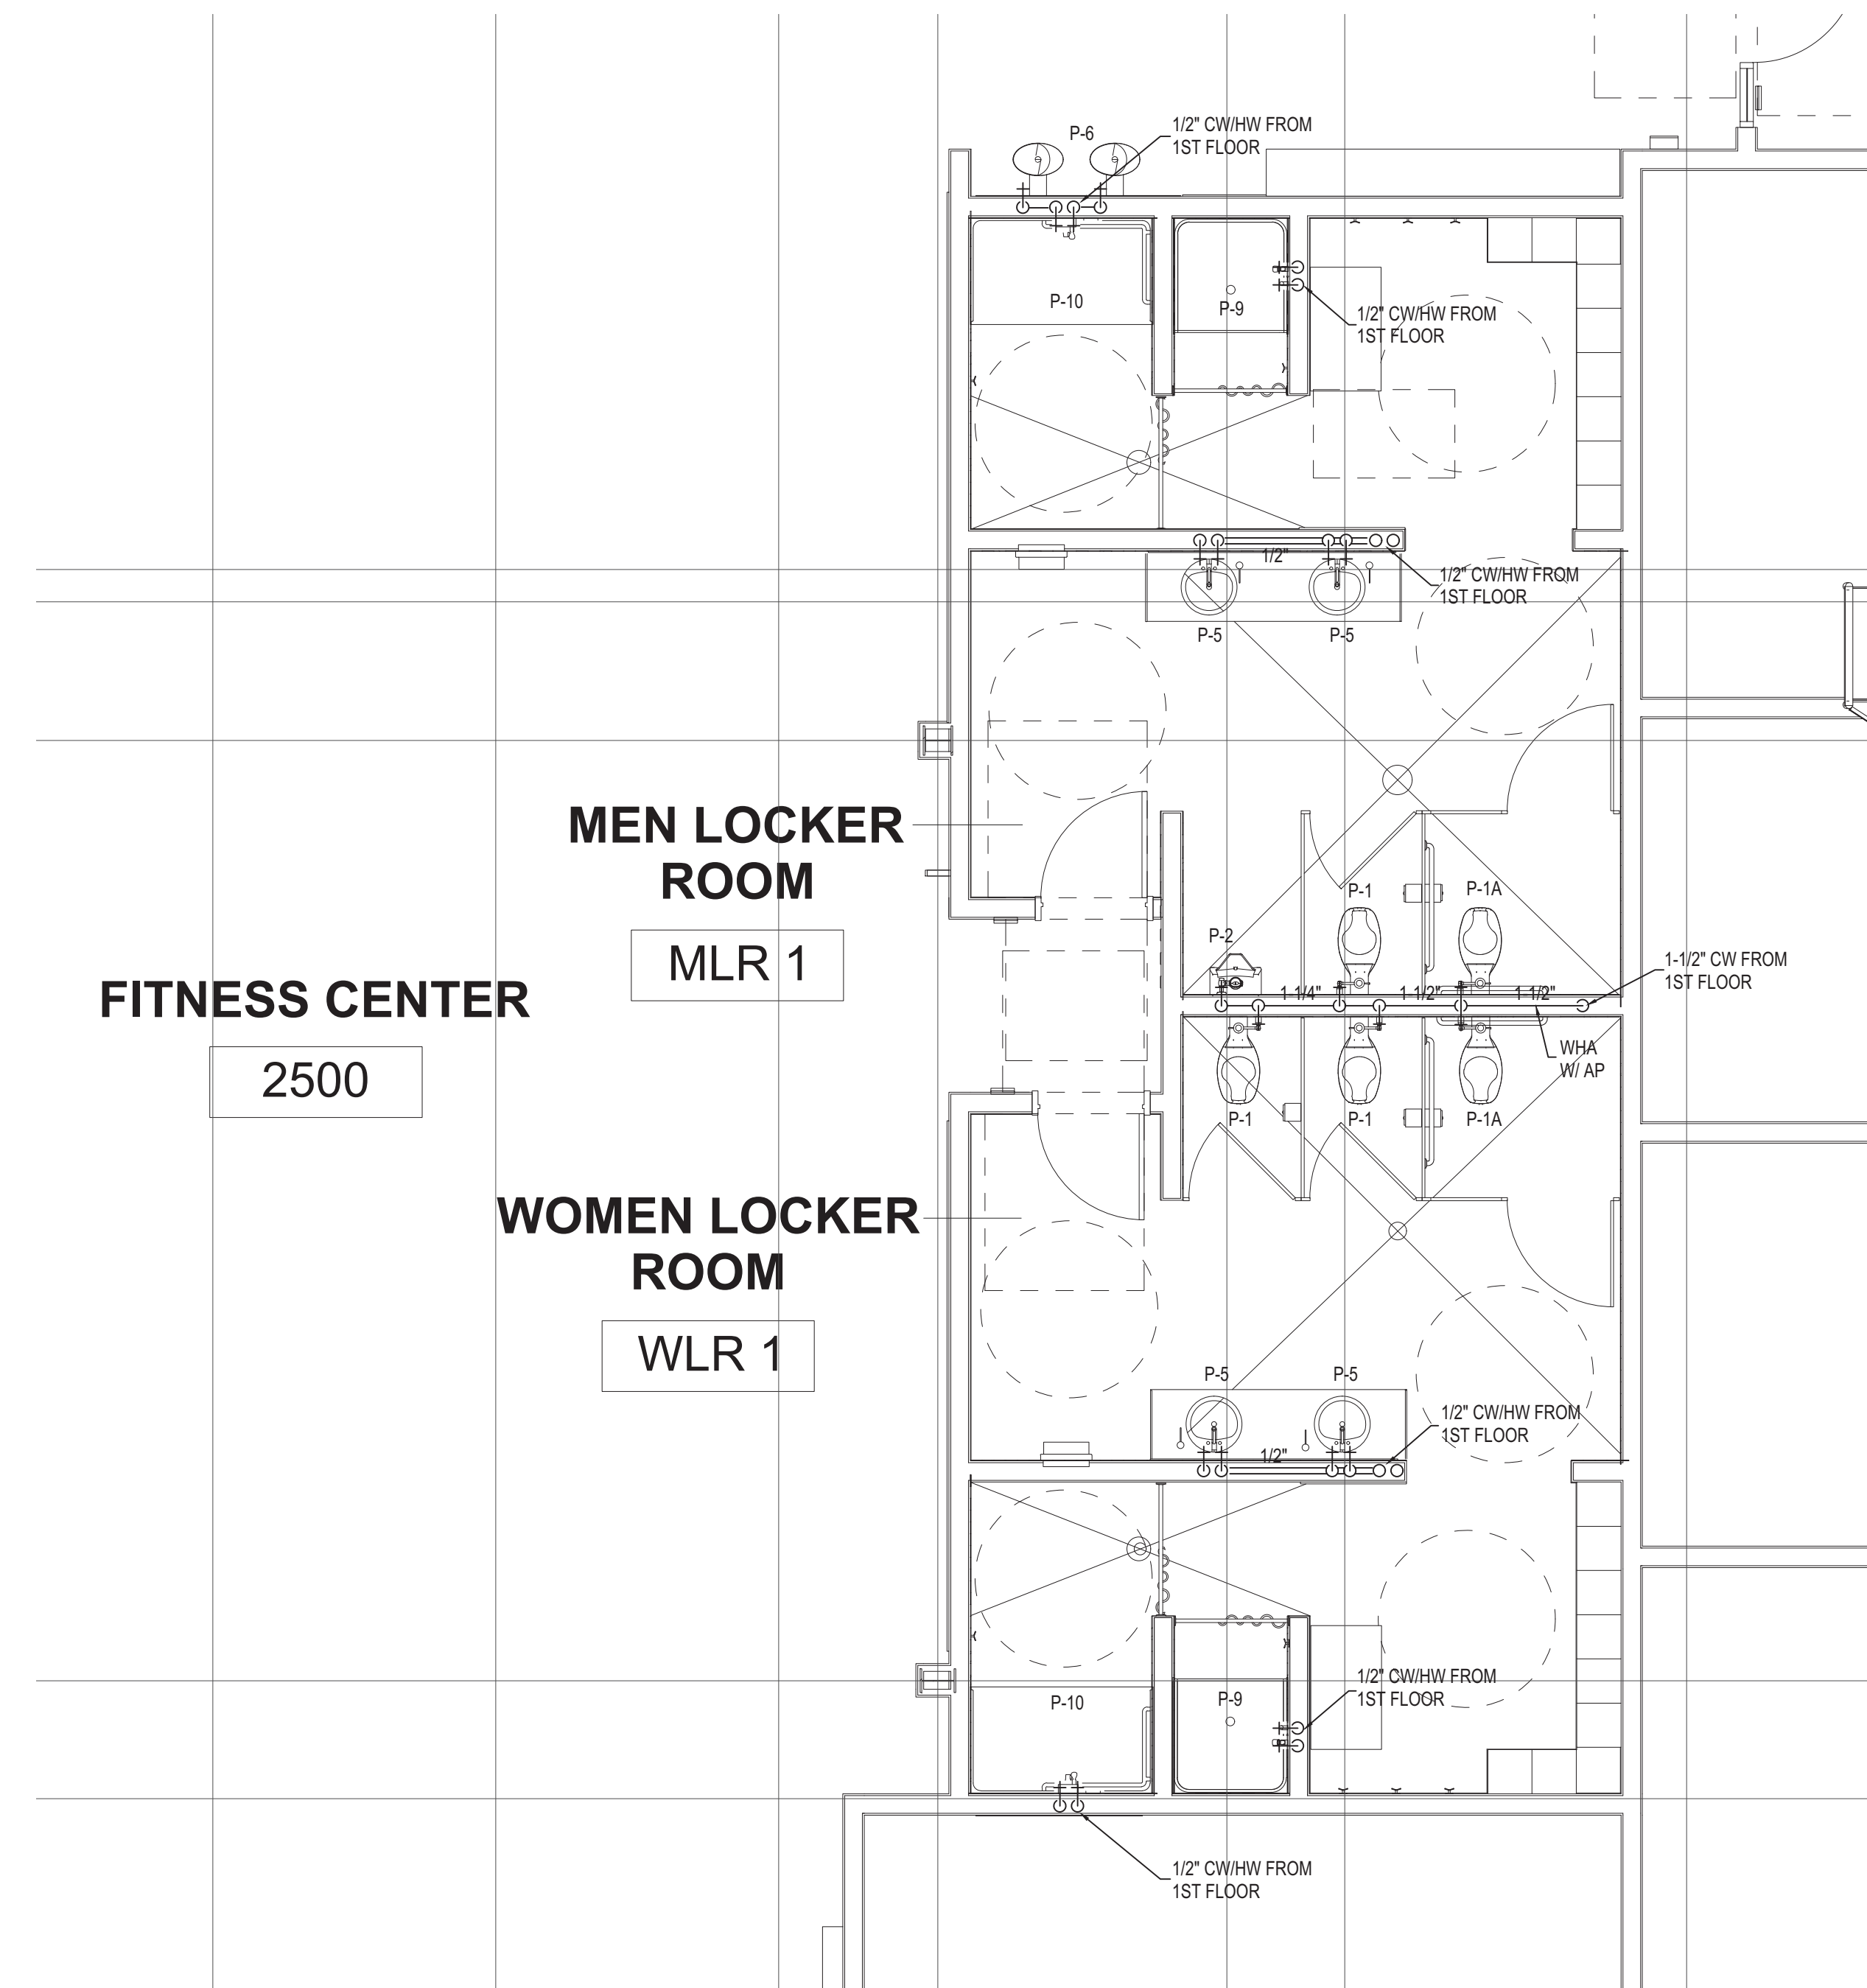

A3 ENLARGED PLUMBING 1ST FLOOR PLAN - WATER
1/4" = 1'-0"



DYRON MURPHY ARCHITECTS, P.C.

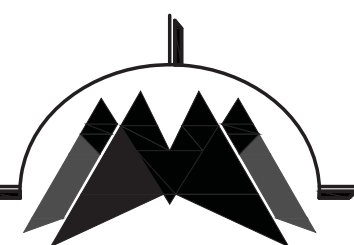

4505 Montbel Place NE, Albuquerque, New Mexico 87107



ENGINEER

Revision Schedule		
Revision Number	Revision Date	Revision Description
1	11/10/16	ADD. G3

PROJECT NUMBER 2015.05	DRAWN BY HRM	PROJ MGR BA
RVT FILE		

Sheet Number

P304

Sequence of

ENLARGED PLUMBING
FITNESS CENTER PLANS
ALTERNATE 2

6

5


4

3

2

1


E
D
C
B
A

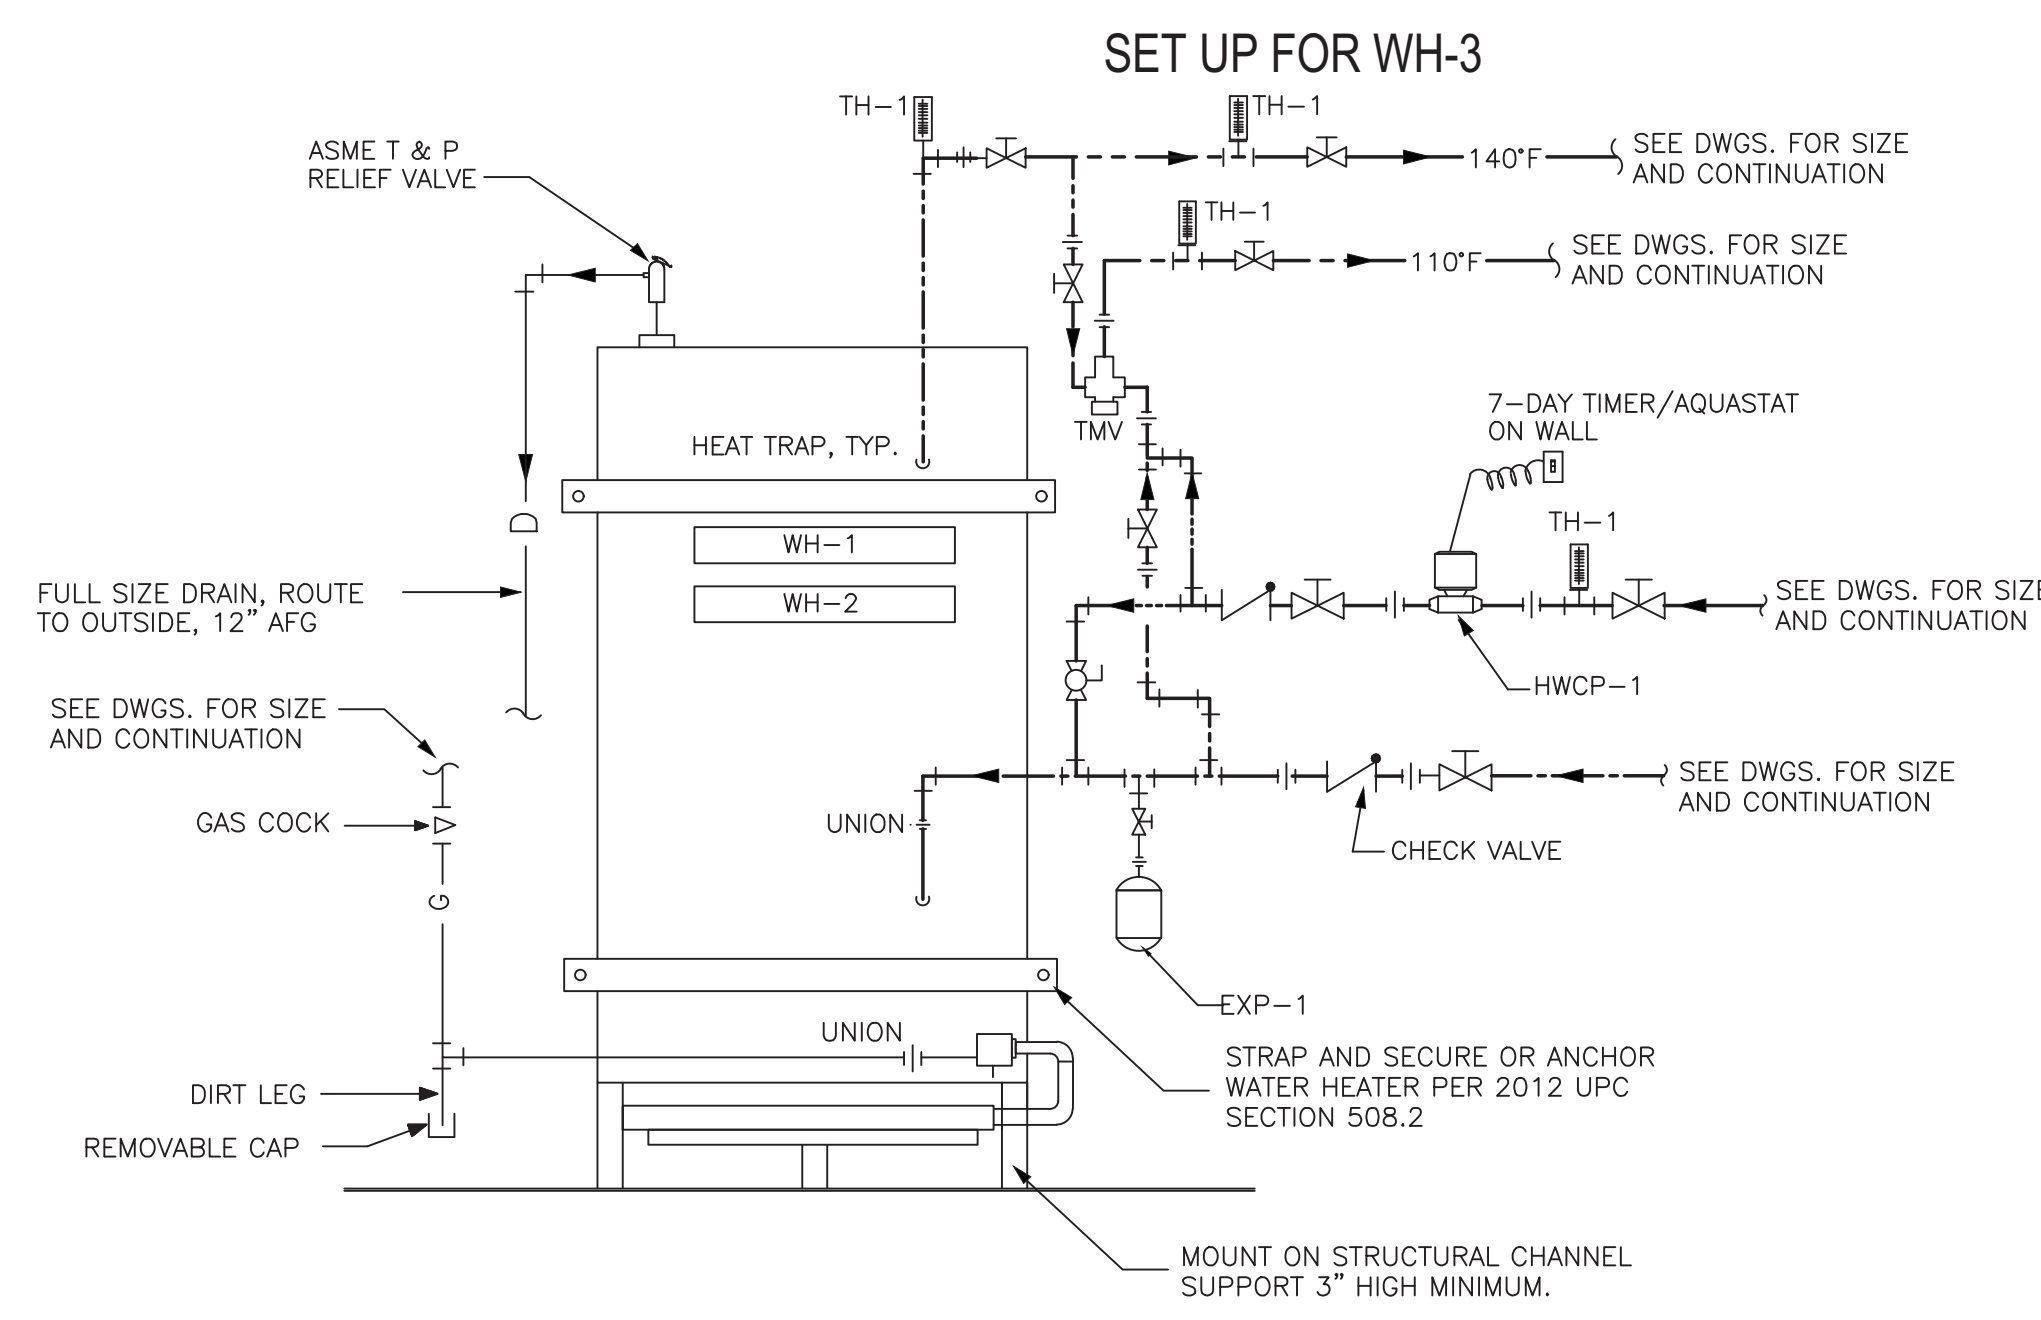

WH-3 SIMILAR


SCHEDULE	
SYMBOL	DESCRIPTION
TH-1	THERMOMETER: WEISS "VARI-ANGLE", 9" CASE, 3-1/2" ELEMENT SEPARABLE SOCKET WITH IMMERSION WELL, 30°-300° F SCALE RANGE FOR HEATED WATER.

DOMESTIC WATER HEATER DETAIL
NOT TO SCALE (SEE PLANS FOR PIPE ROUTING & SIZES)

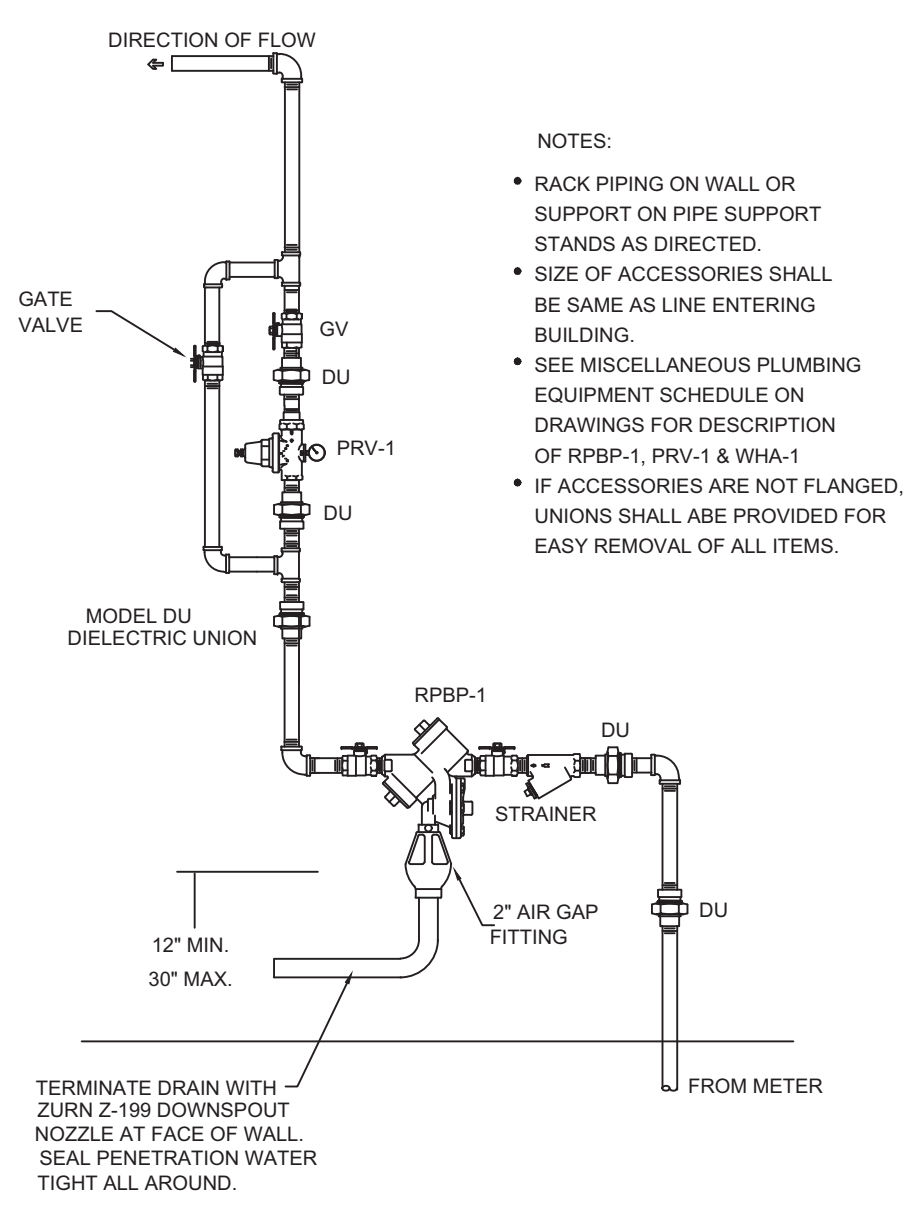


SCHEDULE	
SYMBOL	DESCRIPTION
PG-1 AND PG-2	PRESSURE GAUGE 0-100 PSIG Range


DOMESTIC WATER SERVICE ENTRY
NOT TO SCALE (SCHEMATIC)

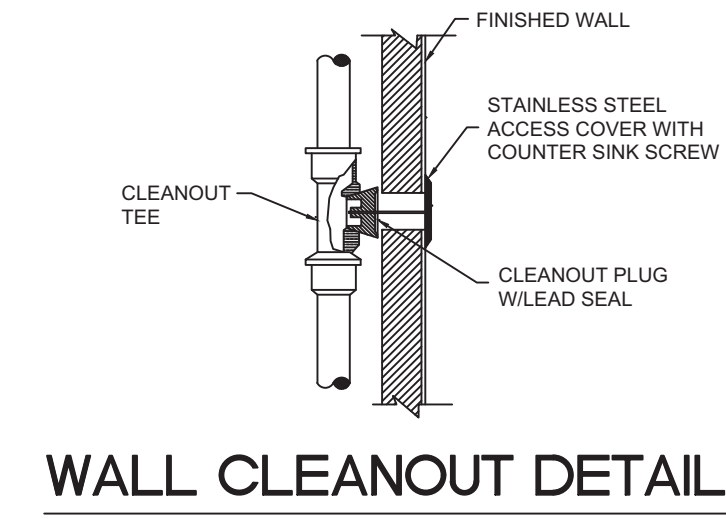

WALL CLEANOUT DETAIL
NOT TO SCALE

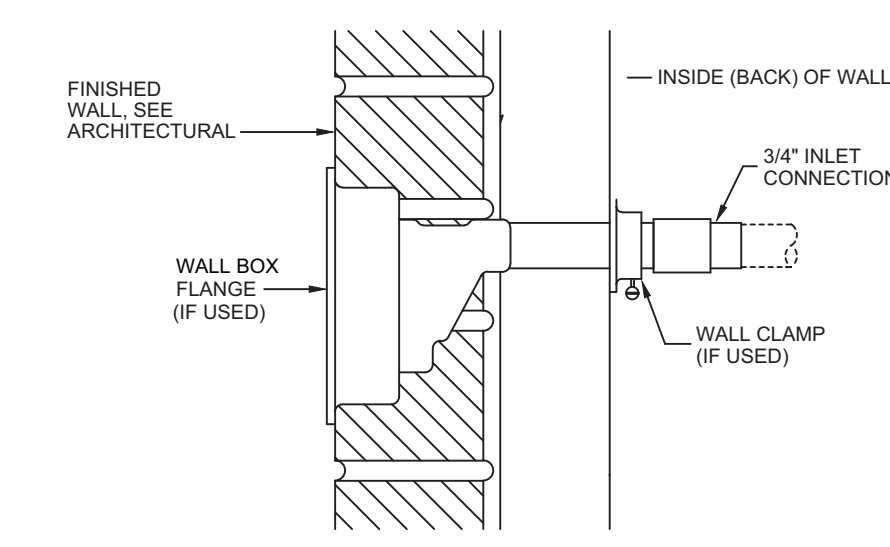


FREEZEPROOF WALL HYDRANT DETAIL
NOT TO SCALE

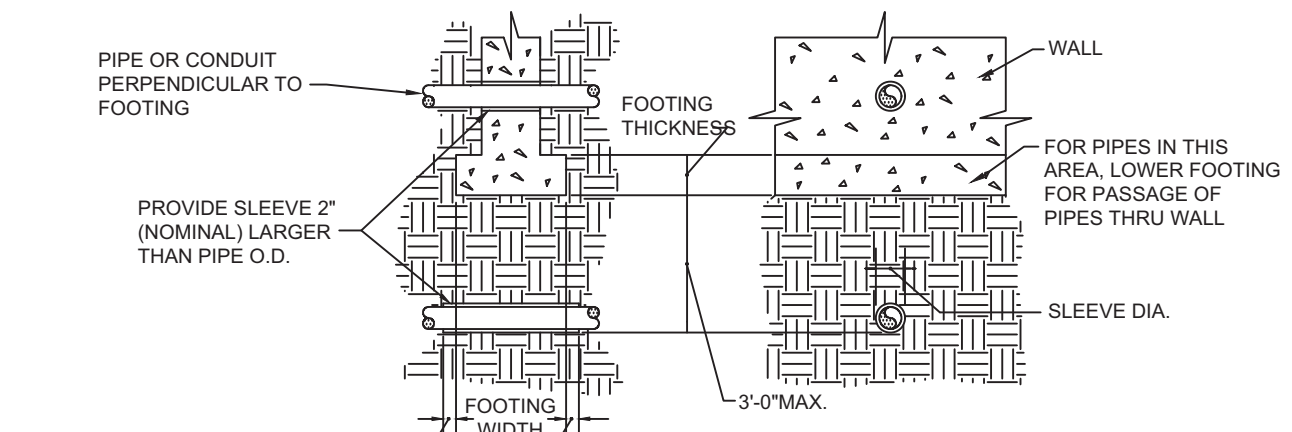


- NOTES:
- FOR PIPES 3"-0" OR LESS BELOW FOOTING, PROVIDE SLEEVES AS SHOWN.
 - FOR PIPES AND CONDUITS MORE THAN 3'-0" BELOW FOOTING, PIPE SLEEVE MAY BE ELIMINATED.
 - COORDINATE WITH ELECTRICAL, AND ALL OTHER AFFECTED TRADES.

INSTALL OF PIPES PERPENDICULAR TO FOOTING DETAIL
NOT TO SCALE

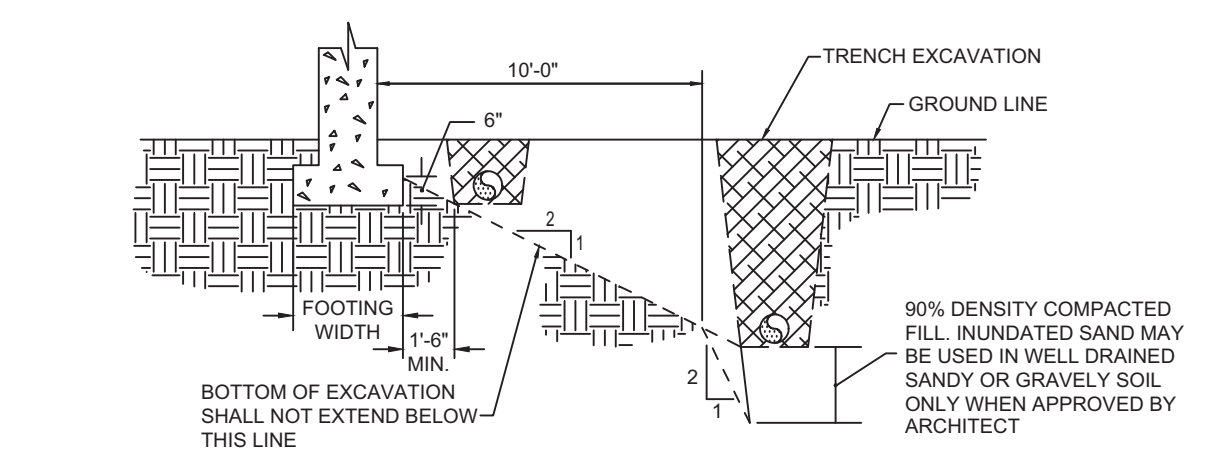


- NOTE:
- THE CONTRACTOR SHALL BE RESPONSIBLE FOR SHORING, SHEATHING, OR OTHERWISE MAINTAINING THE SIDES OF THE EXCAVATION FROM CAVE-IN AND OTHER HAZARDS UNTIL ALL BACKFILL IS COMPLETED. BACKFILL AS PER SPECIFICATIONS.


INSTALLATION OF PIPES PARALLEL TO FOOTING DETAIL
NOT TO SCALE

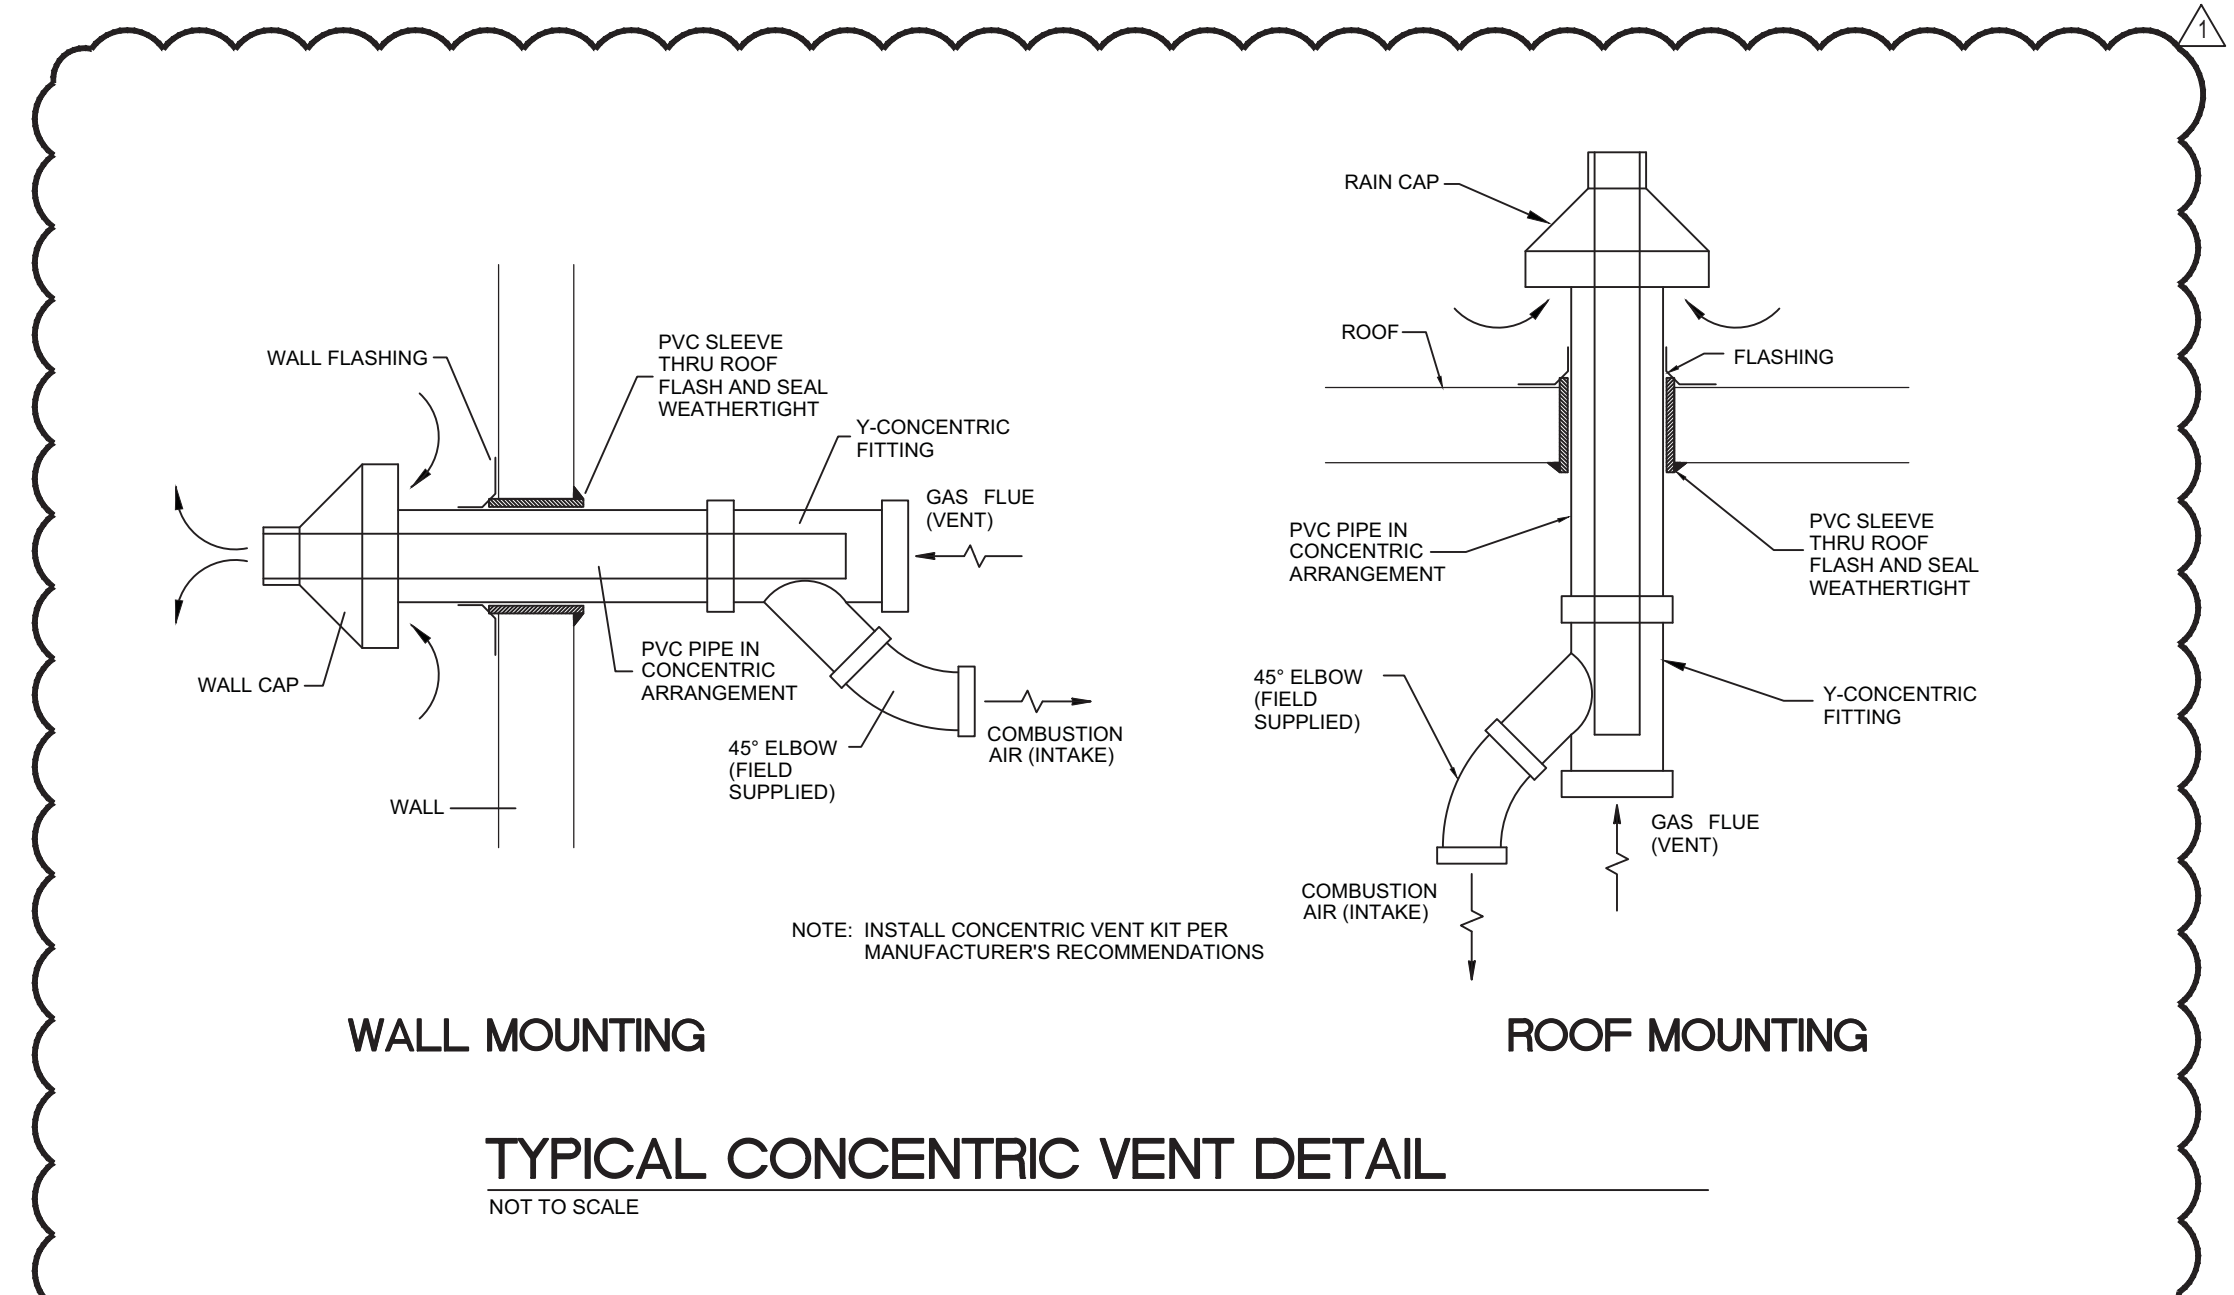


TYPICAL CONCENTRIC VENT DETAIL
NOT TO SCALE

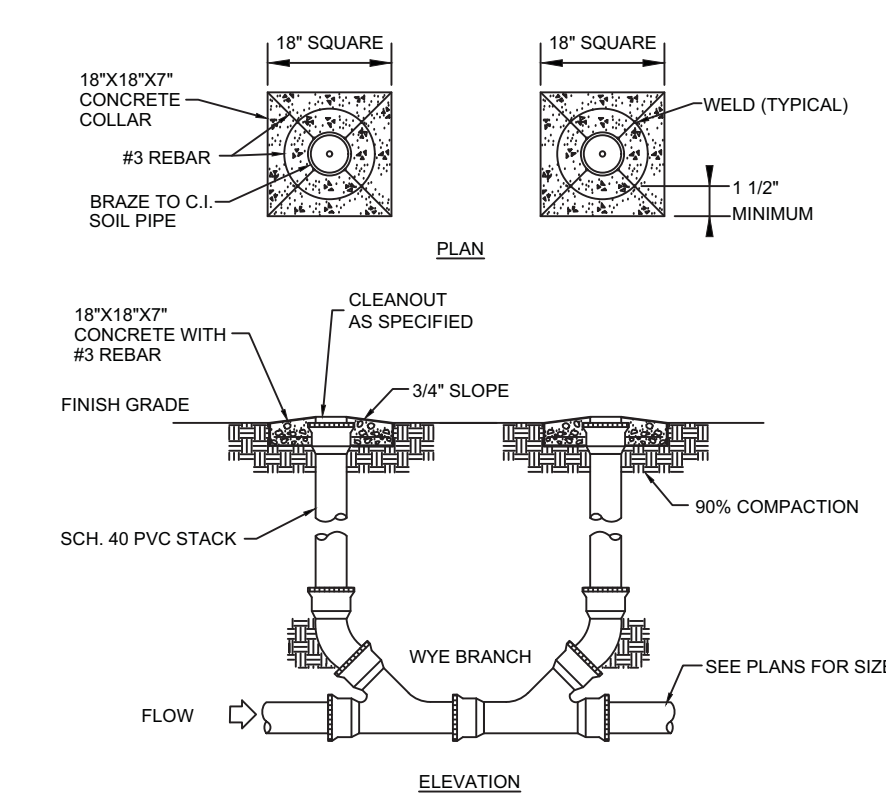



TWO-WAY CLEANOUT DETAIL
NOT TO SCALE

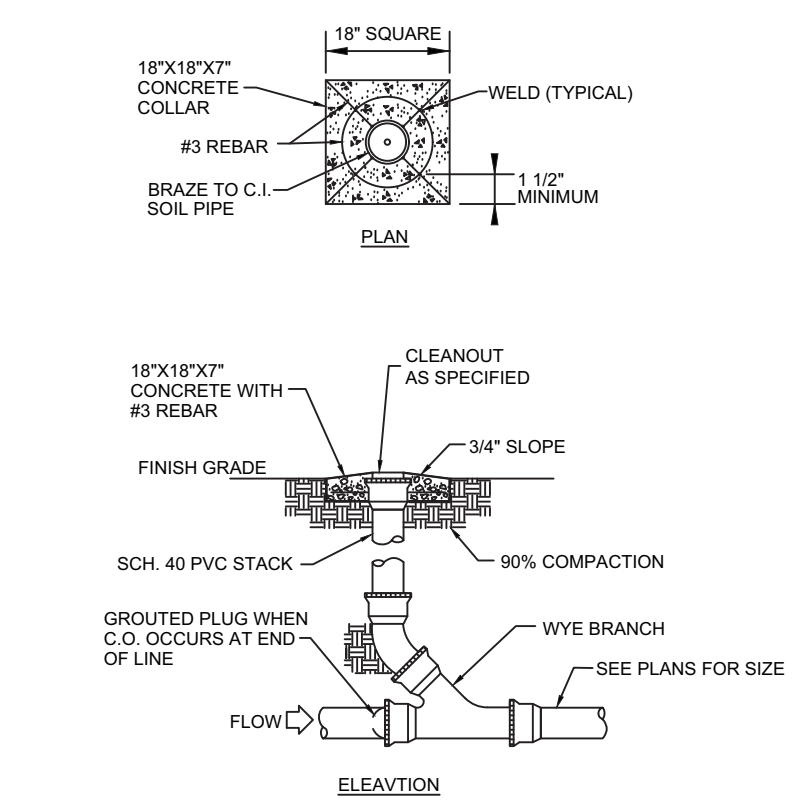


CLEANOUT DETAIL
NOT TO SCALE

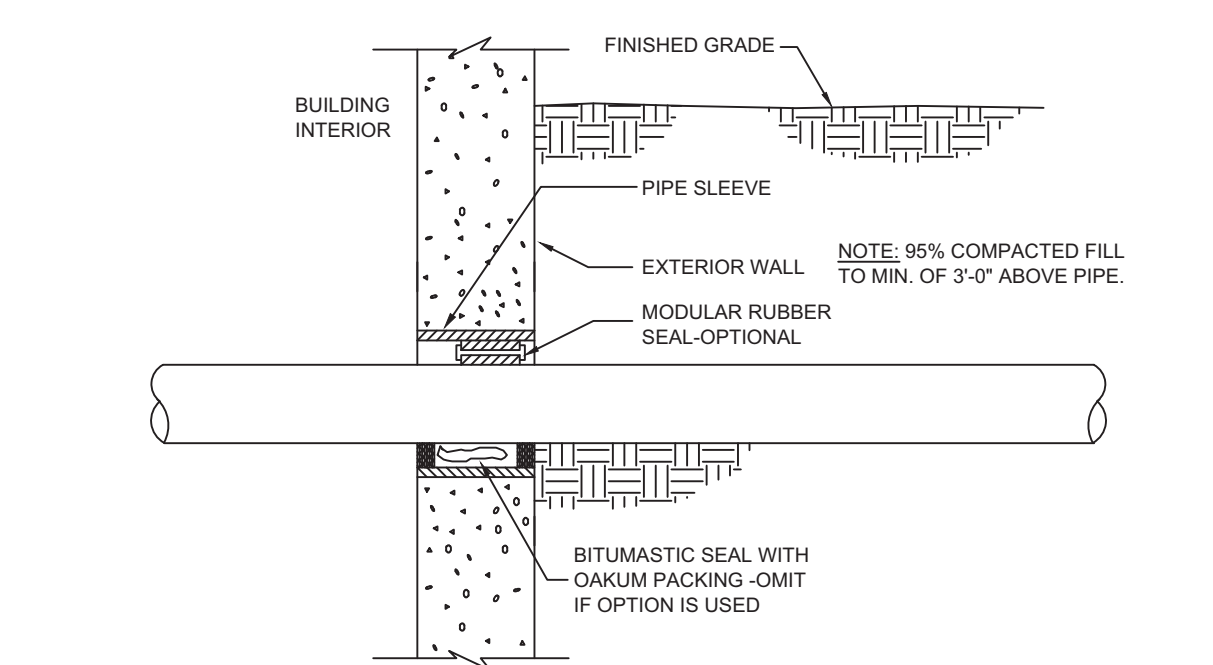


FOUNDATION PENETRATION DETAIL
NOT TO SCALE

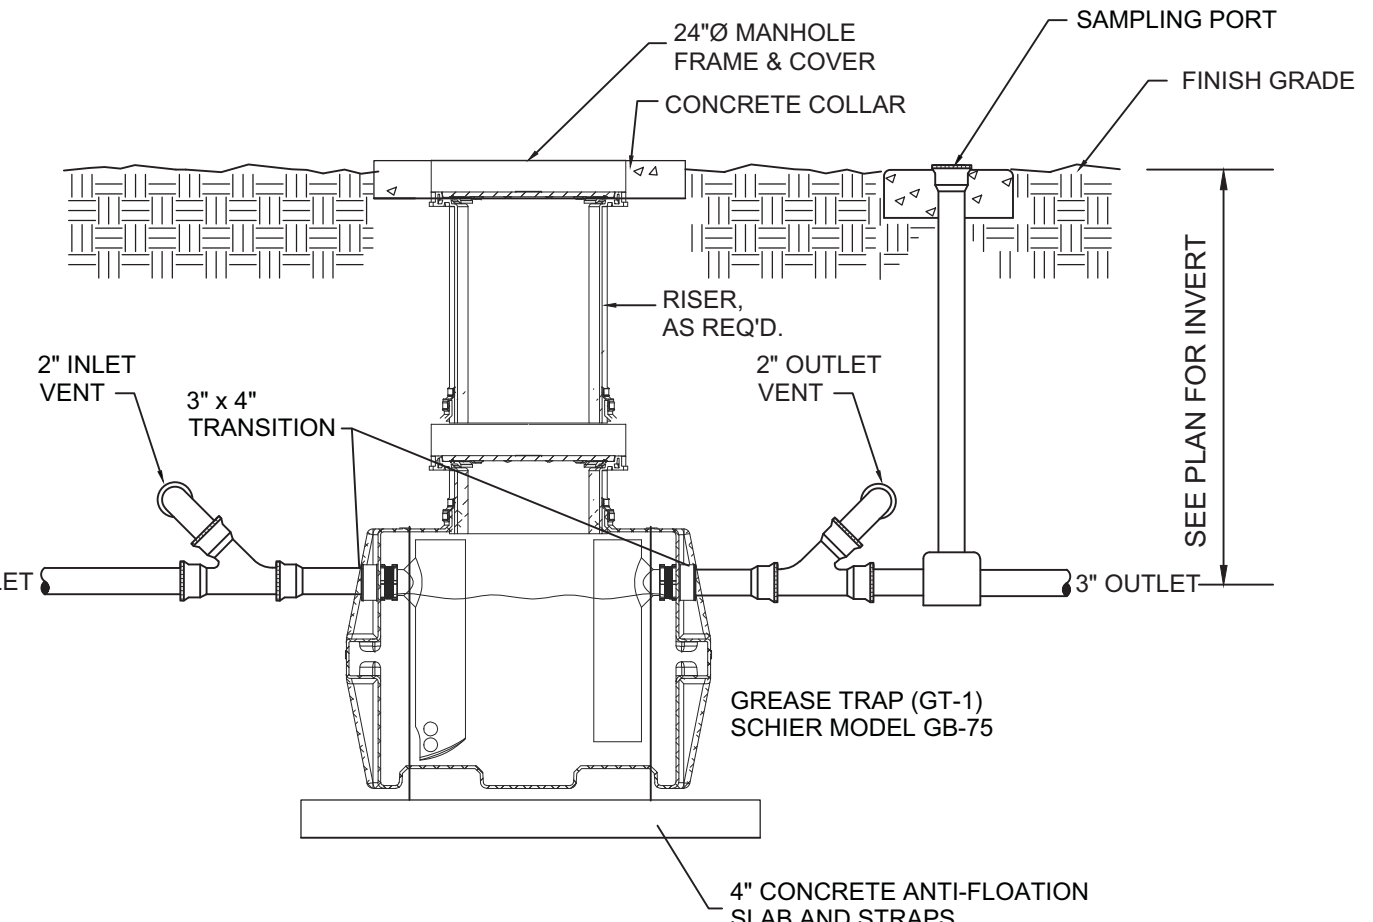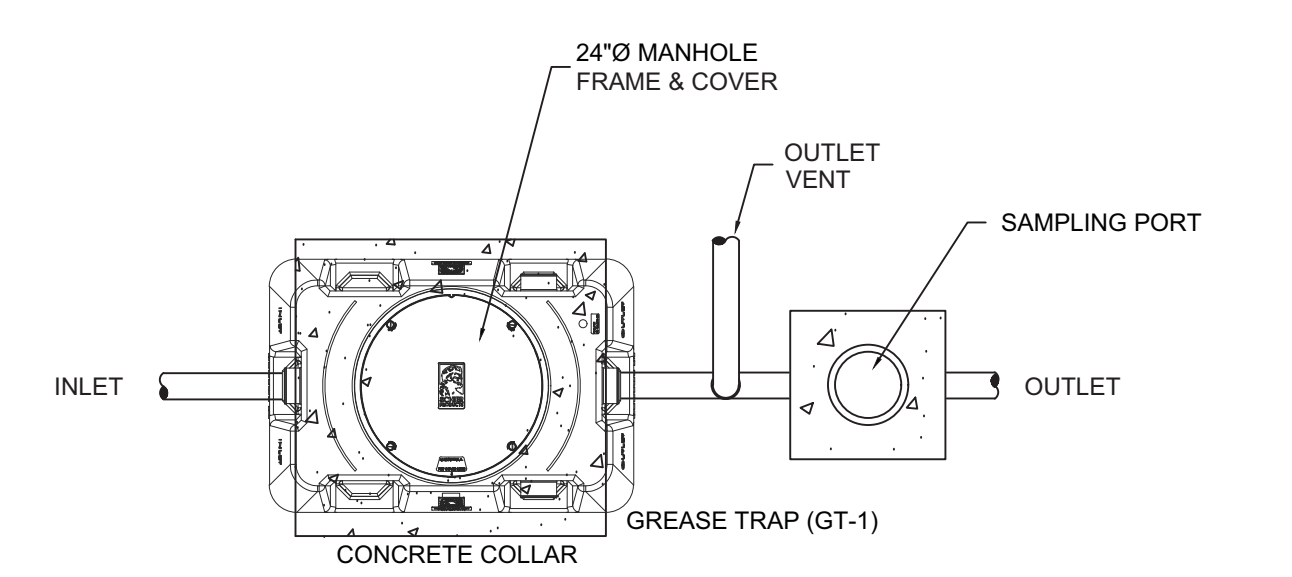


GREASE TRAP DETAIL
NOT TO SCALE

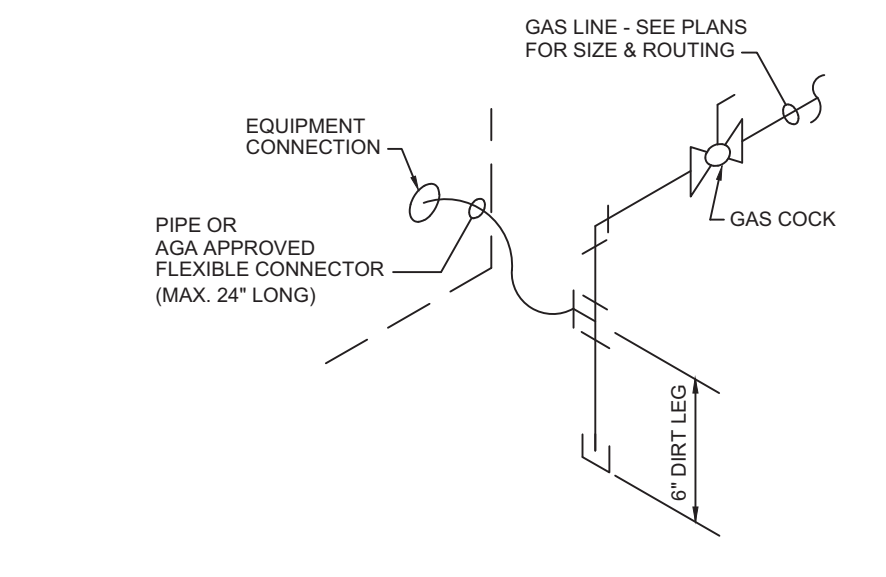


TYP. GAS CONNECTION
NOT TO SCALE

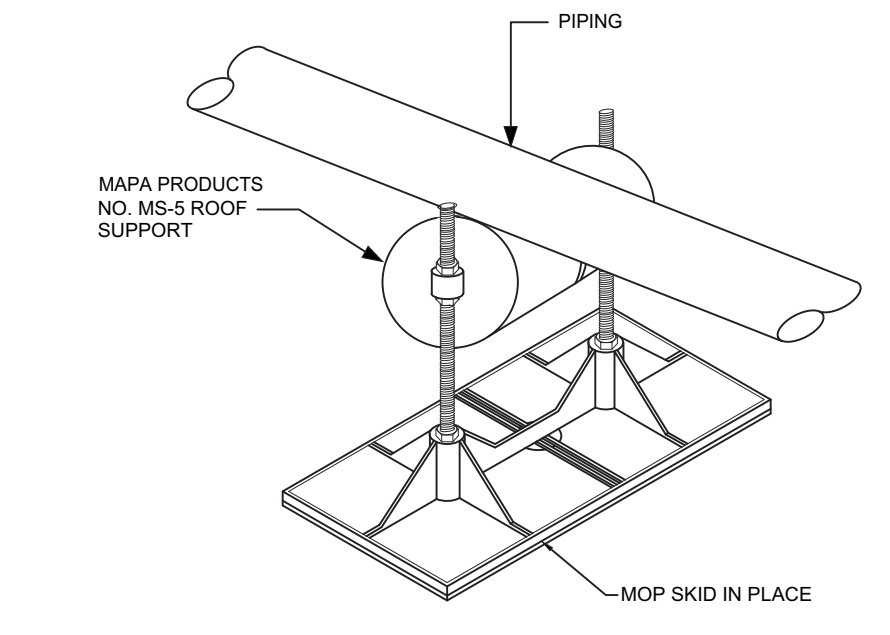


GAS PIPING ROOF SUPPORT
NOT TO SCALE

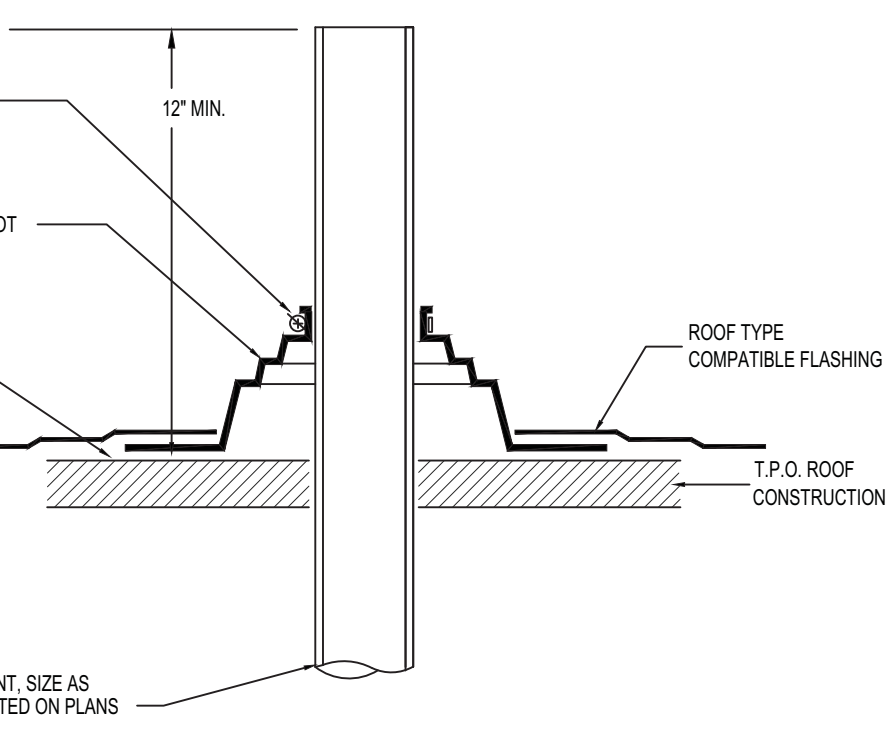


VENT THRU ROOF DETAIL
NOT TO SCALE

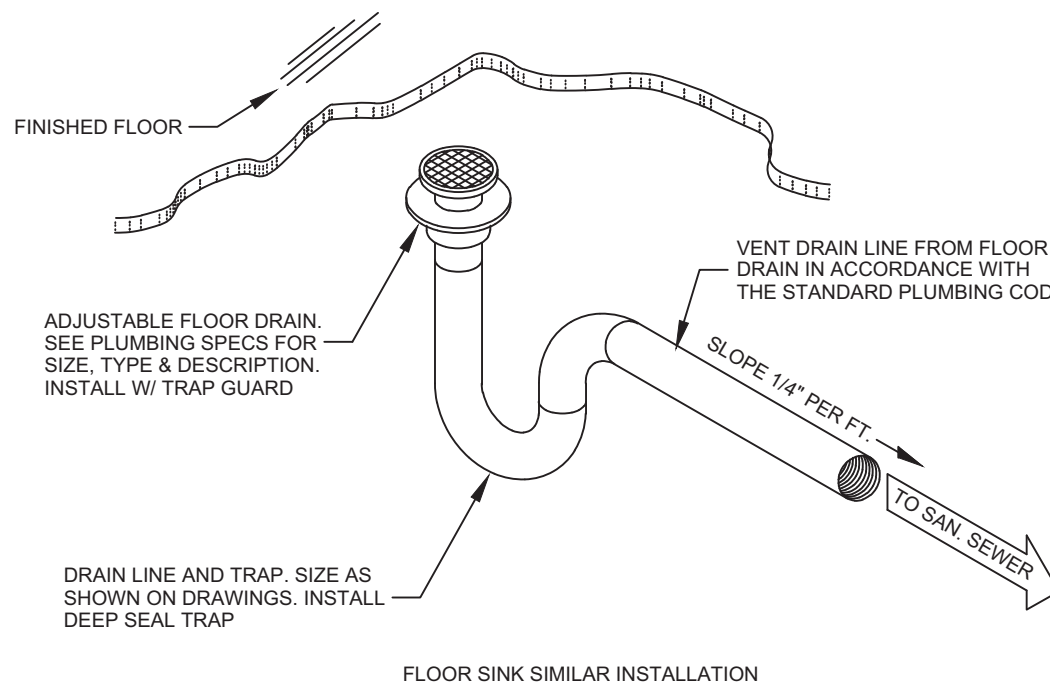

TYPICAL FLOOR DRAIN DETAIL
NOT TO SCALE

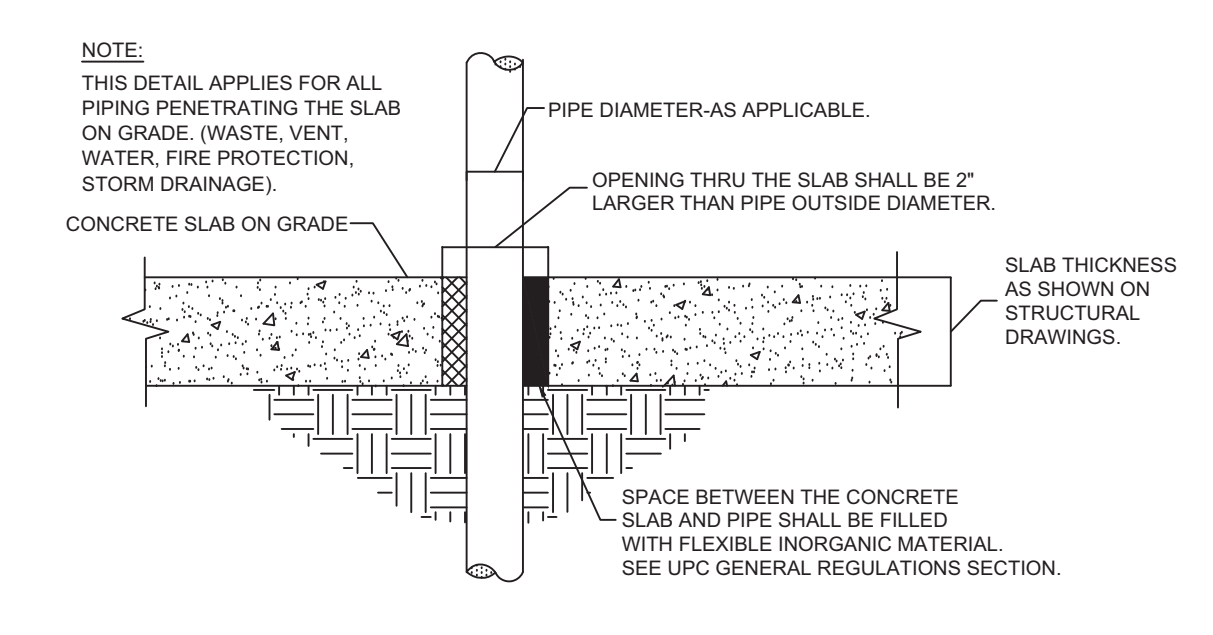

SLAB ON GRADE PENETRATION DETAIL
NOT TO SCALE

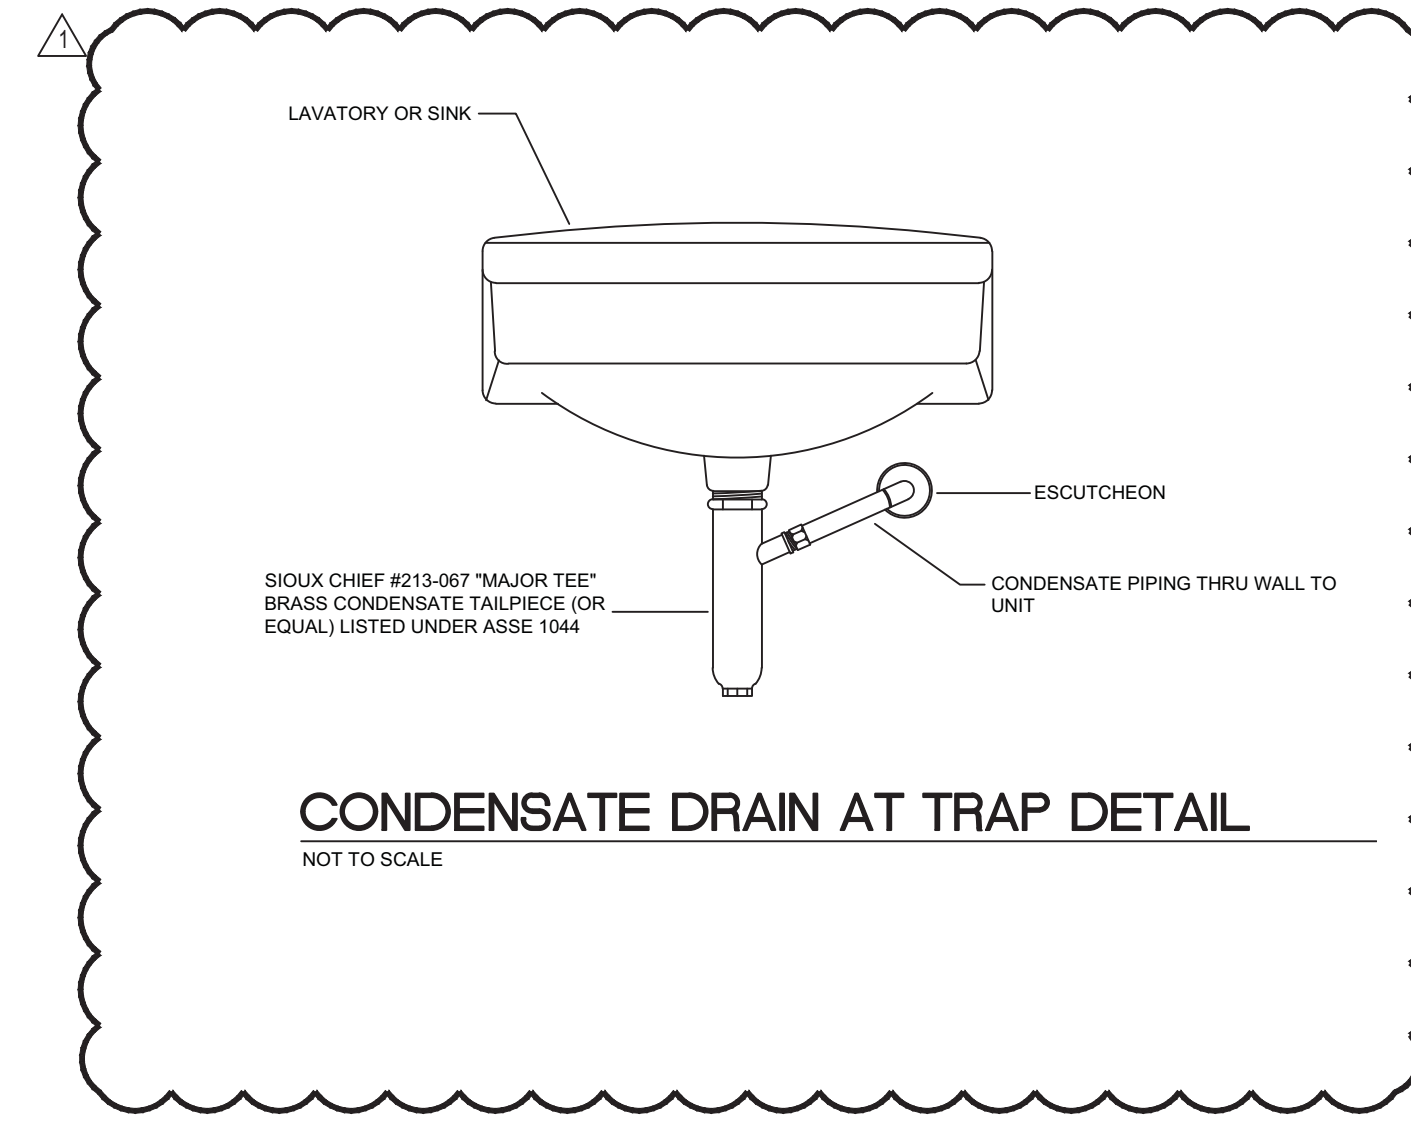

CONDENSATE DRAIN AT TRAP DETAIL
NOT TO SCALE



DYRON MURPHY ARCHITECTS, P.C.



Revision Schedule		
Revision Number	Revision Date	Revision Description
1	11/10/16	ADD. 03

PROJECT NUMBER: 2015.05
DRAWN BY: HRM
PROJ MGR: BA

Sheet Number

P401

PLUMBING DETAILS



Allied Engineering
and Design Inc.

5101 Coors Blvd. NW
Suite "F"
Albuquerque, New Mexico 87120
(505)262-1766
(505)255-0466 fax

November 10, 2016

DYRON MURPHY ARCHITECTS, P.C.
4505 Montbel Place NE
Albuquerque, NM 87107

ATTN: OSCAR TOVAR,
ASSOC. AIA, SR. PROJECT MANAGER

RE: NTUA HQ COMPLEX OFFICE BUILDING
ADDENDUM #3
AEDI #50-15

Dear Mr. Tovar:

The following electrical questions and/or clarifications need to be included in an Addendum for the above referenced project:

ELECTRICAL

13. The light fixtures "WE", "GE", "S", "N24", "N24E", "N40" and "U12" are found on the drawings but not on the light fixture schedule. Please advise. Please see additional fixtures below.

14. Will any electrical details be provided? Refer to Electrical Drawings for details.

15. On sheet E501 note 17 says to coordinate rough-in and trenching requirements. What are these requirements? See General Notes on Drawing E001. All trenching to be by Electrical Contractor per NTUA Standards; all primary and telephone conduits, pull boxes to be provided and installed by NTUA.

16. Is the electrical contractor required to provide site concrete primary line volts? No, all primary conduits, cabling, etc. to be by NTUA.

17. Who is providing the VFD's on sheet E103a? No specs could be found. Refer to Mechanical/Plumbing Drawings for VFD information.

18. On sheet E501, are the feeders, 225KVA transformer, 600a disconnect and 3 section panel part of the bid alt? They are not stated as a bid on the one-line. The feeders, 225KVA transformer, 600a disconnect and 3 section panel are to be included in Alt. No. 1 Kitchen Bid. The 350A circuit breaker in "MDP" to be provided under Base Bid.

Electricians are inquiring about duct bank. I have not seen any indication of a duct bank on this project. Please confirm. No duct bank is required.

How many Cat 6 cables are required per WAP location? One (1)

Are horizontal/vertical management panels required in each communications closet rack?

Electrical Contractor to provide horizontal and vertical cable management panels as required for proper cable distribution to racks.

Is there fiber optic cabling to be installed between closets? If so, # of strands, type (MM/SM) and connector types? Copper feeder pairs between closets as well? All backbone Fiber and Copper cabling to be by NTUA. Contractor to be responsible for pathways, i.e., conduits, sleeves, etc.

On Sheet E601 "Fixture Schedule":

1. ALL fixtures to be 277V.
2. Additional fixtures as follows:

GE – "Lithonia" #ZL1N L48 3000LM FST MVOLT 35K 80CRI WH EM

WE – "Peachtree" #8HLRD-S-85-N-35K-W-277-EM

S - "Lithonia" #2GTL 4 48L SWL MVOLT EZ1 LP835 N100

N24 – "PAL" #MLS5-I/D-MO/HO-K35-24-CN-DC/LOH-FXX-277

N24E – "PAL" #MLS5-I/D-MO/HO-K35-24-CN-DC/LOH-FXX-277-EMCKT

N40 – "PAL" #MLS5-I/D-MO/HO-K35-40-CN-DC/LOH-FXX-277

U2 – "Mark Architectural Lighting" #S4LF 12FT FL H 35 HI 277 SW

Specifications:

Section 26-0519 LOW-VOLTAGE ELECTRICAL POWER CONDUCTORS AND CABLES WIRING DEVICES AND PLATES: Delete all references to NM-C type cabling.

This concludes the electrical items for this addendum. If you have any questions, please contact the undersigned.

Sincerely,

ALLIED ENGINEERING AND DESIGN INC.



By:

Dennis M. Scarcell, Jr.
Vice President, Proj. Manager