





CONTRACTOR SUBMITTAL FORM

Project Name: Navajo Gallup Water Supply Project Reach 26.3	<input checked="" type="checkbox"/> M (Materials) <input type="checkbox"/> T (Testing) <input type="checkbox"/> A (Administrative)	Submittal No.
SMA Project No: 6921307		M026
Date: 07-18-2019		
Contractor: Navajo Engineering and Construction Authority	No. of Copies: 1	


Supplier: Core & Main	Manufacturer: EJ Group, Inc.
Specification No.: 33 11 16-2.9B	Drawing No.: DT-6, DT-11
Bid Item No(s): 17, 18, 20, 21	
Submittal Checklist No(s): M249	
Product Description: 18" HD Traffic Rated Meter Can w/CI Locking Lid	
Are there any deviations from the Contract Documents? <input checked="" type="checkbox"/> No <input type="checkbox"/> Yes Explain:	
Contractor's certification that product meets requirements of Contract Documents: <input checked="" type="checkbox"/> Certified <input type="checkbox"/> Certified with variations as noted on shop drawings and/or attached sheets.	
Signed:  Quentin Benally, NECA	Date: 07-18-2019

Engineer's Comments: <input type="checkbox"/> No Exception Taken <input checked="" type="checkbox"/> Approved as Corrected <input type="checkbox"/> Exceptions as Noted <input type="checkbox"/> Submittal Rejected <input type="checkbox"/> Revise and Resubmit to Engineer <input type="checkbox"/> Contractor to Submit Specified Information - Gauge of can shall be 20 gauge	Review is limited to check for compliance with design concept. No changes from provisions of Contract Documents are intended and Contractor remains responsible for compliance with revisions therein. The Contractor is solely responsible for quantities; correctness of dimensions; verification of physical interrelation of elements of the work as required by the drawings and specifications and by field determination; fabrication procedures, construction methods, techniques and sequences. This review does not relieve the Contractor from these responsibilities. Non-conformities and errors detected have been noted but such markings, or lack thereof, shall not relieve the Contractor from compliance with all requirements of the contract drawings and specifications.
Signed: 	Date: 8/19/19


V1610-3CV V1610-3CV Assembly

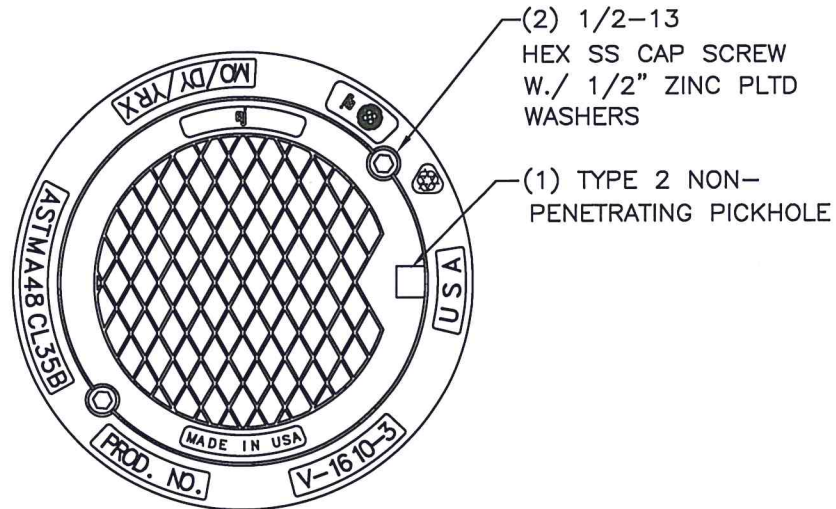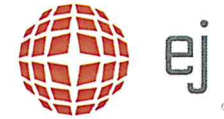


PLAN VIEW

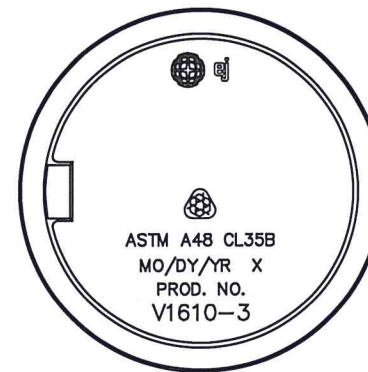


COVER BACK

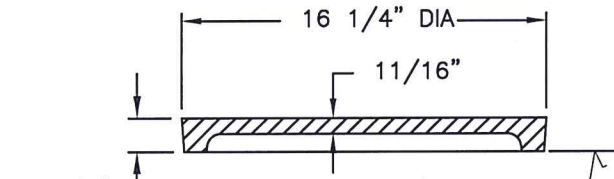

COVER SECTION

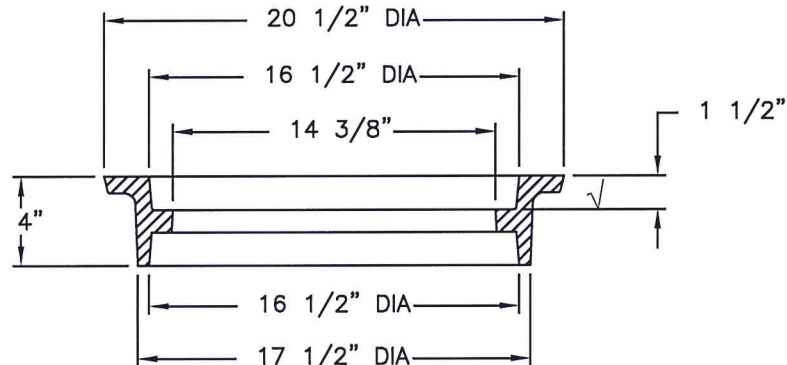

FRAME SECTION

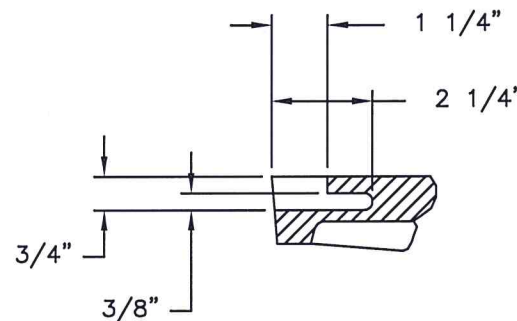

(1) TYPE TWO NON-PENETRATING PICKHOLE
PICKHOLE DETAIL

NOTE:
RING IS REVERSIBLE AND CAN BE
INSTALLED AS A BOTTOM FLANGE UNIT.

Product Number

00111800

Design Features

-Materials
Frame
Gray Iron (CL35B)
Cover
Gray Iron (CL35B)

-Design Load
Heavy Duty
-Open Area
n/a
-Coating
Dipped
-✓ Designates Machined Surface

Certification

- ASTM A48
-
-Country of Origin: USA

Major Components

41610310
41610320

Drawing Revision

10/23/2004 Designer: JIJ
09/15/2016 Revised By: DVD

Disclaimer



Weights (lbs./kg) dimensions (inches/mm) and drawings provided for your guidance. We reserve the right to modify specifications without prior notice.

CONFIDENTIAL: This drawing is the property of EJ GROUP, Inc., and embodies confidential information, registered marks, patents, trade secret information, and/or know how that is the property of EJ GROUP, Inc. Copyright © 2012 EJ GROUP, Inc. All rights reserved.

Contact


800 626 4653
ejco.com

34 18" x 18" Assembly

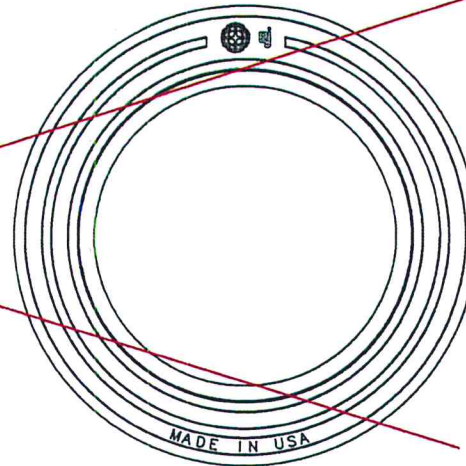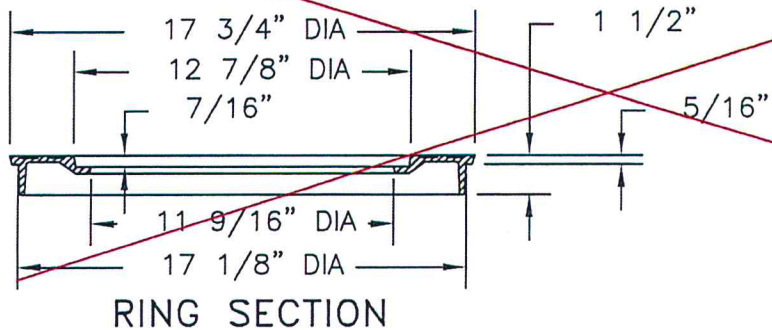

12-14 X 3/4" LONG
SELF-TAPPING SCREWS
4 PLACES

Submittal is for the can only
The frame & cover to be used is
the V1610-3

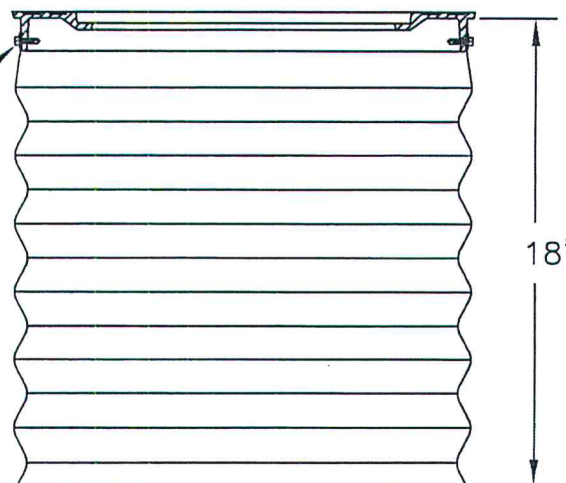

Product Number

32234002A06

Design Features

-Materials

Meter Box Ring
Gray Iron (CL35B)
Meter Box Can
Galvanized Steel

-Design Load

Non-Traffic

-Open Area

n/a

-Coating

Dipped

- Designates Machined Surface

Certification

- ASTM A48

-

-Country of Origin: USA

Major Components

32234002

38018018

Drawing Revision

03/28/2007 Designer: DAL

07/06/2012 Revised By: DJH

Disclaimer

Weights (lbs./kg) dimensions (inches/mm) and drawings provided for your guidance. We reserve the right to modify specifications without prior notice.

CONFIDENTIAL: This drawing is the property of EJ GROUP, Inc., and embodies confidential information, registered marks, patents, trade secret information, and/or know how that is the property of EJ GROUP, Inc. Copyright © 2012 EJ GROUP, Inc. All rights reserved.

Contact

800 626 4653

ejco.com