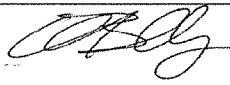
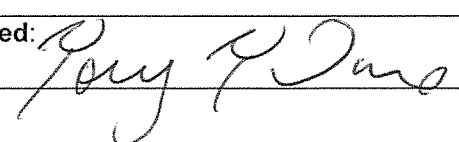


CONTRACTOR SUBMITTAL FORM


Project Name: Navajo Gallup Water Supply Project Reach 26.3	<input checked="" type="checkbox"/> M (Materials) <input type="checkbox"/> T (Testing) <input type="checkbox"/> A (Administrative)	Submittal No. M012
SMA Project No: 6921307		
Date: 07-11-2019		
Contractor: Navajo Engineering and Construction Authority	No. of Copies: 1	

Supplier: Core & Main	Manufacturer: DFW Plastics, Inc.
Specification No.: 33 12 16 – 2.9D	Drawing No.: DT-7
Bid Item No(s).: 23	
Submittal Checklist No(s).: M249	
Product Description: DFW White Cans, 36" Diameter, 42" Depth	
Are there any deviations from the Contract Documents? <input checked="" type="checkbox"/> No <input type="checkbox"/> Yes Explain:	
Contractor's certification that product meets requirements of Contract Documents: <input checked="" type="checkbox"/> Certified <input type="checkbox"/> Certified with variations as noted on shop drawings and/or attached sheets.	
Signed:  Quentin Benally, NECA	Date: 07-11-2019


Engineer's Comments: <input type="checkbox"/> No Exception Taken <input checked="" type="checkbox"/> Approved as Corrected <input type="checkbox"/> Exceptions as Noted <input type="checkbox"/> Submittal Rejected <input type="checkbox"/> Revise and Resubmit to Engineer <input type="checkbox"/> Contractor to Submit Specified Information <i>Contractor to ensure meter pit cover & frost proof lid are compatible with meter pit</i>	<p>Review is limited to check for compliance with design concept. No changes from provisions of Contract Documents are intended and Contractor remains responsible for compliance with revisions therein.</p> <p>The Contractor is solely responsible for quantities; correctness of dimensions; verification of physical interrelation of elements of the work as required by the drawings and specifications and by field determination; fabrication procedures, construction methods, techniques and sequences. This review does not relieve the Contractor from these responsibilities.</p> <p>Non-conformities and errors detected have been noted but such markings, or lack thereof, shall not relieve the Contractor from compliance with all requirements of the contract drawings and specifications.</p>
Signed: 	Date: 7/12/19

THE DFW METER PIT PAT. NO. 5249697


24" T TOP

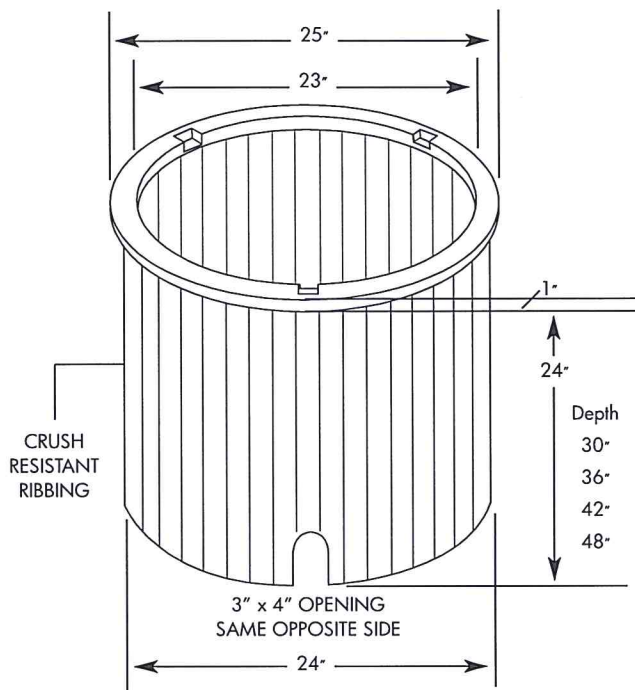


30" T TOP

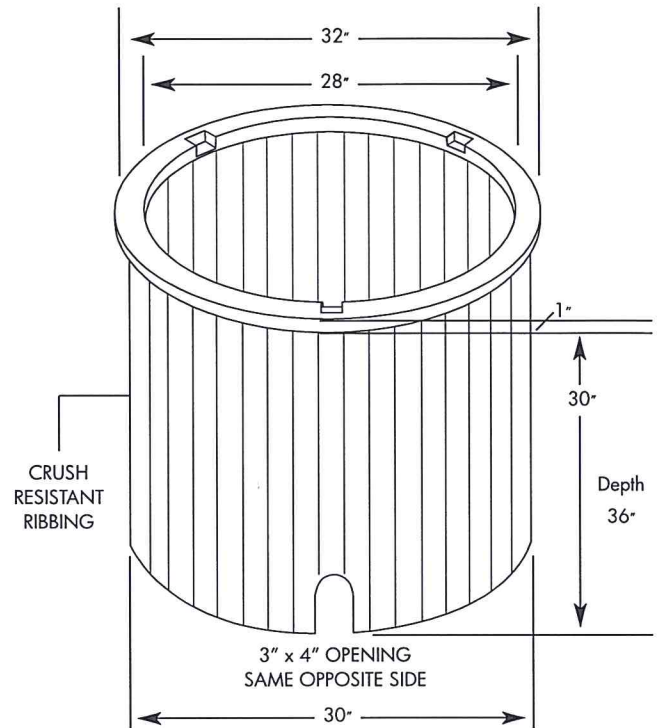


36" T TOP

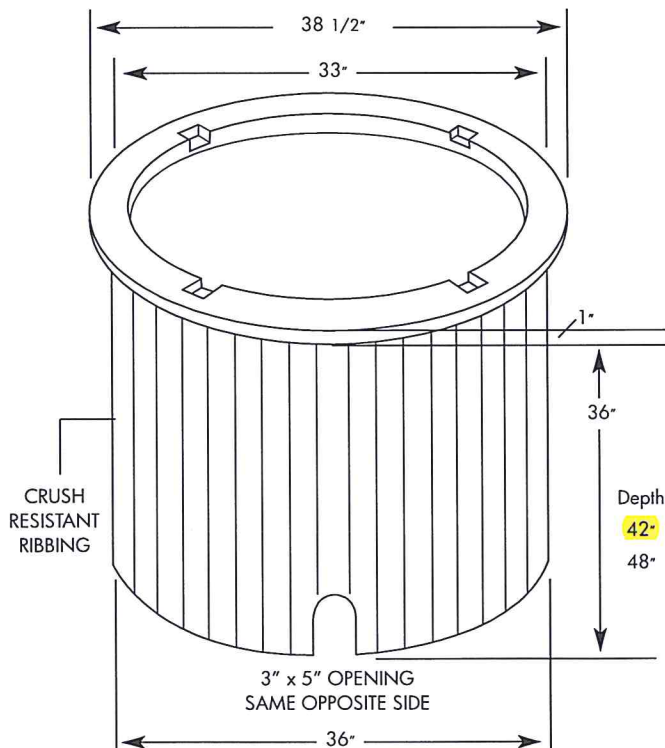

RISERS FOR T TOP DIAMETER PITS

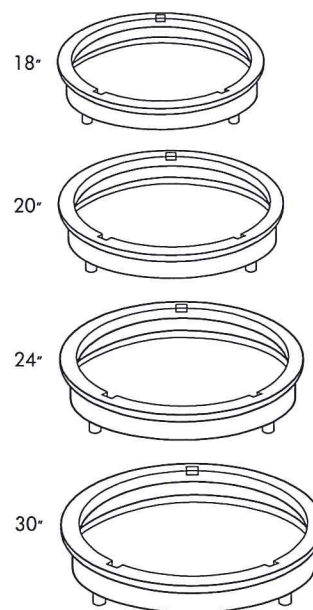

GRADE RINGS TO ADJUST HEIGHTS OF PITS

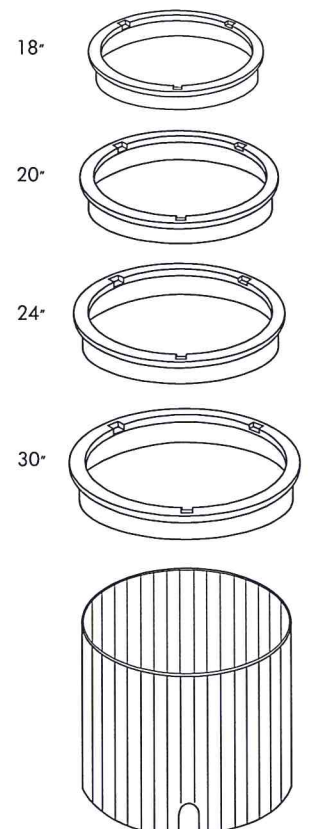

 **DFW PLASTICS, INC.**