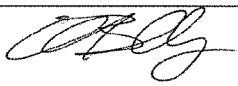
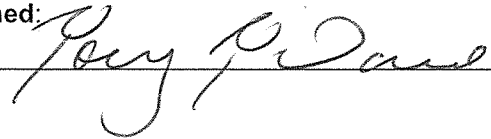


# CONTRACTOR SUBMITTAL FORM

<b>Project Name:</b> Navajo Gallup Water Supply Project Reach 26.3	<input checked="" type="checkbox"/> <b>M</b> (Materials)	<b>Submittal No.</b>  M013
<b>SMA Project No:</b> 6921307	<input type="checkbox"/> <b>T</b> (Testing)	
<b>Date:</b> 07-11-2019	<input type="checkbox"/> <b>A</b> (Administrative)	
<b>Contractor:</b> Navajo Engineering and Construction Authority	<b>No. of Copies:</b> 1	


<b>Supplier:</b> Core & Main	<b>Manufacturer:</b> Casting Inc.
<b>Specification No.:</b> 33 12 16 – 2.9C	<b>Drawing No.:</b> DT-7
<b>Bid Item No(s):</b> 23	
<b>Submittal Checklist No(s):</b> M348	
<b>Product Description:</b> 36" Frost Proof Lid for White DFW Meter Pit	
<b>Are there any deviations from the Contract Documents?</b> <input checked="" type="checkbox"/> No <input type="checkbox"/> Yes <b>Explain:</b>	
<b>Contractor's certification that product meets requirements of Contract Documents:</b> <input checked="" type="checkbox"/> Certified <input type="checkbox"/> Certified with variations as noted on shop drawings and/or attached sheets.	
<b>Signed:</b>  Quentin Benally, NECA	<b>Date:</b> 07-11-2019

<b>Engineer's Comments:</b> <input type="checkbox"/> No Exception Taken <input checked="" type="checkbox"/> Approved as Corrected <input type="checkbox"/> Exceptions as Noted <input type="checkbox"/> Submittal Rejected <input type="checkbox"/> Revise and Resubmit to Engineer <input type="checkbox"/> Contractor to Submit Specified Information  <i>Contractor to ensure meter pit cover &amp; frost proof lid is compatible with meter pit</i>	<p>Review is limited to check for compliance with design concept. No changes from provisions of Contract Documents are intended and Contractor remains responsible for compliance with revisions therein.</p> <p>The Contractor is solely responsible for quantities; correctness of dimensions; verification of physical interrelation of elements of the work as required by the drawings and specifications and by field determination; fabrication procedures, construction methods, techniques and sequences. This review does not relieve the Contractor from these responsibilities.</p> <p>Non-conformities and errors detected have been noted but such markings, or lack thereof, shall not relieve the Contractor from compliance with all requirements of the contract drawings and specifications.</p>
<b>Signed:</b> 	<b>Date:</b> 7/12/19

**CAST IRON**

**METER PIT COVER**




**M-24, M-30 & M-36 FROST-PROOF MONITOR C.I.**

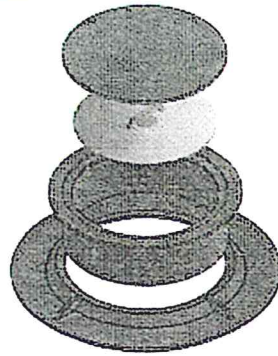



**APPROXIMATE WEIGHT**

M-24 SET	140 lb	MC24CI
M-30 SET	166 lb	MC30CI
M-36 SET	215 lb	MC36CI
TOP LID	34 lb	MCTLCI
INNER LID	23 lb	MCILCI
BODY	50 lb	MCDCI



**NOTE:**  
**FINISH—BLACK BITUMINOUS PAINT**

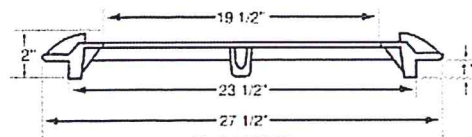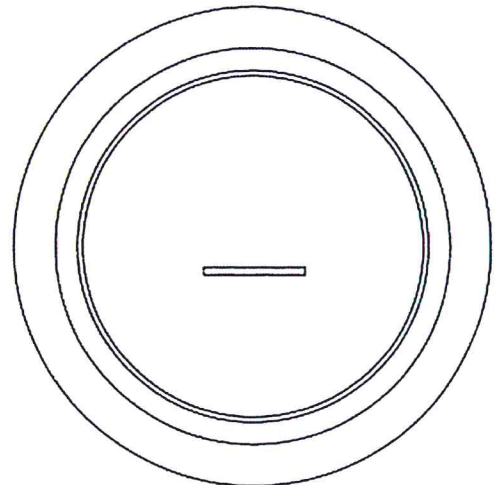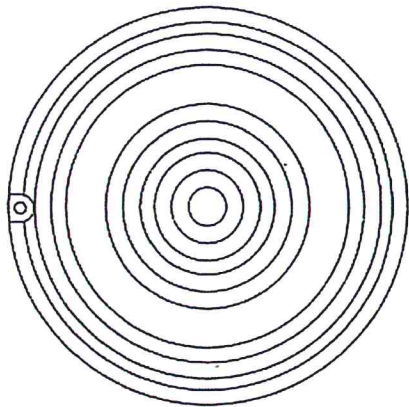


**M-24 RING**

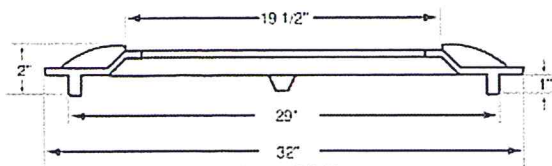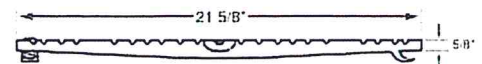

**M-30 RING**

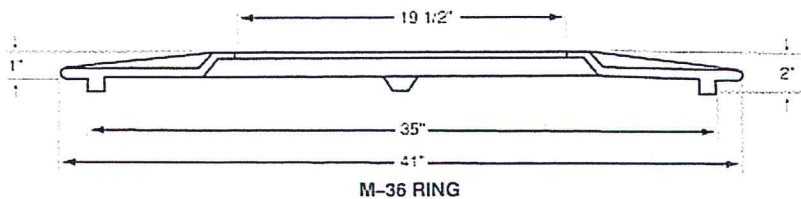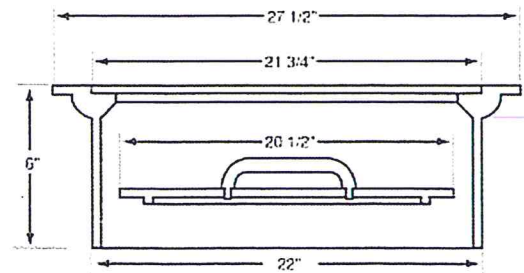

**M-36 RING**

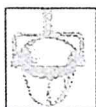

**CASTINGS INC.**

860 4TH AVE. • P.O. BOX 669 • GRAND JCT, CO 81502 • 970.243.2032 • FAX 970.242.4962