

CONSTRUCTION PLANS
FOR

NAVAJO TRIBAL UTILITY AUTHORITY




Record Drawings

RECORD DRAWING
THIS RECORD DRAWING HAS BEEN PREPARED, IN PART, BASED UPON INFORMATION FURNISHED BY OTHERS. WHILE THE INFORMATION IS BELIEVED TO BE RELIABLE, THE ENGINEER CANNOT ASSURE ITS ACCURACY, & IS NOT RESPONSIBLE FOR THE ACCURACY OF THIS RECORD DRAWING OR ANY ERRORS OR OMISSIONS WHICH MAY HAVE BEEN INCORPORATED INTO IT AS A RESULT. THOSE RELYING ON THIS RECORD DOCUMENT ARE ADVISED TO OBTAIN INDEPENDENT VERIFICATION OF ITS ACCURACY BEFORE APPLYING IT FOR ANY PURPOSE.


GANADO, ARIZONA WASTEWATER TREATMENT PLANT LAGOON UPGRADE

FUNDED BY: NTUA

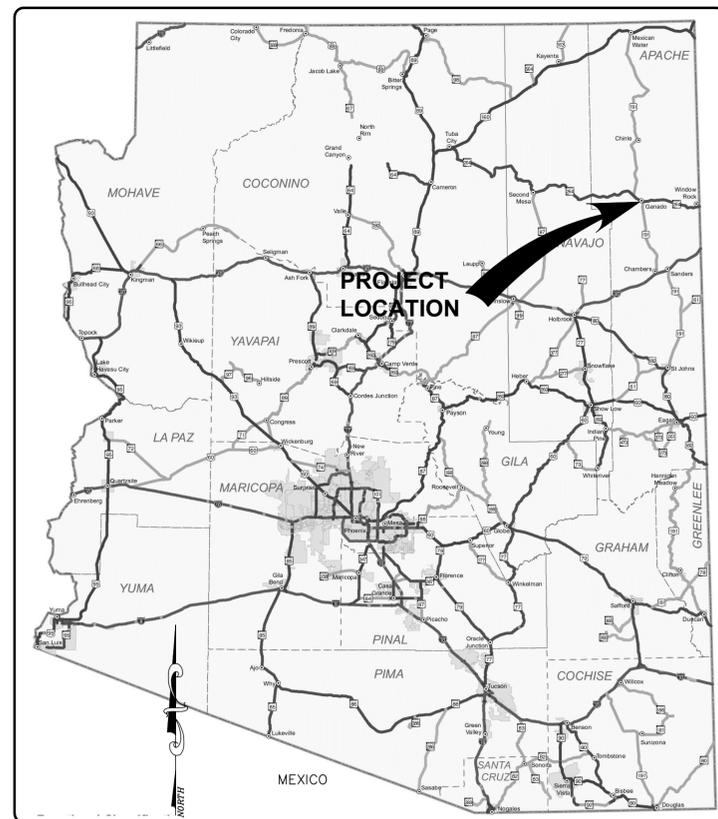

ARIZONA

Sheet List Table	
Sheet Number	Sheet Title
GENERAL	
1	COVER SHEET
2	GENERAL NOTES
CIVIL	
3	CIVIL LEGEND AND ABBREVIATIONS
4	FLOW SCHEMATIC
5	SURVEY CONTROL & EXISTING CONDITIONS
6	CIVIL DETAILS
7	SITE UPGRADES
8	AERATION SYSTEM UPGRADES
STRUCTURAL	
9	GENERAL STRUCTURAL NOTES
10	STRUCTURAL PLAN
11	STRUCTURAL DETAILS
ELECTRICAL	
E500	LEGEND NOTES & ABBREVIATIONS
E501	OVERALL SITE PLAN
E502	SINGLE LINE DIAGRAM DEMOLITIONS
E503	SINGLE LINE DIAGRAM
E504	ENLARGED PLANVIEW A
E505	ENLARGED PLANVIEW B
E506	ELEVATIONS
E507	DETAILS

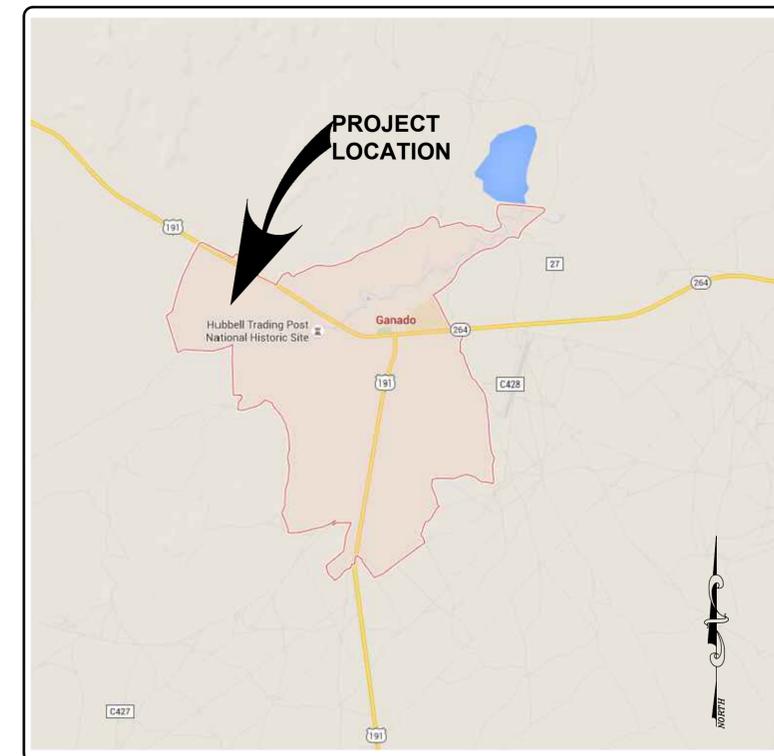

VICINITY MAP



NAVAJO TRIBAL UTILITY AUTHORITY GANADO, ARIZONA		BY
5		DATE
4		
3		
2		
1		
NO.	REVISION DESCRIPTION	

GANADO WASTEWATER TREATMENT PLANT LAGOON UPGRADE	GENERAL COVER SHEET
---	------------------------

SOLUTIONS FOR TODAY...
VISION FOR TOMORROW
2201 San Pedro Dr. NE
Building 4, Suite 200
Albuquerque, NM 87110
Phone: (505) 884-0700
Fax: (505) 884-2376
TEXAS



JOB NO: 115111
DATE: APR 2016
SHEET NO: 1

© 2016 PROJECT 8115111 NTUA NNEPA Compliance Plan Assistance Lagoon Systems/CONSTRUCT/115111-2 Ganado WWTPT/Record_DWG/Record/Plans/SET1 COVER SHEET.dwg, Feb 16, 2017 - 2:50pm Saved By: ItanG

GENERAL NOTES

- ALL WORK DETAILED ON THESE PLANS IS TO BE PERFORMED, EXCEPT AS OTHERWISE STATED OR PROVIDED FOR HEREIN, IN ACCORDANCE WITH THE MARICOPA ASSOCIATION OF GOVERNMENT (MAG) UNIFORM STANDARD SPECIFICATIONS FOR PUBLIC WORKS CONSTRUCTION - 2011 EDITION (REFERRED TO HEREIN BY STD. SPEC NUMBER OR STD. DWG NUMBER). A FREE COPY OF THE MAG SPECS IS AVAILABLE AT [HTTP://WWW.AZMAG.GOV/DOCUMENTS/2011_SPECIFICATIONS_BOOK.PDF](http://www.AZMAG.GOV/DOCUMENTS/2011_SPECIFICATIONS_BOOK.PDF)
- BIDDER SHALL PROMPTLY GIVE ENGINEER WRITTEN NOTICE OF ALL CONFLICTS, ERRORS, AMBIGUITIES, OR DISCREPANCIES THAT BIDDER DISCOVERS IN THE BIDDING DOCUMENTS AND CONFIRM THAT THE WRITTEN RESOLUTION THEREOF BY ENGINEER IS ACCEPTABLE TO BIDDER. CONTRACTOR SHALL CORRELATE INFORMATION KNOWN TO CONTRACTOR, INFORMATION AND OBSERVATIONS OBTAINED FROM VISITS TO THE SITE, REPORTS AND DRAWINGS IDENTIFIED IN THE BIDDING DOCUMENTS, AND ALL ADDITIONAL EXAMINATIONS, INVESTIGATIONS, EXPLORATIONS, TESTS, STUDIES, AND DATA WITH THE CONTRACT DOCUMENTS.
- SUBMISSION OF A BID WILL CONSTITUTE AN INCONVERTIBLE REPRESENTATION BY BIDDER THAT BIDDER HAS COMPLIED WITH ALL BIDDING REQUIREMENTS AND THAT WITHOUT EXCEPTION THE BID IS PREMISED UPON PERFORMING AND FURNISHING THE WORK REQUIRED BY THE BIDDING DOCUMENTS AND APPLYING ANY SPECIFIC MEANS, METHODS, TECHNIQUES, SEQUENCES, AND PROCEDURES OF CONSTRUCTION THAT MAY BE SHOWN OR INDICATED OR EXPRESSLY REQUIRED BY THE BIDDING DOCUMENTS, THAT BIDDER HAS GIVEN ENGINEER WRITTEN NOTICE OF ALL CONFLICTS, ERRORS, AMBIGUITIES, AND DISCREPANCIES THAT BIDDER HAS DISCOVERED IN THE BIDDING DOCUMENTS AND THE WRITTEN RESOLUTIONS THEREOF BY ENGINEER ARE ACCEPTABLE TO BIDDER, AND THAT THE BIDDING DOCUMENTS ARE GENERALLY SUFFICIENT TO INDICATE AND CONVEY UNDERSTANDING OF ALL TERMS AND CONDITIONS FOR PERFORMING AND FURNISHING THE WORK.
- BEFORE UNDERTAKING EACH PART OF THE WORK, CONTRACTOR SHALL CAREFULLY STUDY AND COMPARE THE CONTRACT DOCUMENTS AND CHECK AND VERIFY PERTINENT FIGURES THEREIN AND ALL APPLICABLE FIELD MEASUREMENTS. CONTRACTOR SHALL PROMPTLY REPORT IN WRITING TO ENGINEER ANY CONFLICT, ERROR, AMBIGUITY, OR DISCREPANCY WHICH CONTRACTOR DISCOVERS, OR HAS ACTUAL KNOWLEDGE OF, AND SHALL OBTAIN A WRITTEN INTERPRETATION OR CLARIFICATION FROM ENGINEER BEFORE PROCEEDING WITH ANY WORK AFFECTED THEREBY. IF, DURING THE PERFORMANCE OF THE WORK, CONTRACTOR DISCOVERS ANY CONFLICT, ERROR, AMBIGUITY, OR DISCREPANCY WITHIN THE CONTRACT DOCUMENTS, OR BETWEEN THE CONTRACT DOCUMENTS AND (A) ANY APPLICABLE LAW OR REGULATION, (B) ANY STANDARD, SPECIFICATION, MANUAL, OR CODE, OR (C) ANY INSTRUCTION OF ANY SUPPLIER, THEN CONTRACTOR SHALL PROMPTLY REPORT IT TO ENGINEER IN WRITING. CONTRACTOR SHALL NOT PROCEED WITH THE WORK AFFECTED THEREBY (EXCEPT IN AN EMERGENCY) UNTIL AN AMENDMENT OR SUPPLEMENT TO THE CONTRACT DOCUMENTS HAS BEEN ISSUED.
- THE CONTRACT, IF AWARDED, WILL BE BASED ON MATERIAL AND EQUIPMENT SPECIFIED OR DESCRIBED IN THE BIDDING DOCUMENTS WITHOUT CONSIDERATION OF POSSIBLE SUBSTITUTE OR "OR EQUAL" ITEMS. WHEREVER A BRAND NAME IS SPECIFIED OR DESCRIBED IN THE BIDDING DOCUMENTS A SUBSTITUTE OR "OR EQUAL" ITEM OF MATERIAL OR EQUIPMENT MAY BE FURNISHED OR USED BY THE CONTRACTOR IF ACCEPTABLE TO THE ENGINEER. APPLICATION FOR SUCH ACCEPTANCE WILL NOT BE CONSIDERED BY THE ENGINEER UNTIL AFTER THE EFFECTIVE DATE OF AGREEMENT. THE PROCEDURE FOR SUBMISSION OF ANY SUCH APPLICATION BY THE CONTRACTOR AND CONSIDERATION BY THE ENGINEER IS SET FORTH IN THE GENERAL CONDITIONS.
- THE CONTRACTOR IS RESPONSIBLE FOR COMPLIANCE OF APPLICABLE PORTIONS OF THE EPA STORM WATER DISCHARGE REGULATIONS.
- THE CONTRACTOR IS RESPONSIBLE FOR ALL PERMITS AND PERMIT COMPLIANCE REQUIRED FOR CONSTRUCTION OF THE PROJECT.
- THE WORK DESCRIBED IN THESE PLANS WILL BE DONE IN EXISTING WASTEWATER TREATMENT FACILITIES THAT CONTAIN NUMEROUS EXISTING PIPES, ELECTRIC LINES, AND OTHER STRUCTURES. THE CONTRACTOR IS RESPONSIBLE FOR INSTALLATION OF ALL ITEMS DESCRIBED IN THESE PLANS IN A MANNER THAT PROTECTS THE EXISTING FACILITY. THE CONTRACTOR MUST CONTACT THE ENGINEER IMMEDIATELY IF THE CONTRACTOR CANNOT PERFORM THE WORK WITHOUT DAMAGE TO THE EXISTING FACILITY. THE CONTRACTOR MUST VERIFY ALL EXISTING INFORMATION SHOWN ON THESE PLANS. CHANGES IN ALIGNMENT CAUSED BY UNKNOWN OR UNANTICIPATED SITE CONDITIONS SHALL BE MEASURED AND PAID FOR BASED ON THE APPROVED SCHEDULE OF VALUES SUBMITTED BY THE CONTRACTOR.
- THE LOCATION, SIZE, AND CONDITION OF UNDERGROUND UTILITIES AND STRUCTURES SHOWN IN THESE PLANS ARE BASED ON AVAILABLE RECORDS. THE CONTRACTOR IS REQUIRED TO TAKE ALL PRECAUTIONARY MEASURES TO PROTECT THE UTILITIES SHOWN, AND ANY OTHER LINES OR STRUCTURES NOT SHOWN ON THESE PLANS, AND IS RESPONSIBLE FOR LOCATING, PROTECTION OF, OR ANY DAMAGE TO THESE LINES OR STRUCTURES. THE CONTRACTOR IS RESPONSIBLE FOR NOTIFYING ALL UTILITY COMPANIES AND OBTAINING LINE SPOTS.
- PRIOR TO CONSTRUCTION, THE CONTRACTOR SHALL EXCAVATE AND VERIFY THE HORIZONTAL AND VERTICAL LOCATIONS OF ALL OBSTRUCTIONS. SHOULD A CONFLICT EXIST, THE CONTRACTOR SHALL NOTIFY THE ENGINEER IMMEDIATELY SO THE CONFLICT CAN BE RESOLVED WITH MINIMUM AMOUNT OF DELAY. THE CONTRACTOR SHALL IDENTIFY UTILITY LINES FAR ENOUGH IN ADVANCE OF CONSTRUCTION WORK, SO THAT THE OWNER OF SUCH LINES CAN RAISE, LOWER, REALIGN OR REMOVE LINES AND STRUCTURES (IF NECESSARY), AND THE ENGINEER CAN MAKE NECESSARY LINE AND GRADE CHANGES (SHOULD THE EXISTING UTILITY LINES CONFLICT WITH THE WORK UNDER CONSTRUCTION), PROVIDING SUCH ADJUSTMENTS DO NOT MATERIALLY AFFECT THE WORK.
- THE CONTRACTOR SHALL BE HELD RESPONSIBLE FOR COSTS OF REPAIR OF ANY AND ALL DAMAGE TO ANY UTILITY (WHICH IS PREVIOUSLY KNOWN, DISCLOSED, OR SHOWN ON THESE PLANS) CAUSED BY THE CONTRACTORS OPERATIONS.
- FIVE (5) WORKING DAYS PRIOR TO ANY EXCAVATION, THE CONTRACTOR MUST CONTACT NTUA (THOMAS BAYLESS @ 928-729-4779) FOR LOCATION OF EXISTING UTILITIES.
- THE CONTRACTOR SHALL GIVE ALL PUBLIC AND PRIVATE UTILITY COMPANIES NOTICE AS SOON AS POSSIBLE, IN NO EVENT LESS THAN FORTY EIGHT (48) HOURS, FOR ANY WORK THAT IS UNDERSTOOD TO INTERFERE WITH THE SERVICE OF ANY EXISTING PUBLIC OR PRIVATE UTILITY. IF SUCH PUBLIC OR PRIVATE UTILITY DOES NOT COOPERATE FOR THE PROTECTION OF ITS SERVICES, THE CONTRACTOR SHALL NOTIFY THE ENGINEER.
- UTILITY CONTACTS: GAS, SEWER, WATER, ELECTRIC: NTUA SAFETY DEPARTMENT 928-729-5721, TELEPHONE: FRONTIER COMMUNICATION 928-871-3748.
- THE CONTRACTOR SHALL MAINTAIN ACCESS TO ALL FACILITIES ADJACENT TO THE CONSTRUCTION AREA.
- THE CONTRACTOR IS RESPONSIBLE FOR RECORDING EXISTING CONDITIONS BEFORE CONSTRUCTION BEGINS. THE RECORD OF EXISTING CONDITIONS SHALL BE USED AS THE "EQUAL CONDITION BEFORE DAMAGE" IN THE EVENT OF DAMAGE TO PUBLIC OR PRIVATE PROPERTY.
- THE CONTRACTOR SHALL IMMEDIATELY REPORT ANY DAMAGES TO PUBLIC OR PRIVATE PROPERTY TO THE OWNER OF THE PROPERTY INVOLVED AND TO THE ENGINEER. THE CONTRACTOR SHALL REPAIR OR RESTORE AT THE CONTRACTOR'S EXPENSE ANY DAMAGE TO PUBLIC OR PRIVATE PROPERTY, FOR WHICH THE CONTRACTOR IS DIRECTLY OR INDIRECTLY RESPONSIBLE, TO A CONDITION EQUAL TO THAT EXISTING BEFORE DAMAGE. THE CONTRACTOR SHALL PROMPTLY NOTIFY THE CONTRACTORS INSURANCE CARRIER OF SUCH DAMAGE. IF THE CONTRACTOR FAILS TO GIVE SUCH NOTICE TO THE INSURANCE CARRIER OR REFUSES TO MAKE SUCH REPAIRS OR RESTORATION UPON RECEIPT OF NOTICE, THE OWNER MAY DEDUCT THE COST OF SUCH REPAIRS OR RESTORATION FROM MONEYS DUE, OR WHICH MAY BECOME DUE, TO THE CONTRACTOR.
- THE LANDS WITHIN THE FENCE LINE OF THE WASTEWATER TREATMENT PLANT BELONG TO THE NAVAJO TRIBAL UTILITY AUTHORITY (NTUA). THE CONTRACTOR MAY USE THESE LANDS TO FACILITATE CONSTRUCTION WITH APPROVAL OF THE NTUA. A PREAPPROVED STAGING/STORAGE AREA IS SHOWN IN THE PLANS. THE CONTRACTOR SHALL AVOID ANY ACTIVITY IN THESE LANDS THAT WOULD BE A POTENTIALLY SIGNIFICANT DISTURBANCE TO OPERATION AND MAINTENANCE OF THE WASTEWATER PLANT.
- DEBRIS GENERATED BY CONSTRUCTION ACTIVITIES MAY BE STORED AT THE CONSTRUCTION SITE AT AN AREA IDENTIFIED BY THE WASTEWATER TREATMENT PLANT PERSONNEL. DEBRIS MAY BE STORED DURING CONSTRUCTION UPON STAGING AND STORAGE AREAS SHOWN ON THE PLANS. THE CONTRACTOR SHALL BE RESPONSIBLE FOR IDENTIFYING SAFETY ISSUES ASSOCIATED WITH STORED DEBRIS AND SHALL PROVIDE FENCING AND/OR BARRICADING AROUND DEBRIS IF NECESSARY. PRIOR TO COMPLETION OF CONSTRUCTION, THE CONTRACTOR SHALL DISPOSE OF DEBRIS AT A PERMITTED LANDFILL OR OTHER DULY CERTIFIED REFUSE FACILITY (INCIDENTAL TO THE PROJECT).
- THE CONTRACTOR SHALL STOCK PILE ANY EXCESS EARTH ON-SITE AT A LOCATION DETERMINED BY THE WASTEWATER PERSONNEL
- THE CONTRACTOR SHALL PHASE AND SCHEDULE WORK IN SUCH A WAY AS TO PROVIDE FOR CONTINUOUS WASTEWATER TREATMENT DURING CONSTRUCTION. THE CONTRACTOR'S SCHEDULE SHALL INCLUDE FLOW SCHEMATICS AND PROCESS DIAGRAMS TO ILLUSTRATE FLOW ROUTING AND TREATMENT.
- UNLESS OTHERWISE NOTED, THE CONTRACTOR IS GRANTED SALVAGE RIGHTS TO ALL CONSTRUCTION DEBRIS, PROVIDED THE CONTRACTOR USES SAID DEBRIS IN A LAWFUL MANNER. THE CONTRACTOR SHALL PROVIDE A LIST OF ITEMS SALVAGED TO THE ENGINEER AND OWNER BEFORE THE CONTRACTOR TAKES ITEMS OFF THE SITE.
- SHALL NOT LOAD NOR PERMIT ANY PART OF ANY STRUCTURE TO BE LOADED IN ANY MANNER THAT WILL ENDANGER THE STRUCTURE NOR SHALL CONTRACTOR SUBJECT ANY PART OF THE WORK OR ADJACENT PROPERTY TO STRESSES OR PRESSURES THAT WILL ENDANGER IT.
- IF THIS DRAWING IS OTHER THAN FULL SIZE (22" X 34"), UTILIZE BAR SCALE IN LIEU OF NUMERIC SCALE.

- ALL UTILITY MANHOLES, METERS CLEANOUTS, AND VALVES IMPACTED BY CONSTRUCTION TO BE FILED LOCATED AND ADJUSTED TO GRADE, THIS SHALL BE INCIDENTAL TO THE PROJECT.
- THE DESIGN FLOW RATE FOR THIS FACILITY IS 0.4 MGD.



NAVAJO TRIBAL UTILITY AUTHORITY GANADO, ARIZONA		NO.	1	DATE	BY
		REVISION DESCRIPTION			
		5			
		4			
		3			
		2			
		1			

GANADO WASTEWATER TREATMENT PLANT
LAGOON UPGRADE
GENERAL NOTES

SOLUTIONS FOR TODAY... VISION FOR TOMORROW
 2201 San Pedro Dr. NE
 Building 4, Suite 200
 Albuquerque, NM 87110
 Phone: (505) 884-0700
 Fax: (505) 884-2376
TEXAS

RECORD DRAWING
 THIS RECORD DRAWING HAS BEEN PREPARED, IN PART, BASED UPON INFORMATION FURNISHED BY OTHERS. WHILE THE INFORMATION IS BELIEVED TO BE RELIABLE, THE ENGINEER CANNOT ASSURE IT'S ACCURACY, & IS NOT RESPONSIBLE FOR THE ACCURACY OF THIS RECORD DRAWING OR ANY ERRORS OR OMISSIONS WHICH MAY HAVE BEEN INCORPORATED INTO IT AS A RESULT. THOSE RELYING ON THIS RECORD DOCUMENT ARE ADVISED TO OBTAIN INDEPENDENT VERIFICATION OF IT'S ACCURACY BEFORE APPLYING IT FOR ANY PURPOSE.


JOB NO.: 115111
 DATE: APR 2016
 SHEET NO.: 2

ABBREVIATIONS


AC ASPHALT CONCRETE	PC POINT OF CURVE OR PORTLAND CEMENT
ADJT ADJUSTABLE	PCC POINT OF COMPOUND CURVE
ADMIN ADMINISTRATION	PCV PUMP CONTROL VALVE
APPD APPROVED	PE PLAIN END
APPROX APPROXIMATE	PER PURSUANT
ARV AIR RELEASE VALVE	PG PRESSURE GAUGE OR PROPANE GAS
ASTM AMERICAN SOCIETY FOR TESTING AND MATERIAL	PI POINT OF INTERSECTION
ASBY ASSEMBLY	P&ID PROCESS AND INSTRUMENTATION DIAGRAM
ASP AER ASPIRATING AERATOR	PLT PLANT
AWWA AMERICAN WATER WORKS ASSOCIATION	PMP PUMP
BC BEGIN CURVE	POB POINT OF BEGINNING
BCV BALL CHECK VALVE	POTA POTABLE
BFV BUTTERFLY VALVE	PP POWER POLE
BFP BACK FLOWPREVENTER	PPD POUNDS PER DAY
BLDG BUILDING	PPH POUNDS PER HOUR
BLKG BLOCKING	PPM PARTS PER MILLION
BNR BIOLOGICAL NUTRIENT REMOVAL	PRC POINT OF REVERSE CURVE
BOD BIOCHEMICAL OXYGEN DEMAND	PREFAB PREFABRICATED
BOP BOTTOM OF PIPE	PRESS PRESSURE
BOT BOTTOM	PROP PROPERTY
BPV BACK PRESSURE VALVE	PRV PRESSURE REGULATING VALVE
B&S BELL AND SPIGOT	PS PUMP STATION OR PRESSURE SWITCH
BTU BRITISH THERMAL UNIT	PSF POUNDS PER SQUARE FOOT
BV BALL VALVE	PSI POUNDS PER SQUARE INCH
BW BACKWASH	PSIG POUNDS PER SQUARE INCH GAUGE
BYP BYPASS	PT POINT OF TANGENT
CARV/CAV COMBINATION AIR/VACUUM RELEASE VALVE	PV PLUG VALVE
CCP CONCRETE CYLINDER PIPE	PVC POLYVINYL CHLORIDE
CFM CUBIC FEET PER MINUTE	PVCC POINT OF VERTICAL COMPOUND CURVE
CFS CUBIC FEET PER SECOND	PVI POINT OF VERTICAL INTERSECTION
CG CANAL GATE	PVMT PAVEMENT
CI CAST IRON	PVRC POINT OF VERTICAL RETURN CURVE
CIP CAST IRON PIPE	PVT POINT OF VERTICAL TANGENT
CJ CONSTRUCTION JOINT	PW PLANT WATER
CL CLARIFIER OR CENTERLINE	RAS RETURN ACTIVATED SLUDGE
CMP CORRUGATED METAL PIPE	RCP REINFORCED CONCRETE PIPE
CMU CONCRETE MASONRY UNIT	RD ROAD ROOF DRAIN OR ROUND
CO CLEAN-OUT	RDCR REDUCER
CONC CONCRETE	RE RECYCLE
COP CROSS OVER PIPE	RE-CIRC. RE-CIRCULATION
C&P CLEAN AND PATCH	RET RETURN
CPLG COUPLING	R.C&P REMOVE, CLEAN AND PATCH
CU FT CUBIC FOOT	R&D REMOVE & DISPOSE
CU YD CUBIC YARD	RIB RAW INFLUENT BUILDING
CV CHECK VALVE	R&R REMOVE & RELOCATE
DIG DIGESTER	R&S REMOVE & SALVAGE
DIMJ DUCTILE IRON MECHANICAL JOINT	RS REUSE
DIP DUCTILE IRON PIPE	RSNTS RESTRAINTS
DIS DISCHARGE	S SOUTH
DPCO DOUBLE PRESSURE CLEAN OUT	SAS SANITARY SERVICE
DRN DRAIN	SAS FM SANITARY SEWER FORCE MAIN
E EAST	SEQUOX SEQUENTIAL OXIDATION
EA EACH	SLG SLUDGE
ED EFFLUENT DISCHARGE	SPEC SPECIFICATION
EFF EFFLUENT	SQ FT SQUARE FOOT
ELL ELBOW	SQ IN SQUARE INCH
EL ELEVATION	SS SEWER
ENGR ENGINEER	STD STANDARD
EQ EQUAL	STL STEEL OR STEEL PIPE
EXIST EXISTING	STN STL STAINLESS STEEL
FF FINISHED FLOOR	STRUCT STRUCTURE OR STRUCTURAL
FG FINISH GRADE	STS SUPPLEMENTAL TECHNICAL SPECIFICATION
FIN FINISH OR FINISHED	SUC SUCTION
FL FLANGED	SUP SUPPLY
FLR FLOOR	SWD SIDE WATER DEPTH
FRG FIBER GLASS	SYS SYSTEM
FRP FIBER GLASS PIPE	T&B TOP AND BOTTOM
FT FEET OR FOOT	TBC TOP BACK OF CURB
FW FINISHED WATER	TEL TELEPHONE
GAL GALLON	T.O.C. TOP OF CONCRETE
GALV GALVANIZED	TOG TOP OF GRATING
GALV STL GALVANIZED STEEL	TOW TOP OF WALL
GPD GALLONS PER DAY	TP TELEPHONE POLE
GPH GALLONS PER HOUR	UBC UNIFORM BUILDING CODE
GPM GALLONS PER MINUTE	UGE UNDERGROUND ELECTRIC
GRD GRADE OR GROUND	UL UNDERWRITERS LABORATORIES
GV GATE VALVE	UNKN UNKNOWN
H HEIGHT	UP UTILITY POLE
HB HOSE BIB	UV ULTRAVIOLET
HDPE HIGH DENSITY POLYETHYLENE	VIC VITALIC
HGL HYDRAULIC GRADE LINE	WAS WASTE ACTIVATED SLUDGE
HORIZ HORIZONTAL	W WATER
HP HORSEPOWER	WL WATER LINE
I.D. INSIDE DIAMETER	WSTP WATER STOP
INFL INFLUENT	WV WATER VALVE
INS INSULATED	FT FOOT
INV INVERT	INCH
IRR IRRIGATION	
ISV ISOLATION VALVE	
JB JUNCTION BOX	
JT JOINT	
KM KILOMETER	
KV KILOVOLT	
KW KILOWATT	
KWH KILOWATT HOUR	
L LITER, LENGTH OR ANGLE	
LF LINEAR FEET	
LR LONG RADIUS	
LS LIFT STATION	
MAG MAGNETIC	
MAINT. MAINTENANCE	
MANF MANUFACTURER	
MAX MAXIMUM	
MGD MILLION GALLONS PER DAY	
MH MANHOLE	
MISC MISCELLANEOUS	
MJ MECHANICAL JOINT	
MNTD MOUNTED	
N NORTH	
NC NORMALLY CLOSED	
NEMA NATIONAL ELECTRICAL MANUFACTURERS ASSOC.	
NEPA NATIONAL FIRE PROTECTION ASSOCIATION	
NIS NOT IN SERVICE	
NO NORMALLY OPEN OR NUMBER	
NPS NOMINAL PIPE SIZE	
NTS NOT TO SCALE	
OC ON CENTER	
OD OUTSIDE DIAMETER OR OVERFLOW DRAIN	
O.E.A.E. OR ENGINEERED APPROVED EQUAL	
OG ORIGINAL GROUND	
OHE OVERHEAD ELECTRIC UTILITY OPERATION	

ANNOTATION LEGEND


	BUILD NOTE
	BENCH MARK
	SURVEY CONTROL POINT OR POINT OF INTERSECTION
	SHEET NOTE (NEW EQUIP.)
	SHEET NOTE (EXIST. EQUIP.)
	FREE WATER SURFACE
	POINT COORDINATES
	NODE POINT

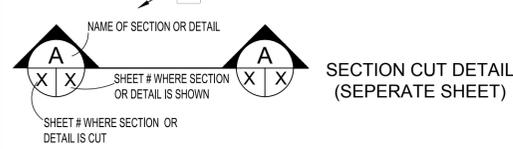


CIVIL LEGEND

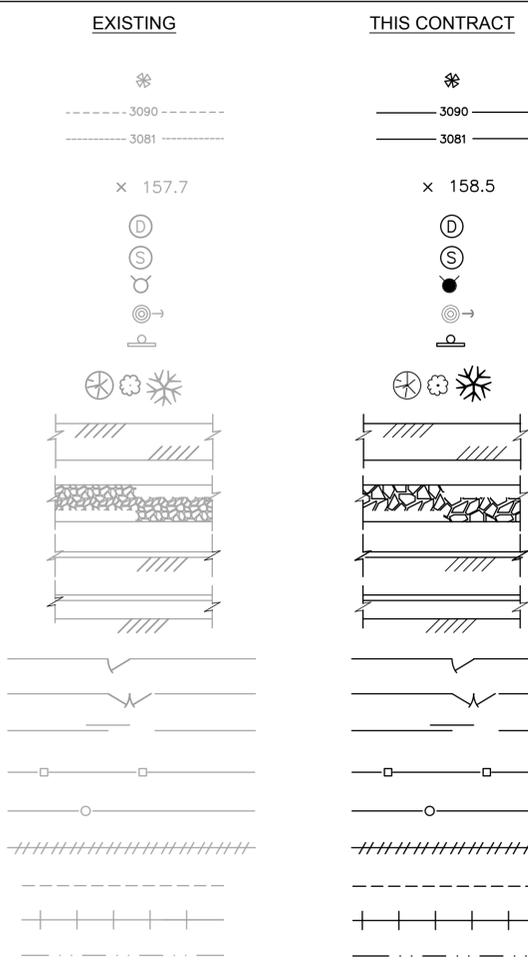

YARD PIPING LEGEND

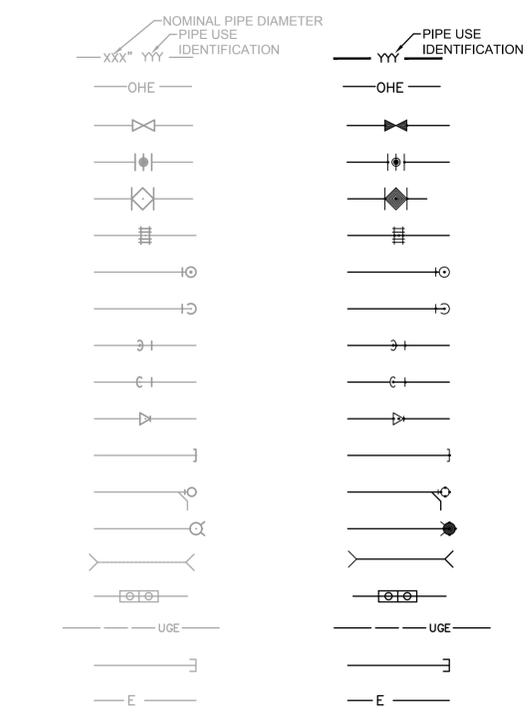

LEGENDS

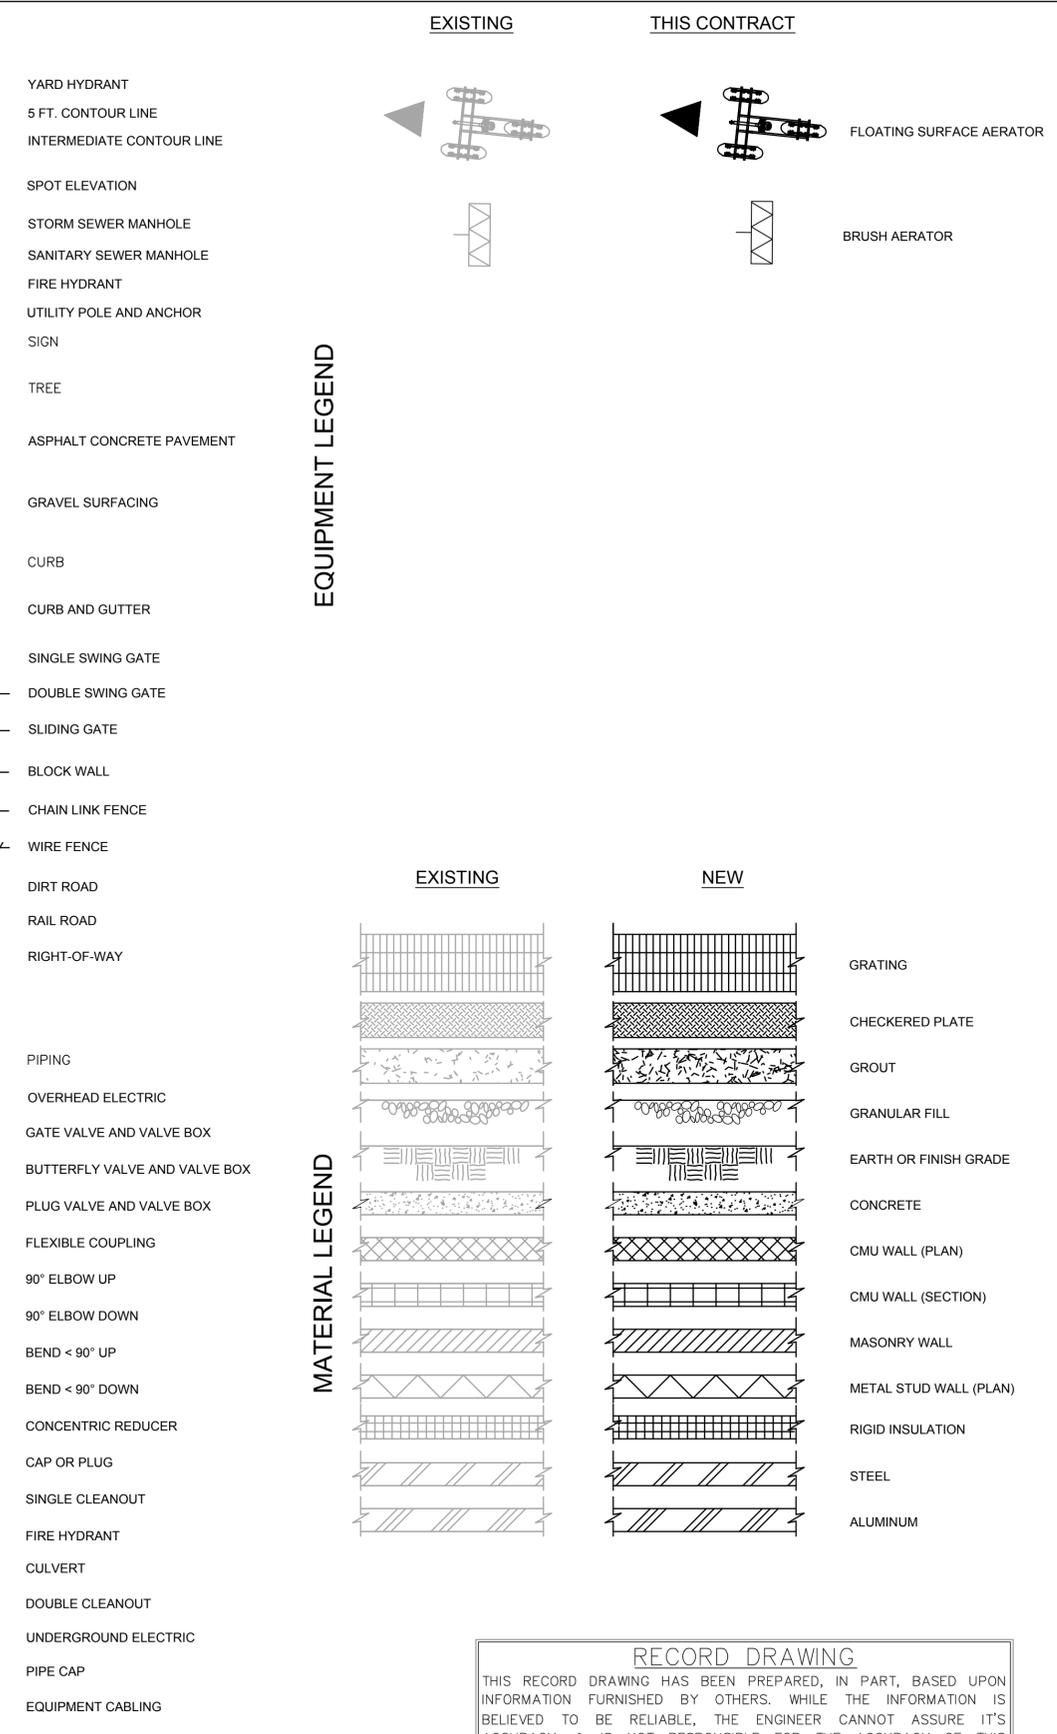

RECORD DRAWING
 THIS RECORD DRAWING HAS BEEN PREPARED, IN PART, BASED UPON INFORMATION FURNISHED BY OTHERS. WHILE THE INFORMATION IS BELIEVED TO BE RELIABLE, THE ENGINEER CANNOT ASSURE IT'S ACCURACY, & IS NOT RESPONSIBLE FOR THE ACCURACY OF THIS RECORD DRAWING OR ANY ERRORS OR OMISSIONS WHICH MAY HAVE BEEN INCORPORATED INTO IT AS A RESULT. THOSE RELYING ON THIS RECORD DOCUMENT ARE ADVISED TO OBTAIN INDEPENDENT VERIFICATION OF IT'S ACCURACY BEFORE APPLYING IT FOR ANY PURPOSE.



NO.	REVISION DESCRIPTION	DATE	BY
5			
4			
3			
2			
1			


NAVAJO TRIBAL UTILITY AUTHORITY
 GANADO, ARIZONA

GANADO WASTEWATER TREATMENT PLANT
 LAGOON UPGRADE

CIVIL
 CIVIL LEGEND AND ABBREVIATIONS

SOLUTIONS FOR TODAY... VISION FOR TOMORROW
 2201 San Pedro Dr. NE
 Building 4, Suite 200
 Albuquerque, NM 87110
 Phone: (505) 884-0700
 Fax: (505) 884-2376
TEXAS

JOB NO: 115111
 DATE: APR 2016
 SHEET NO: 3

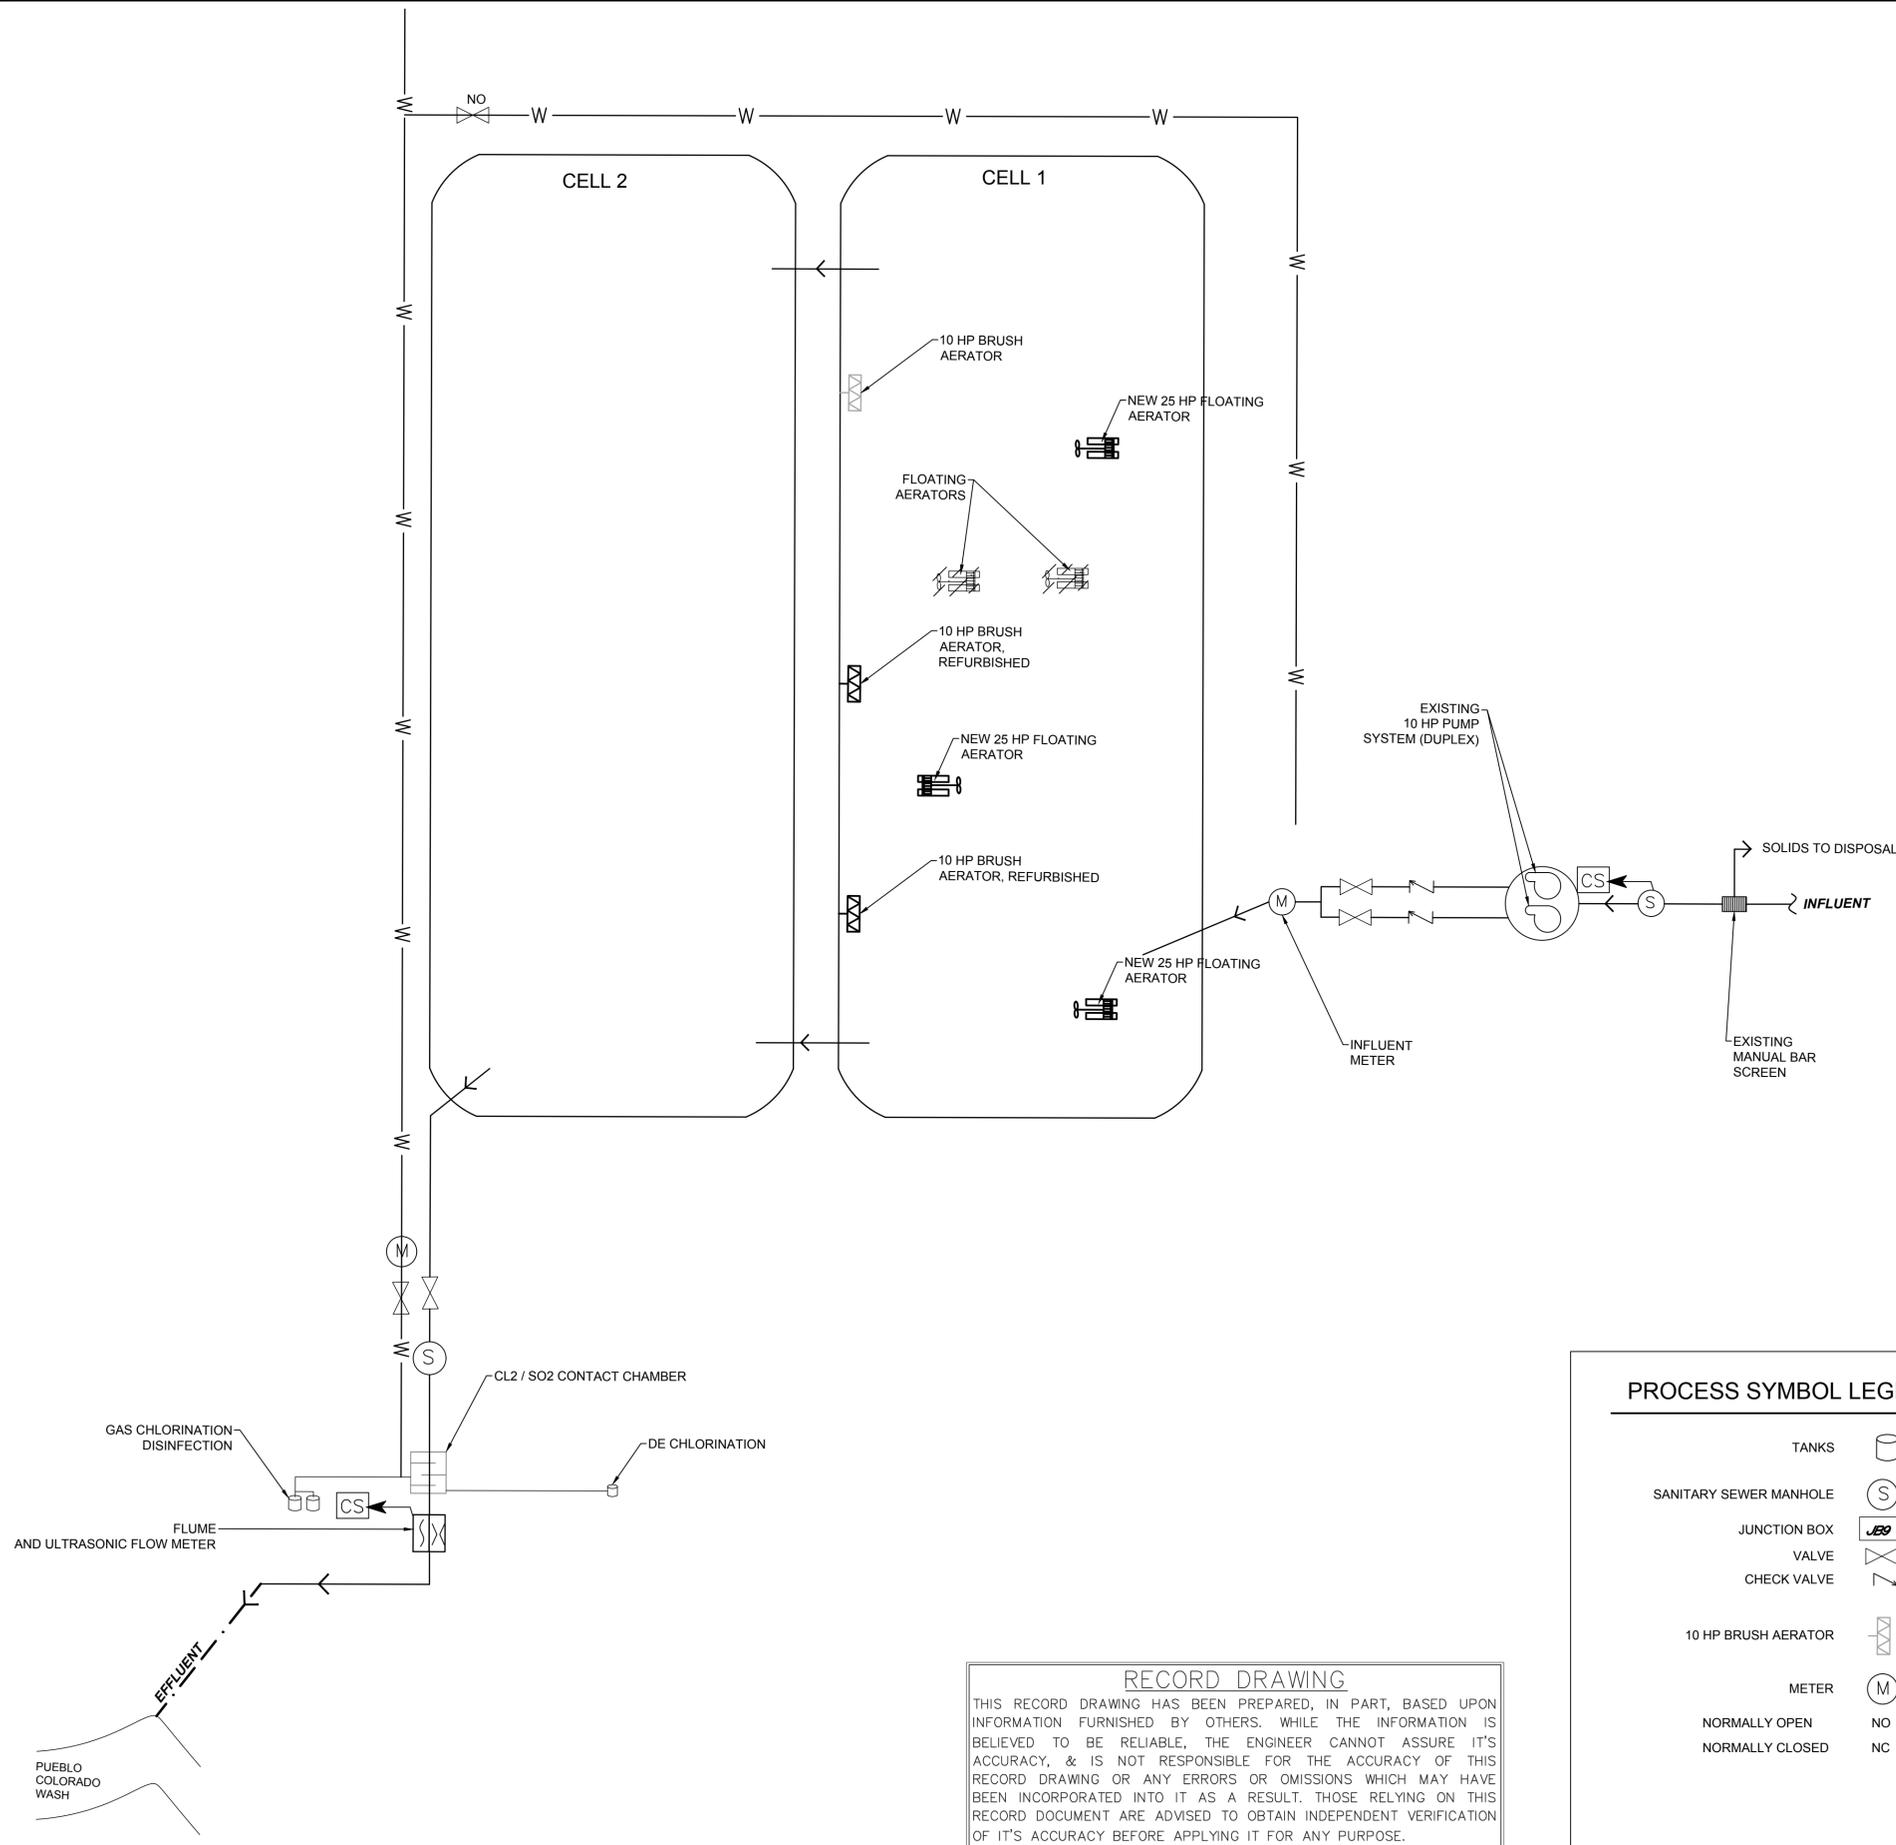

RECORD DRAWING

THIS RECORD DRAWING HAS BEEN PREPARED, IN PART, BASED UPON INFORMATION FURNISHED BY OTHERS. WHILE THE INFORMATION IS BELIEVED TO BE RELIABLE, THE ENGINEER CANNOT ASSURE ITS ACCURACY, & IS NOT RESPONSIBLE FOR THE ACCURACY OF THIS RECORD DRAWING OR ANY ERRORS OR OMISSIONS WHICH MAY HAVE BEEN INCORPORATED INTO IT AS A RESULT. THOSE RELYING ON THIS RECORD DOCUMENT ARE ADVISED TO OBTAIN INDEPENDENT VERIFICATION OF IT'S ACCURACY BEFORE APPLYING IT FOR ANY PURPOSE.

PROCESS SYMBOL LEGEND	
TANKS	
SANITARY SEWER MANHOLE	
JUNCTION BOX	
VALVE	
CHECK VALVE	
10 HP BRUSH AERATOR	
METER	
NORMALLY OPEN	NO
NORMALLY CLOSED	NC
EXISTING SYSTEM WASTEWATER	
WATER	
REUSE EFFLUENT	
SUCTION TYPE COMPOSITE SAMPLER	
PARSHALL FLUME/ULTRASONIC FLOW METER	
MANUAL BARSCREEN	
MECHANICAL BARSCREEN	
ASPIRATING AERATOR	
WEIR	
TO BE DEMOLISHED/REMOVED /ABANDONED IN PLACE	
SLUICE GATE	
SLIDE GATE/STOP GATE	
SUBMERSIBLE PUMP	



NAVAJO TRIBAL UTILITY AUTHORITY GANADO, ARIZONA	
NO.	DATE
5	
4	
3	
2	
1	

**GANADO WASTEWATER TREATMENT PLANT
LAGOON UPGRADE**

CIVIL
FLOW SCHEMATIC

**SOLUTIONS FOR TODAY...
VISION FOR TOMORROW**


2201 San Pedro Dr. NE
Building 4, Suite 200
Albuquerque, NM 87110
Phone: (505) 884-0700
Fax: (505) 884-2376
TEXAS



JOB NO:
115111

DATE:
APR 2016

SHEET NO:
4

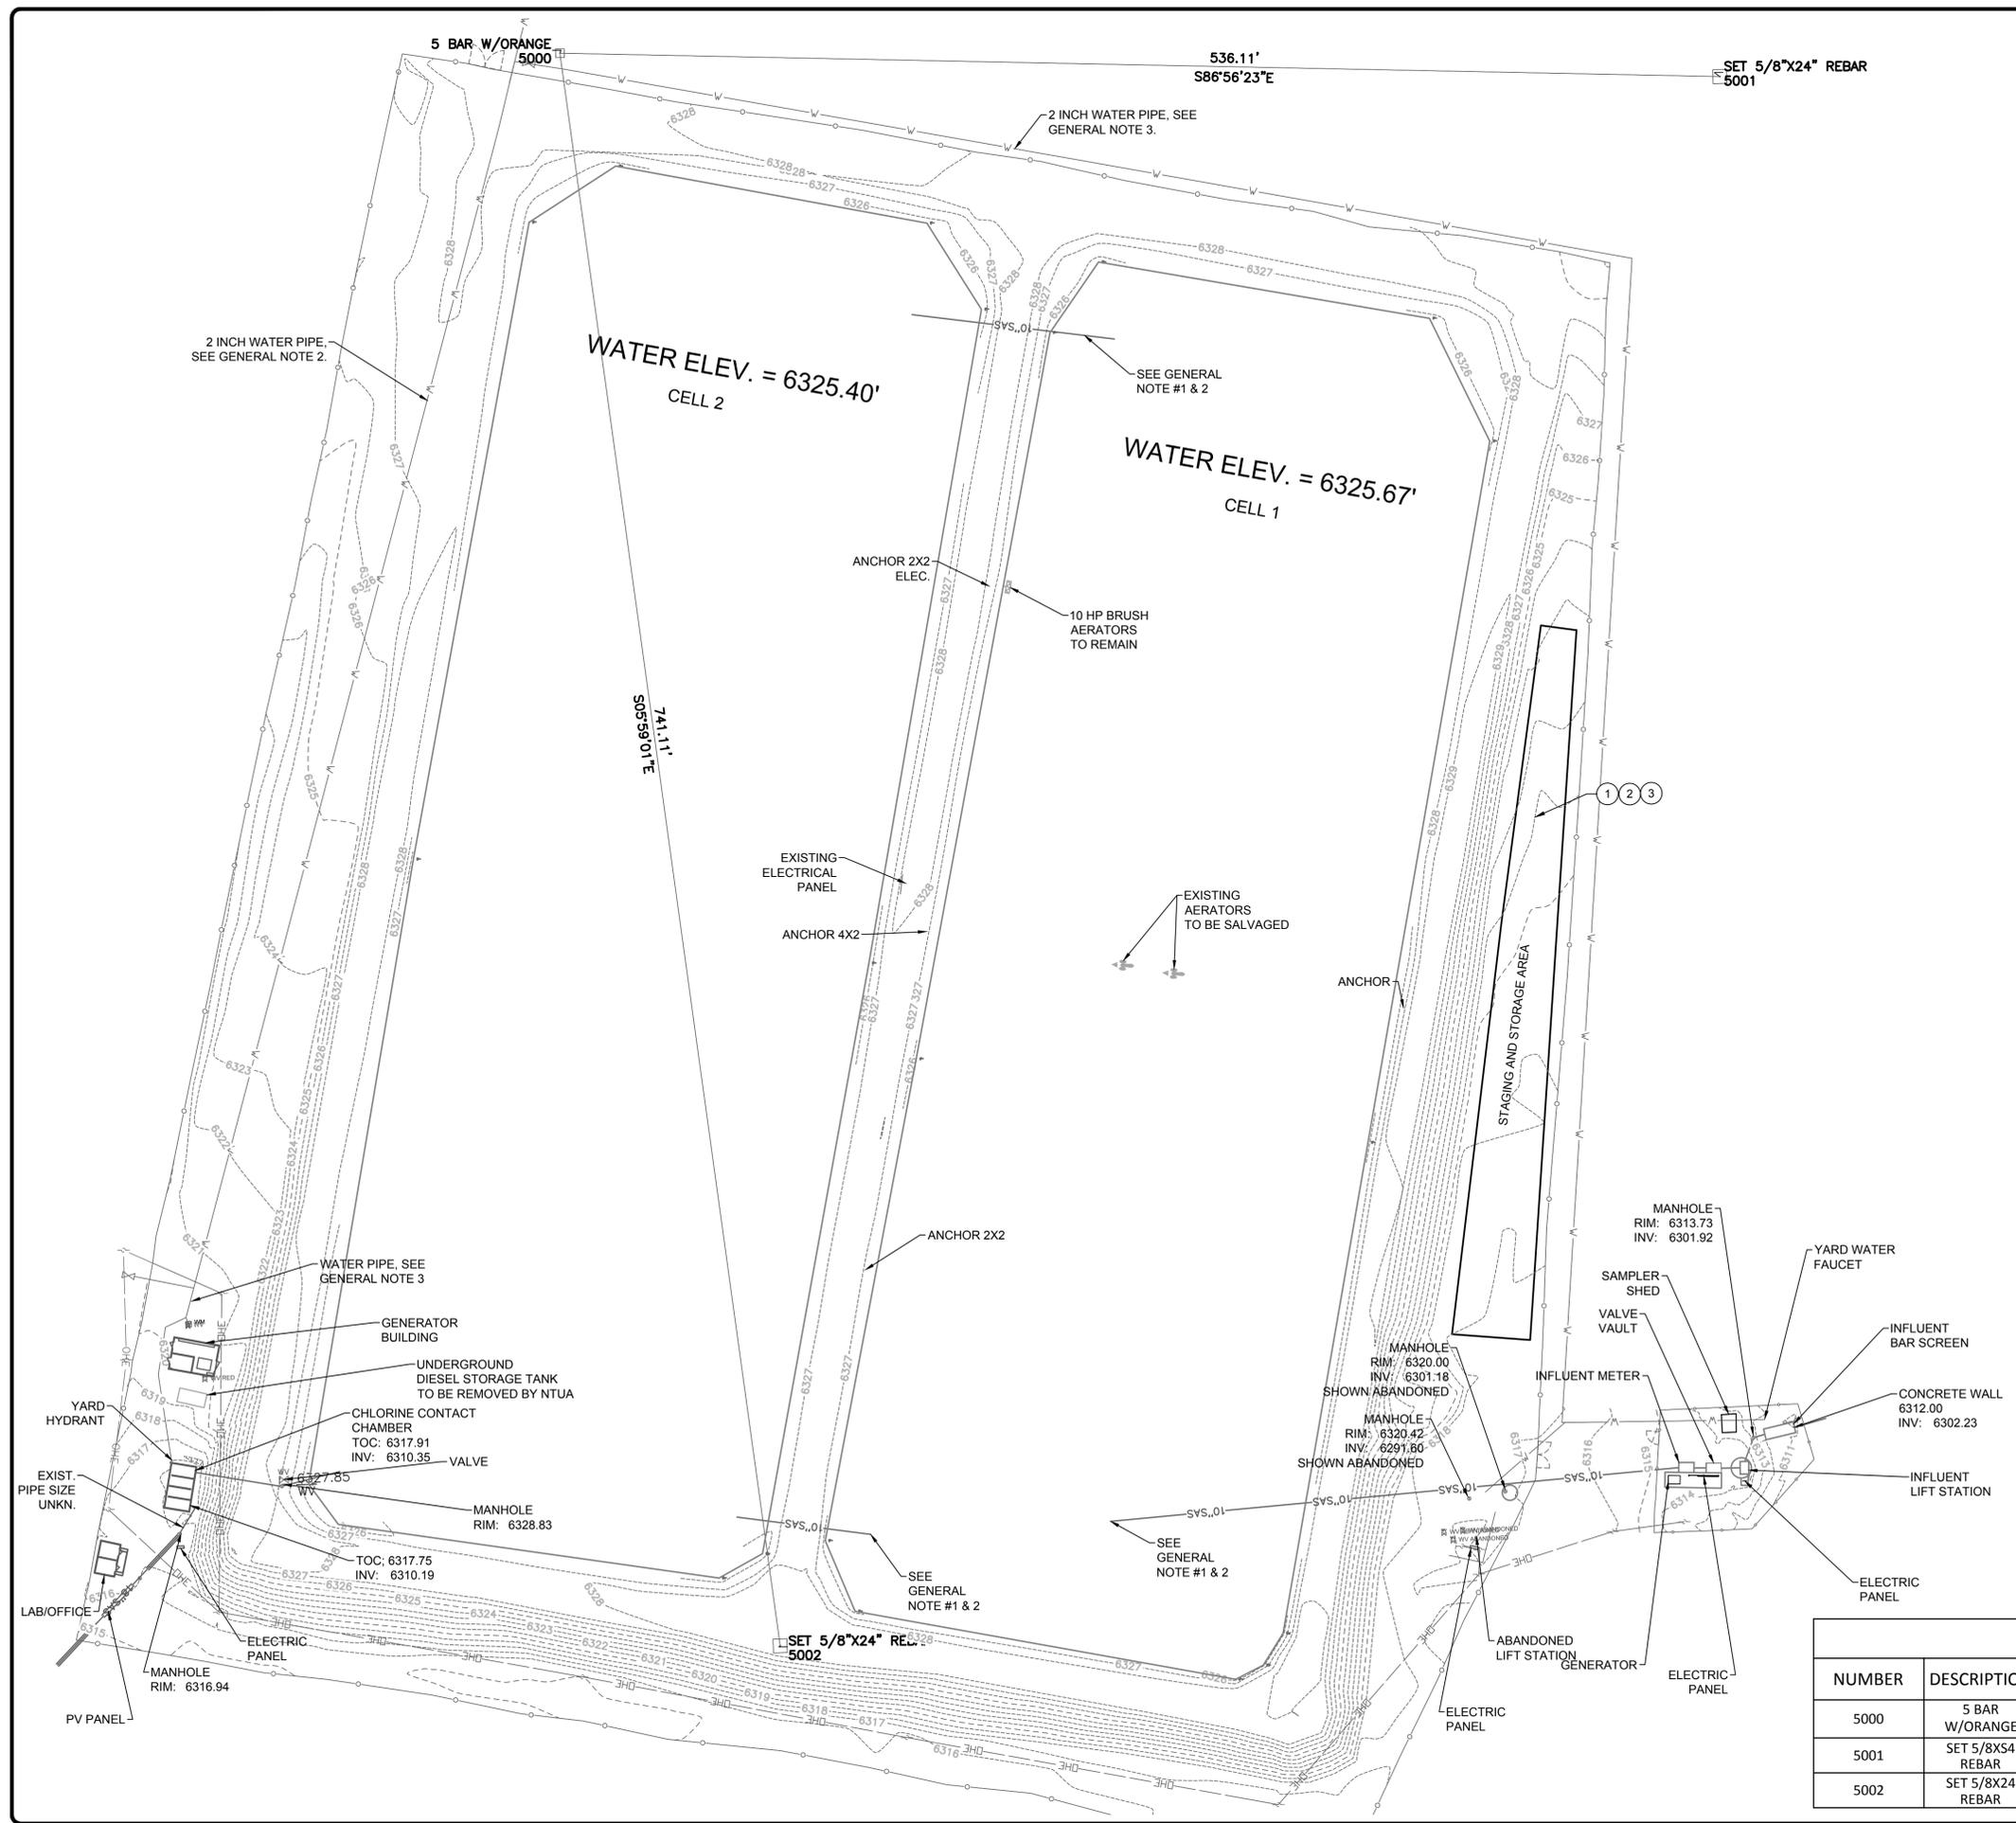

- ### BUILD NOTES
- CONSTRUCTION STAKING: CONTRACTOR TO PERFORM ALL NECESSARY SURVEYING AND CONSTRUCTION STAKING INCLUDING FINAL AS-BUILT PREPARATION, COMPLETE. SEE SPECIFICATION 01 78 39.
 - NPDES PERMITTING: IF NECESSARY, CONTRACTOR SHALL PREPARE AND IMPLEMENT A SWPPP TO INCLUDE SILT FENCING (3-FEET HIGH WITH 5-FEET STEEL POSTS AT 10-FEET O.C.) AND ALL BEST MANAGEMENT PRACTICES AS REQUIRED. SEE GENERAL NOTES AND SPECIFICATION SECTION 01 57 23, COMPLETE AND IN PLACE.
 - CLEAR & GRUB SITE AS NECESSARY FOR WORK INCLUDING REMOVAL OF NATURAL AND MANMADE OBJECTIONABLE MATERIALS FROM THE PROJECT SITE, PURSUANT TO STD. SPEC. 201, COMPLETE.

- ### GENERAL NOTES
- PIPE DRAWN PER AND LABELED ASBUILTS NA-2-2841 (1973) CONTRACTOR TO FIELD LOCATE.
 - WATER LEVEL & DEBRIS PREVENTED SURVEYOR FROM LOCATING INTERPOND PIPING.
 - ONSITE WATER PIPING BASED ON NTUA GIS DATA DATED 2007. CONTRACTOR TO CONFIRM SIZE, MATERIAL, AND BURY DEPTH IF NECESSARY FOR CONSTRUCTION.
 - WTR PIPE SIZE AND LOCATION AFTER TEE UNKNOWN. CONTRACTOR TO FIELD LOCATE AS NECESSARY.

SURVEY NOTES


BASIS OF LOCAL PROJECTION: TRANSVERSE MERCATOR PROJECTION

ALL DISTANCE DIMENSIONS US SURVEY FEET.
 LATITUDE: 35° 42' 36.00000" N
 LONGITUDE: 109° 33' 36.00000" W NAD_83(2011)
 FALSE NORTHING: 20000.00000sf
 FALSE EASTING: 20000.00000sf
 SCALE FACTOR: 1.00029962

BASIS OF ELEVATION: NAVD88 AS PREDICTED BY GEOID12A (CONUS)

RECORD DRAWING

THIS RECORD DRAWING HAS BEEN PREPARED, IN PART, BASED UPON INFORMATION FURNISHED BY OTHERS. WHILE THE INFORMATION IS BELIEVED TO BE RELIABLE, THE ENGINEER CANNOT ASSURE IT'S ACCURACY, & IS NOT RESPONSIBLE FOR THE ACCURACY OF THIS RECORD DRAWING OR ANY ERRORS OR OMISSIONS WHICH MAY HAVE BEEN INCORPORATED INTO IT AS A RESULT. THOSE RELYING ON THIS RECORD DOCUMENT ARE ADVISED TO OBTAIN INDEPENDENT VERIFICATION OF IT'S ACCURACY BEFORE APPLYING IT FOR ANY PURPOSE.

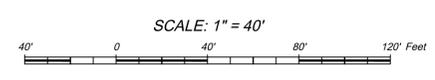

CONTROL POINT TABLE TO CP 5000

NUMBER	DESCRIPTION	ELEVATION	NORTHING	EASTING	BEARING	LENGTH
5000	5 BAR W/ORANGE	6328.7600	20539.4300	18540.9000	--	--
5001	SET 5/8XS4 REBAR	6337.8400	20510.8000	19076.2500	S86°56'23"E	536.11'
5002	SET 5/8X24 REBAR	6328.3500	19802.3500	18618.1600	S05°59'01"E	741.11'

NAVAJO TRIBAL UTILITY AUTHORITY GANADO, ARIZONA	GANADO WASTEWATER TREATMENT PLANT LAGOON UPGRADE
SURVEY CONTROL & EXISTING CONDITIONS CIVIL	SURVEY CONTROL & EXISTING CONDITIONS CIVIL

SOLUTIONS FOR TODAY... VISION FOR TOMORROW

2201 San Pedro Dr. NE
 Building 4, Suite 200
 Albuquerque, NM 87110
 Phone: (505) 884-0700
 Fax: (505) 884-2376

SMITH ENGINEERING
CONSTRUCTION


NEW MEXICO

NAVJO TRIBAL UTILITY AUTHORITY
 GANADO, ARIZONA


DATE: **APR 2016**

SHEET NO: **5**


- NOTE:
- EXCEPT AS SPECIFICALLY SHOWN OTHERWISE, GUARDRAILS SHALL BE ATTACHED TO THE SIDE OF CONCRETE MEMBERS AS SHOWN IN DETAIL A THIS SHEET. GUARDRAILS EMBEDDED IN CONCRETE MEMBERS ARE NOT ALLOWED EXCEPT WHERE SHOWN ON THE STRUCTURAL DRAWINGS.
 - KICK PLATE IS NOT REQUIRED WHERE TOP OF FRAMING FOR GRATING IS 4 INCHES ABOVE TOP OF GRATING.
 - MATERIAL - ALUMINUM ALLOY 6063-T6, CLEAR SATIN ANODIZED FINISH ALL EXPOSED SURFACES (0.4 MIL THICKNESS FOR ALL CAST COMPONENTS, 0.7 MIL THICKNESS FOR EXTRUDED COMPONENTS).
 - CONNECTIONS - COPE MEMBERS AND CONTINUOUSLY WELD OR CONNECT MECHANICALLY AT ALL JUNCTIONS TO PROVIDE FINISHED APPEARANCE SIMILAR TO WELDED SYSTEM. GRIND ALL WELDS SMOOTH TO MATCH FINISH OF ADJACENT MEMBERS.

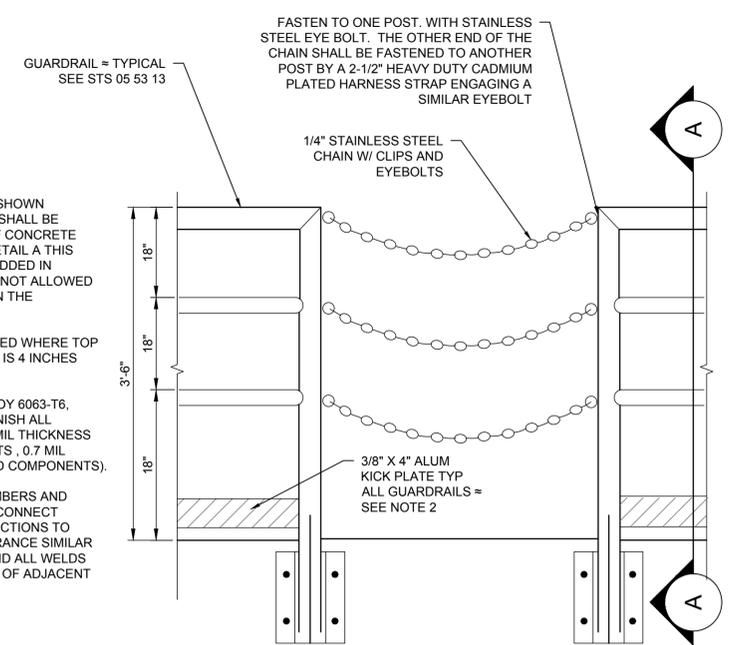


1 TYPICAL GUARDRAIL ELEVATION
NOT TO SCALE

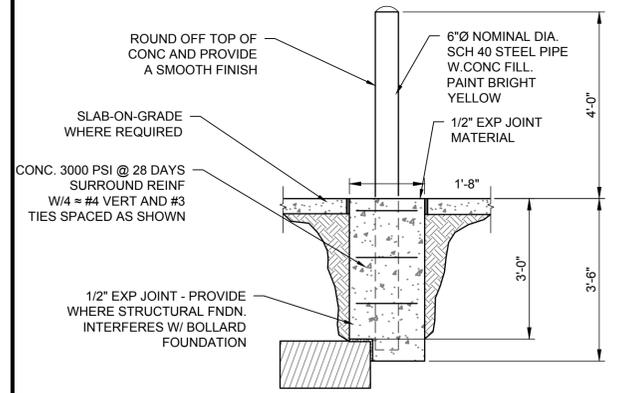

5 TYPICAL STATIONARY BOLLARD DETAIL
NOT TO SCALE

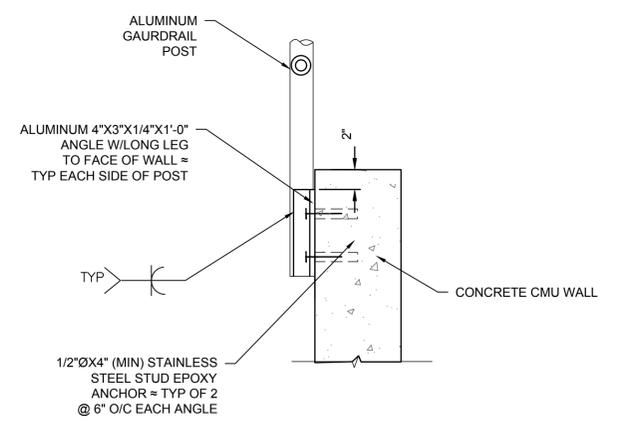


A GUARDRAIL CONNECTION SECTION
NOT TO SCALE

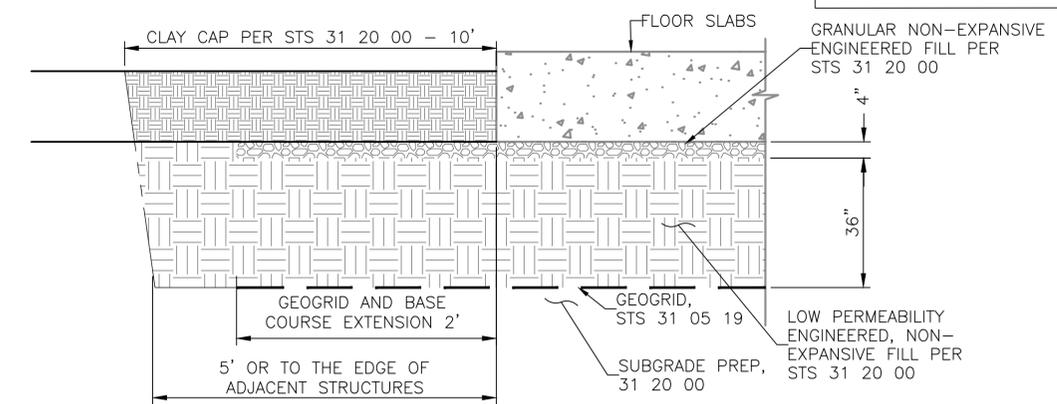


- NOTES:
- EXCAVATION SHALL NOT UNDERMINE THE STRUCTURAL INTEGRITY OF ANY ADJACENT STRUCTURES.

2 FLOOR SLAB EARTHWORK DETAIL
NOT TO SCALE

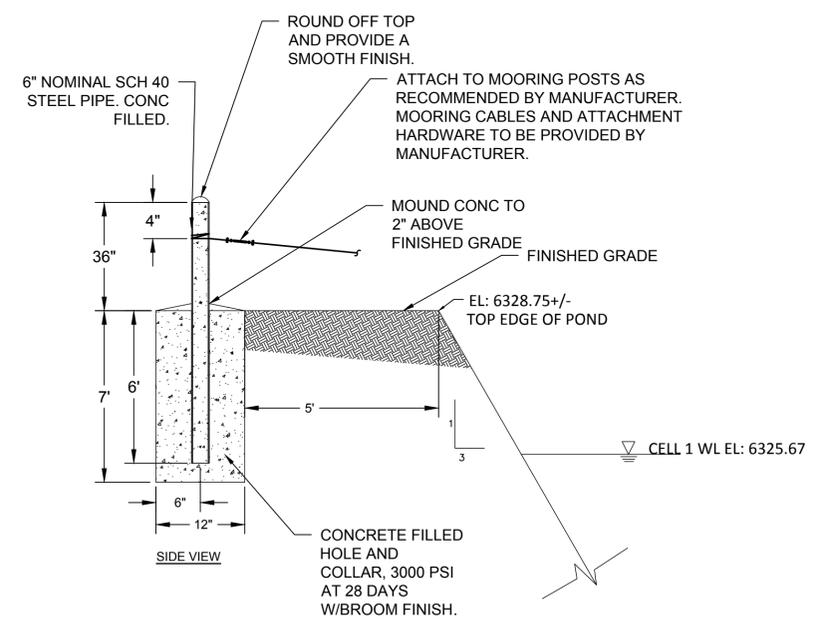

- GENERAL NOTES
- MOORING POSTS TO BE PROVIDED BY CONTRACTOR.
 - EXPOSED STEEL TO BE PAINTED WITH AN OIL BASE ALKYD PRIMER AND AN OIL BASE ALKYD ENAMEL TOP COAT. COLOR TO BE BRIGHT YELLOW.

3 AERATOR ANCHOR POST
NOT TO SCALE

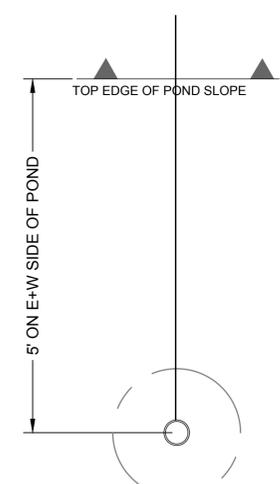

4 TOP VIEW OF AERATOR ANCHOR POST
NOT TO SCALE

TABLE 2
DISTANCE BETWEEN MOORS (ANCHOR POSTS)

ROW	DISTANCE (FT)
1	230
2	228
3	232

NOTE: DOES NOT INCLUDE ADDITIONAL LENGTHS FOR SLACKING OF CABLING OR FOR ATTACHING TO MOORING POSTS.

RECORD DRAWING

THIS RECORD DRAWING HAS BEEN PREPARED, IN PART, BASED UPON INFORMATION FURNISHED BY OTHERS. WHILE THE INFORMATION IS BELIEVED TO BE RELIABLE, THE ENGINEER CANNOT ASSURE IT'S ACCURACY, & IS NOT RESPONSIBLE FOR THE ACCURACY OF THIS RECORD DRAWING OR ANY ERRORS OR OMISSIONS WHICH MAY HAVE BEEN INCORPORATED INTO IT AS A RESULT. THOSE RELYING ON THIS RECORD DOCUMENT ARE ADVISED TO OBTAIN INDEPENDENT VERIFICATION OF IT'S ACCURACY BEFORE APPLYING IT FOR ANY PURPOSE.



NAVAJO TRIBAL UTILITY AUTHORITY
GANADO, ARIZONA

NO.	REVISION DESCRIPTION	DATE	BY
5	###	###	###
4	###	###	###
3	###	###	###
2	###	###	###
1	###	###	###


GANADO WASTEWATER TREATMENT PLANT

CIVIL
CIVIL DETAILS

SOLUTIONS FOR TOMORROW...
VISION FOR TOMORROW

2201 San Pedro Dr. NE
Building 4, Suite 200
Albuquerque, NM 87110
Phone: (505) 884-0700
Fax: (505) 884-2376
TEXAS




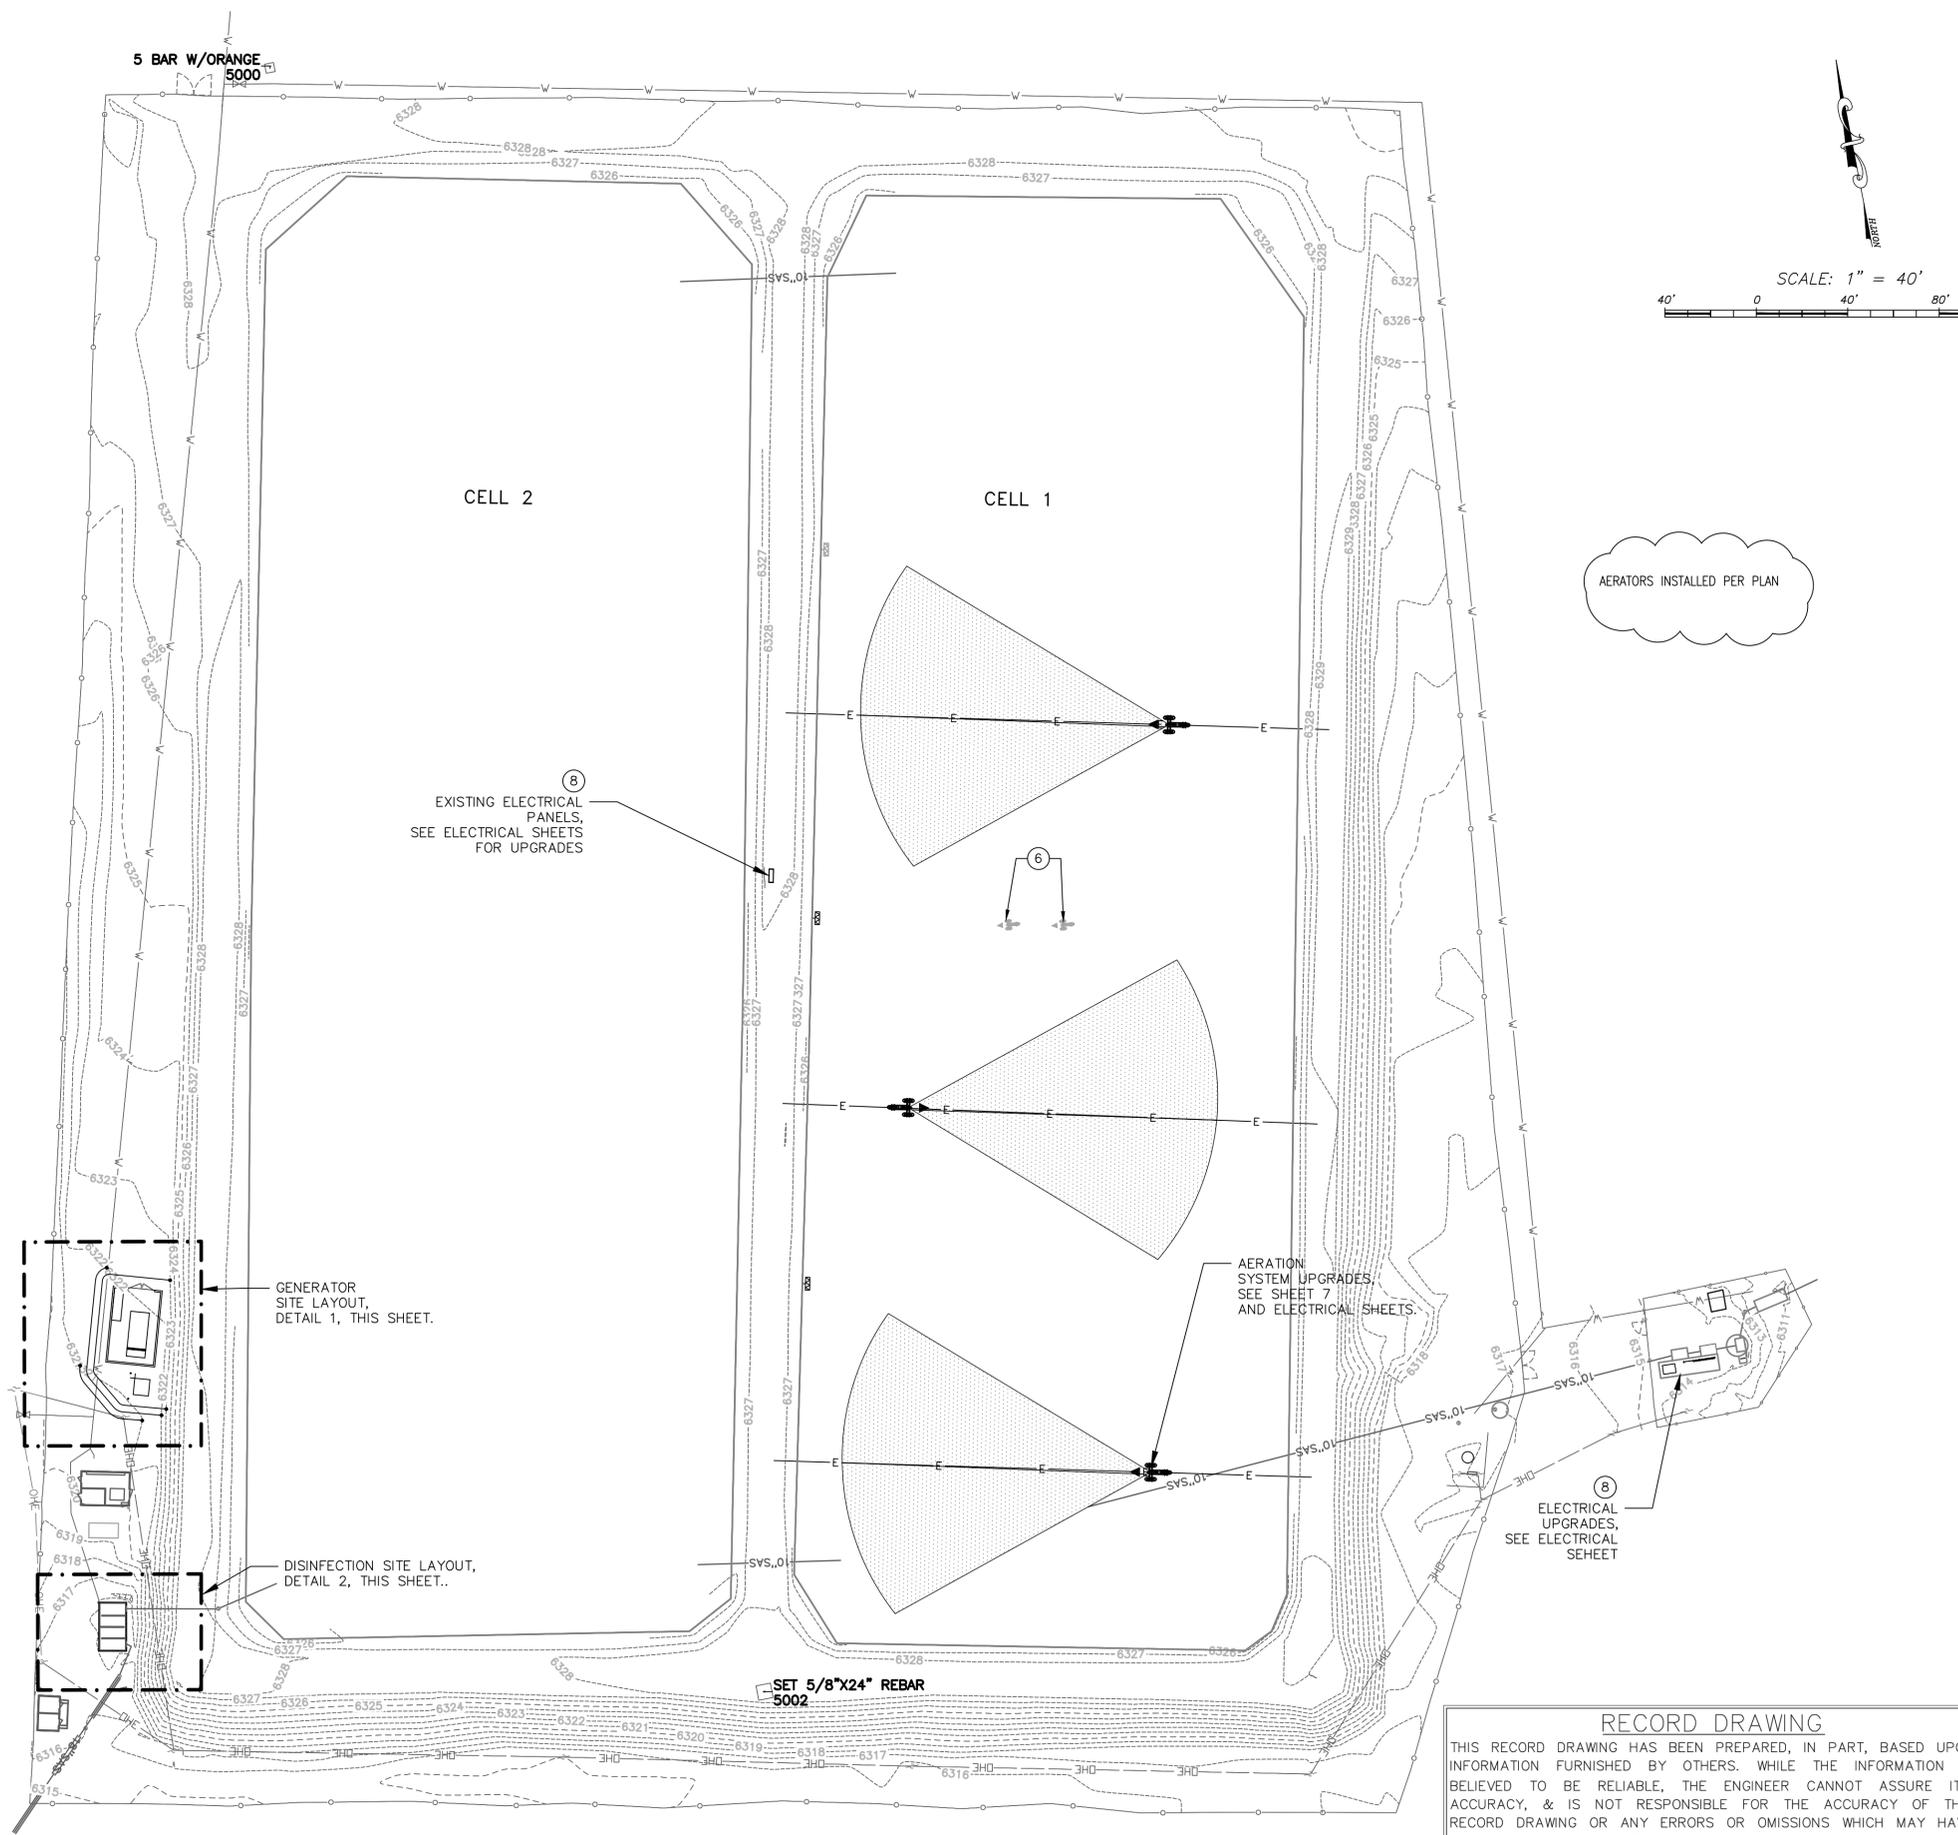


RECORD DRAWING

THIS RECORD DRAWING HAS BEEN PREPARED, IN PART, BASED UPON INFORMATION FURNISHED BY OTHERS. WHILE THE INFORMATION IS BELIEVED TO BE RELIABLE, THE ENGINEER CANNOT ASSURE ITS ACCURACY, & IS NOT RESPONSIBLE FOR THE ACCURACY OF THIS RECORD DRAWING OR ANY ERRORS OR OMISSIONS WHICH MAY HAVE BEEN INCORPORATED INTO IT AS A RESULT. THOSE RELYING ON THIS RECORD DOCUMENT ARE ADVISED TO OBTAIN INDEPENDENT VERIFICATION OF ITS ACCURACY BEFORE APPLYING IT FOR ANY PURPOSE.

BUILD NOTES

- STRUCTURAL CONCRETE: FURNISH AND INSTALL REINFORCED PORTLAND CEMENT CONCRETE PER STRUCTURAL SHEETS, COMPLETE AND IN PLACE.
- SUBGRADE PREP: PREPARE SUBGRADE FOR STRUCTURES INCLUDES EXCAVATION (3FT BELOW BOTTOM FOUNDATION ELEV.) AND COMPACT PER STS 31 20 00, COMPLETE.
- STRUCTURAL FILL: FILL CONSTRUCTION FOR STRUCTURES INCLUDING PLACEMENT AND COMPACTION OF SUITABLE ENGINEERED FILL MATERIAL (STS 31 20 00) AND REINFORCING GEOGRID (STS 31 05 19), COMPLETE.
- DRIVE GATE: FURNISH AND INSTALL DRIVE GATE WITH PER STRUCTURAL SHEETS, COMPLETE AND IN PLACE.
- EXCAVATE AND SPOIL UNSUITABLE MATERIAL PER STD SPEC 206, COMPLETE.
- ROUGH AND FINAL GRADING: GRADE SITE PER GEOTECHNICAL REPORT AND THIS SHEET. FINAL GRADE TO BE WITHIN 0.1 FT.±, COMPLETE AND IN PLACE.
- ALUMINUM HANDRAIL: FURNISH AND INSTALL ALUMINUM HAND RAILING ON EXTERIOR WALLS OF CHLORINE CONTACT TANK, SEE SHEET 6 COMPLETE AND IN PLACE.
- CLEAR & GRUB SITE AS NECESSARY FOR WORK INCLUDING REMOVAL OF NATURAL AND MANMADE OBJECTIONABLE MATERIALS FROM THE PROJECT SITE, PURSUANT TO STD. SPEC. 201, COMPLETE.
- BOLLARDS: FURNISH AND INSTALL STATIONARY BOLLARDS PER DETAILS ON SHEET 6.
- REMOVE AND SALVAGE EXISTING AERATION EQUIPMENT.

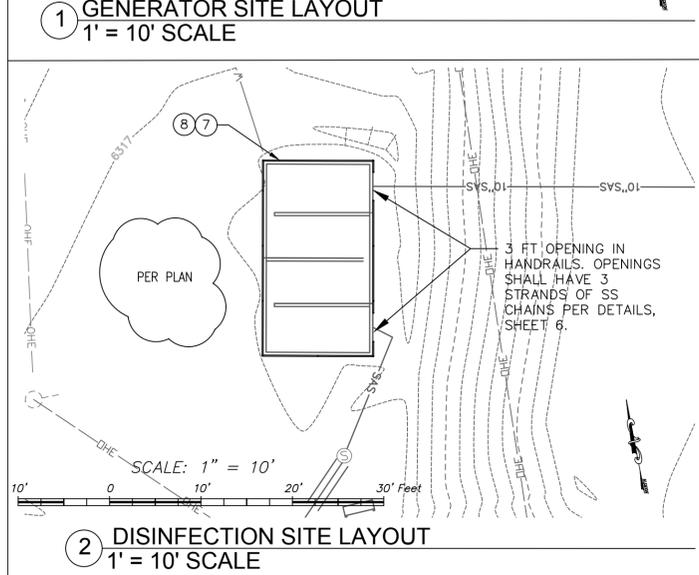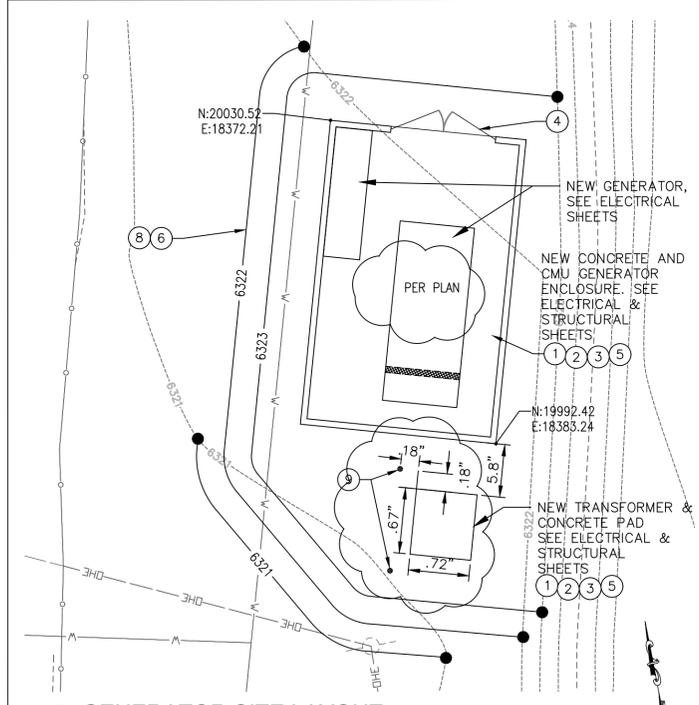

NAVAJO TRIBAL UTILITY AUTHORITY
GANADO, ARIZONA

NO.	REVISION DESCRIPTION	DATE	BY
5			
4			
3			
2			
1			

**GANADO WASTEWATER TREATMENT PLANT
LAGOON UPGRADE**

CIVIL
SITE UPGRADES

**SOLUTIONS FOR TODAY...
VISION FOR TOMORROW**

2201 San Pedro Dr. NE
Building 4, Suite 200
Albuquerque, NM 87110
Phone: (505) 884-0700
Fax: (505) 884-2376
TEXAS




JOB NO:
115111

DATE:
APR 2016

SHEET NO:
7

© SEC - PROJECT 8115111 NTUA NNEPA Compliance Plan Assatance Lagoon Systems/CONSTRUCT/115111-2 GANADO WWT/Record_DWG/8/GANADO/PLANS/17 SITE UPGRADES.dwg Feb 16, 2017 - 2:59pm Saved By: Raib

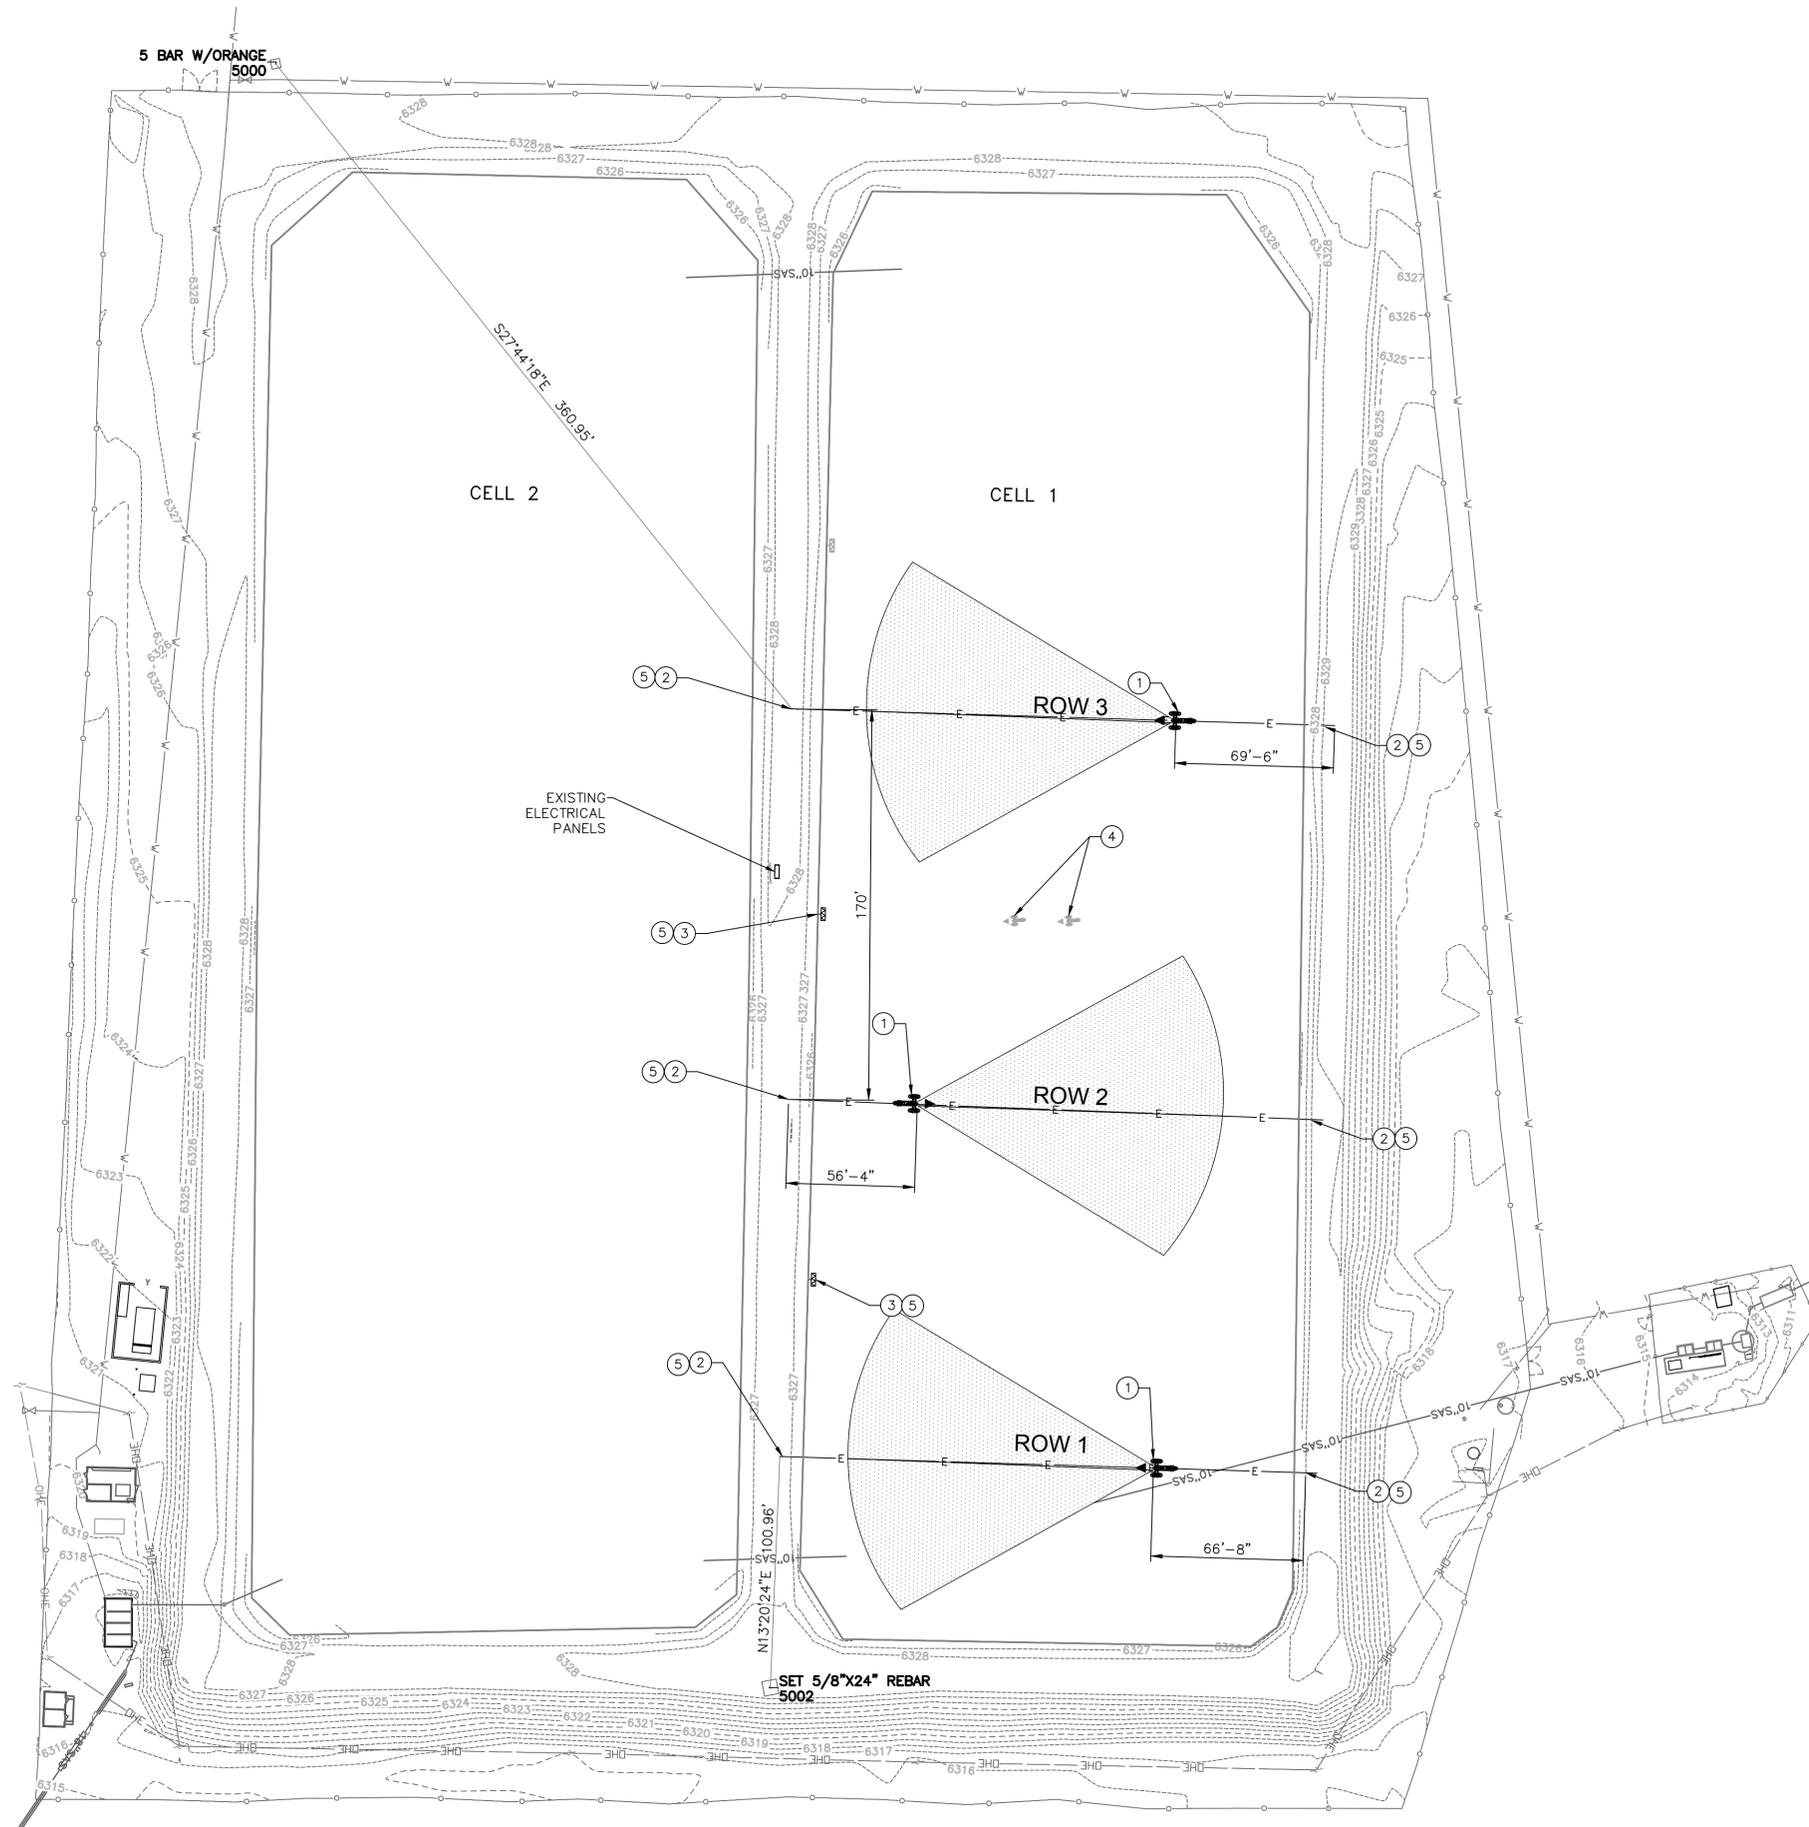

- BUILD NOTES**
- 1 INSTALL 25-HP AIRO-02 ASPIRATING AERATOR BY AERATION INDUSTRIES INTERNATIONAL, LLC. COMPLETE IN PLACE AND OPERATING. INCLUDES ELECTRICAL CABLES, MOORING CABLES, ETC. COMPLETE IN PLACE AND OPERATING. AERATORS AND AERATION CONTROL PANELS PROVIDED BY OWNER.
 - 2 FURNISH AND INSTALL MOORING POSTS, CABLES, AND CONNECTIONS AS SHOWN IN DETAILS.
 - 3 INSTALL BRUSH AERATORS. BRUSH AERATORS TO BE FURNISHED BY OWNER.
 - 4 REMOVE AND SALVAGE EXISTING FLOATING AERATORS.
 - 5 CLEAR & GRUB SITE AS NECESSARY FOR WORK INCLUDING REMOVAL OF NATURAL AND MANMADE OBJECTIONABLE MATERIALS FROM THE PROJECT SITE. PURSUANT TO STD. SPEC. 201, COMPLETE.

RECORD DRAWING

THIS RECORD DRAWING HAS BEEN PREPARED, IN PART, BASED UPON INFORMATION FURNISHED BY OTHERS. WHILE THE INFORMATION IS BELIEVED TO BE RELIABLE, THE ENGINEER CANNOT ASSURE IT'S ACCURACY, & IS NOT RESPONSIBLE FOR THE ACCURACY OF THIS RECORD DRAWING OR ANY ERRORS OR OMISSIONS WHICH MAY HAVE BEEN INCORPORATED INTO IT AS A RESULT. THOSE RELYING ON THIS RECORD DOCUMENT ARE ADVISED TO OBTAIN INDEPENDENT VERIFICATION OF IT'S ACCURACY BEFORE APPLYING IT FOR ANY PURPOSE.



NAVAJO TRIBAL UTILITY AUTHORITY
GANADO, ARIZONA

NO.	REVISION DESCRIPTION	DATE	BY
5			
4			
3			
2			
1			

GANADO WASTEWATER TREATMENT PLANT
LAGOON UPGRADE

CIVIL
AERATION SYSTEM UPGRADES

**SOLUTIONS FOR TODAY...
VISION FOR TOMORROW**

2201 San Pedro Dr. NE
Building 4, Suite 200
Albuquerque, NM 87110
Phone: (505) 884-0700
Fax: (505) 884-2376
TEXAS



JOB NO:
115111

DATE:
APR 2016

SHEET NO:
8

GENERAL STRUCTURAL NOTES

APPLY UNLESS NOTED ON STRUCTURAL DRAWINGS. IN CASE OF CONFLICT BETWEEN GSN, DETAILS AND PLANS, THE GREATER REQUIREMENTS GOVERN.

CODE:

COMPLY WITH 2012 INTERNATIONAL BUILDING CODE.
 OCCUPANCY CATEGORY: III
 SEISMIC IMPORTANCE FACTOR: IE=1.0
 MAPPED SPECTRAL RESPONSE ACCELERATION: SMs=0.381, SM1=0.125
 SITE COEFFICIENT: Fa=1.6, Fv=2.4
 SITE CLASS: D
 SPECTRAL RESPONSE COEFFICIENT: Sds=0.254, Sd1=0.083
 SEISMIC DESIGN CATEGORY: B
 SEISMIC-FORCE-RESISTING SYSTEM: MASONRY WALLS
 RESPONSE MODIFICATION FACTOR: R=3.5
 SEISMIC RESPONSE COEFFICIENT: Cs=0.091
 ANALYSIS PROCEDURE USED: SIMPLIFIED METHOD
 BASIC WIND SPEED: 90 MPH
 WIND IMPORTANCE FACTOR: Iw=1.0
 BUILDING CATEGORY: OPEN
 EXPOSURE: C
 DESIGN WIND PRESSURE FOR MWFRS:
 ZONE A = 24.8 PSF
 ZONE C = 16.6 PSF
 THERMAL FACTOR: Ct=1.0
 DEAD LOADS: 20 PSF
 LIVE LOADS: 20 PSF

ELECTRICAL LOADS: SEE ELECTRICAL DRAWINGS. VERIFY ANY LOADS SHOWN ON STRUCTURAL DRAWINGS WITH ELECTRICAL DRAWINGS.

FOUNDATIONS:

BELOW GRADE FOUNDATIONS SHALL BEAR ON A MINIMUM OF THREE (3) FEET OF GRANULAR NON-EXPANSIVE ENGINEERED FILL UNDERLAIN BY A REINFORCING GEOGRID.
 SLABS SHOULD BEAR ON THREE (3) FEET OF NON-EXPANSIVE LOW PERMEABILITY ENGINEERED FILL.
 FILL MATERIALS ARE TO CONFORM TO GRADATION AS SPECIFIED IN STS 31 20 00, EARTHWORK.
 ENGINEERED FILL OR OTHER APPROVED GRANULAR SOILS SHOULD BE PLACED IN A MAXIMUM LIFT NOT TO EXCEED 8". MATERIAL IS TO BE COMPACTED TO 95% ASTM D698 PER STS 31 20 00, EARTHWORK.
 THE GEOGRID SHOULD BE PER STS 31 0519, GEOGRID FOR EARTHWORK.
 ALL EARTHWORK, FOOTING DEPTHS, AND EXCAVATIONS FOR FOUNDATIONS SHALL BE INSPECTED BY THE ENGINEER TO VERIFY ASSUMED ALLOWABLE SOIL BEARING AND LOW SETTLEMENT AND SWELL POTENTIAL, AND TO MAKE ANY ADDITIONAL RECOMMENDATIONS.

CONCRETE:

SHALL MEET ALL THE REQUIREMENTS OF THE CURRENT ISSUE OF THE ACI MANUAL OF CONCRETE PRACTICE, WITH TYPE I-II CEMENT. MINIMUM 28 DAY STRENGTH, 3000 PSI, EXCEPT AS FOLLOWS:
 FOUNDATIONS, GRADE BEAMS, OR ANY OTHER CONCRETE
 IN CONTACT WITH EARTH.....3000 PSI (MAX W/C = 0.45)
 CAST IN PLACE SLABS NOT ON GRADE.....4000 PSI
 MAXIMUM SLUMP:
 FOR ALL CONCRETE.....5"
 CONTRACTOR SHALL SUBMIT FOR APPROVAL CONCRETE MIX DESIGNS FOR EACH CLASS OF CONCRETE. THE MIX SUBMITTAL SHALL INDICATE WHICH OF THE FOLLOWING ACI 318 METHODS THE CONCRETE SUPPLIER ALONG WITH HIS TESTING LAB INTENDS TO USE FOR CONCRETE PROPORTIONING - THE FIELD EXPERIENCE METHOD, THE LABORATORY TRIAL MIXTURE METHOD OR A COMBINATION OF BOTH. IF CONSECUTIVE TESTS (15 TO 30) ARE BEING RELIED UPON PER ACI 318, SECTION 5.3 THOSE TESTS SHALL BE SUBMITTED ALONG WITH THE MIX DESIGNS. MIX DESIGNS SHALL BEAR THE STAMP OF AN ENGINEER LICENSED IN THE STATE OF ARIZONA.
 NO ADMIXTURES SHALL BE USED WITHOUT APPROVAL. NO AIR ENTRAINMENT SHALL BE ALLOWED IN FLAT SLABS. ADMIXTURES CONTAINING CHLORIDES SHALL NOT BE USED. CONCRETE SHALL NOT BE IN CONTACT WITH ALUMINUM. MECHANICALLY VIBRATE ALL CONCRETE WHEN PLACED. EXCEPT THAT SLABS ON GRADE NEED BE VIBRATED ONLY AROUND EMBEDDED ITEMS. DO NOT TAMP SLABS. USE ROLLER BUG, VIBRATING SCREED OR BULL FLOAT TO FINISH. SEE SPECIFICATIONS FOR CURING.
 MINIMUM STRENGTH FOR REMOVAL OF FORMS AND SHORING SHALL BE 75% OF SPECIFIED STRENGTH AT 28 DAYS.
 FLY ASH (POZZOLAN) IF PERMITTED PER SPECIFICATIONS SHALL NOT EXCEED 25% REPLACEMENT OF TOTAL CEMENT CONTENT USING A 1:1 REPLACEMENT FACTOR.

MASONRY:

BLOCK UNITS: GRADE N-1, RUNNING BOND. PRISM STRENGTH = 1500 PSI. MORTAR TYPE S, 1800 PSI. GROUT 2000 PSI. ALL CONSTRUCTION BELOW GRADE OR IN CONTACT WITH SOIL SHALL USE TYPE I-II CEMENT FOR MASONRY UNITS, GROUT AND MORTAR. OTHER CONDITIONS MAY BE TYPE II CEMENT. NO POZZOLAN WILL BE PERMITTED IN MORTAR.
 MECHANICALLY VIBRATE GROUT IN VERTICAL CELLS IMMEDIATELY AFTER POURING AND AGAIN ABOUT 5 MINUTES LATER. MAXIMUM GROUT LIFT WITHOUT CLEANOUTS 5'-0". STAY EACH END OF EACH VERTICAL REBAR USING SINGLE WIRE AND LOOP TYPE TIES. MAXIMUM VERTICAL SPACING OF TIES 8'-0".
 MASONRY WALLS TO BE PARTIALLY GROUTED. GROUT REQUIRED: IN CELLS WITH REINFORCING, BOND BEAMS, LINTELS, AROUND EMBEDS AND OTHER LOCATIONS SPECIFICALLY CALLED FOR ON PLANS.
 8" WALL VERTICAL REINFORCING: LOCATE REINFORCING IN CENTER OF GROUT, AT CENTER OF WALL, CONTINUOUS FULL HEIGHT OF WALL AS FOLLOWS:
 (1) #5 AT ALL CORNERS, INTERSECTIONS, WALL ENDS, JAMBS, AND EACH SIDE OF EXPANSION OR CONTROL JOINTS.
 (1) #5 AT 24" O.C. ELSEWHERE, U.N.O.
 HORIZONTAL REINFORCING: (1) #5 IN MINIMUM 8" DEEP GROUTED CONTINUOUS BOND BEAM AT FLOOR LINES AND TOP OF WALL. HORIZONTAL REINFORCING SHALL BE CONTINUOUS UNLESS NOTED OTHERWISE ON PLANS. GROUT BARRIER BELOW BOND BEAMS SHALL BE CONTINUOUS WIRE LATH. PROVIDE LADDER TYPE #9 JOINT REINFORCING AT 16" O.C.
 WALLS NOTED ON PLANS AS "SOLID GROUTED" SHALL HAVE (1) #5 HORIZONTAL REINFORCING IN BOND BEAM AT 40" MAXIMUM, AND PROVIDE (1) #5 IN BOND BEAM AT FLOOR, AND TOP OF WALLS.
 WEDGE AND SLEEVE TYPE ANCHORS SHALL NOT BE PERMITTED IN MASONRY CONSTRUCTION WITHOUT PRODUCT ICC REPORT AND PREAPPROVAL.
 MASONRY REINFORCING SHOP DRAWINGS SHALL BE PROVIDED TO ENGINEER FOR APPROVAL PRIOR TO FABRICATION.

REINFORCING:

LATEST ACI CODE AND DETAILING MANUAL APPLY. ALL REINFORCING BARS DEFORMED EXCEPT #2 BARS AND WIRE MESH.
 ALL REINFORCING SHALL BE ASTM A-615 GRADE 60 EXCEPT AS FOLLOWS:
 SPIRALS.....GRADE 60 OR COLD DRAWN A-82 #2 AND #3 BARS.....GRADE 40 WIRE MESH.....A-185 WELDED ANCHORS.....GRADE 40 CHEMICAL ANALYSIS LIMITED PER AWS SPECIFICATIONS FOR WELD WITHOUT PREHEAT. WELDED ANCHORS #5 AND LARGER.....ASTM A-706
 CLEAR CONCRETE COVER TO REINFORCING ARE AS FOLLOWS:
 CAST-IN-PLACE CONCRETE (NONPRESTRESSED):
 CAST AGAINST AND PERMANENTLY EXPOSED TO EARTH.....3"
 EXPOSED TO EARTH OR WEATHER:
 #6 THROUGH #18.....2"
 #5 AND SMALLER.....1 1/2"
 NOT EXPOSED TO WEATHER OR IN CONTACT WITH GROUND:
 SLABS, WALLS: #11 AND SMALLER.....1 1/2"
 FOR TYPICAL BAR BENDS, SEE DETAIL 2/11.
 LAP SPLICES IN MASONRY SHALL BE PER DETAIL 1/11.
 LAP SPLICES IN CONCRETE SHALL BE CLASS B TENSION LAPS, 70 BAR Ø MIN.
 WHERE BARS ARE SHOWN SPLICED, THEY MAY RUN CONTINUOUS AT CONTRACTOR'S OPTION.
 PROVIDE SHOP DRAWINGS AND FABRICATE AFTER THE CONTRACTORS REVIEW. ALL SPLICE LOCATIONS ARE SUBJECT TO APPROVAL. PLACE REBAR PER CRSI STANDARDS.
 REBAR SPACING GIVEN IS MAXIMUM ON CENTER AND ALL REBAR IS CONTINUOUS UNLESS OTHERWISE NOTED. PROVIDE BENT CORNER REBAR TO MATCH AND LAP WITH HORIZONTAL REBARS AT CORNERS AND INTERSECTIONS OF WALLS. DOWEL ALL VERTICAL WALL REBAR TO FOUNDATIONS. SECURELY TIE ALL REBAR, INCLUDING DOWELS, IN LOCATION BEFORE PLACING CONCRETE OR GROUT.

STRUCTURAL CONSTRUCTION OBSERVATION:


IT IS THE CONTRACTOR'S RESPONSIBILITY TO INSPECT ALL STRUCTURAL WORK FOR CONFORMANCE WITH THE CONTRACT DOCUMENTS. ANY STRUCTURAL CONSTRUCTION OBSERVATION PROVIDED BY OTHERS DOES NOT RELIEVE HIM OF THIS RESPONSIBILITY. ANY STRUCTURAL DEVIATIONS FROM THE CONTRACT DOCUMENTS THAT ARE FOUND AT A LATER DATE AND ARE DECLARED TO BE SIGNIFICANT BY THE STRUCTURAL ENGINEER SHALL BE CORRECTED BY THE CONTRACTOR WITH ALL DISPATCH.
 THE STRUCTURAL CONSTRUCTION OBSERVER IS NOT AUTHORIZED TO DIRECT OR APPROVE ANY CHANGES FROM THE CONTRACT DOCUMENTS. IF THE CONTRACTOR WISHES TO QUESTION THE STRUCTURAL CONSTRUCTION OBSERVER'S INTERPRETATION OF THE CONTRACT DOCUMENTS, HE MAY DO SO DIRECTLY WITH THE ARCHITECT OR THE STRUCTURAL ENGINEER.
 THE STRUCTURAL CONSTRUCTION OBSERVER IS NOT AUTHORIZED TO STOP OR DELAY WORK IF THE CONTRACTOR ELECTS TO CONTINUE WITH A CERTAIN WORK AFTER BEING NOTIFIED BY THE STRUCTURAL CONSTRUCTION OBSERVER THAT SUCH WORK IS UNACCEPTABLE, HE DOES SO AT HIS OWN RESPONSIBILITY AND RISKS CORRECTING THE WORK AT A LESS OPPORTUNE TIME.
 THE CONTRACTOR IS RESPONSIBLE FOR PROVIDING ADEQUATE FACILITIES FOR THE STRUCTURAL CONSTRUCTION OBSERVER, TO ALLOW HIM TO PERFORM HIS WORK SAFELY AND EFFICIENTLY.

SUPPLEMENTARY NOTES:

PROVIDE ALL TEMPORARY BRACING, SHORING, GUYING OR OTHER MEANS TO AVOID EXCESSIVE STRESSES AND TO HOLD STRUCTURAL ELEMENTS IN PLACE DURING CONSTRUCTION. ESTABLISH AND VERIFY ALL OPENINGS AND INSERTS FOR MECHANICAL, ELECTRICAL AND PLUMBING WITH APPROPRIATE TRADES, DRAWINGS AND SUBCONTRACTORS PRIOR TO CONSTRUCTION.
 THE STRUCTURAL ENGINEER SHALL NOT HAVE CONTROL OR CHARGE OF, AND SHALL NOT BE RESPONSIBLE FOR, CONSTRUCTION MEANS, METHODS, TECHNIQUES, SEQUENCES OR PROCEDURES, FOR SAFETY PRECAUTIONS AND PROGRAMS IN CONNECTION WITH THE WORK, FOR THE ACTS OR OMISSIONS OF THE CONTRACTOR, SUBCONTRACTORS OR ANY OTHER PERSONS PERFORMING ANY OF THE WORK IN ACCORDANCE WITH THE CONTRACT DOCUMENTS.
 FOR CONNECTIONS, SEE DETAILS.
 THE FOLLOWING IS A LIST OF THE APPROVED RETROFIT EPOXIES/ADHESIVES AND ANCHORS. THESE ARE 2012 IBC COMPLIANT WITH CURRENT ICC REPORTS. AT THE CONTRACTORS OPTION ALTERNATIVE ANCHOR AND EPOXY ICC REPORTS MAY BE SUBMITTED FOR REVIEW PROVIDED THE REPORT IS 2012 IBC COMPLIANT AND IN A CASE IN WHICH IT IS BEING USED IN CONCRETE THE REPORT COVERS CRACKED CONCRETE. THIS LIST IS FOR REFERENCE ONLY AND IS NOT INTENDED TO BE USED PRIOR TO THE EOR APPROVAL. EACH CONDITION WILL NEED TO BE REVIEWED AND DIRECTION GIVEN BASED ON CONCRETE STRENGTH, EDGE DISTANCE, ETC.
 EXPANSION BOLTS FOR USE IN MASONRY SHALL BE HILTI KWIK BOLT 3 ANCHOR PER CURRENT ICC ESR-1385. MASONRY CELLS SHALL BE SOLID GROUTED WITHIN 12" OF ANCHOR.
 EXPANSION BOLTS FOR USE IN CONCRETE SHALL BE HILTI KWIK BOLT-TZ EXPANSION ANCHOR PER CURRENT ICC ESR-1917 OR HILTI HSL-3 HEAVY DUTY SLEEVE ANCHOR PER CURRENT ICC ESR-1545.
 ADHESIVE ANCHORS FOR USE IN MASONRY SHALL BE HILTI HIT HY-150 MAX ADHESIVE PER CURRENT ICC ESR-1967. MASONRY CELLS SHALL BE SOLID GROUTED WITHIN 12" OF ANCHOR.
 ADHESIVE ANCHORS FOR USE IN CONCRETE SHALL BE HILTI HIT-RE 500-SD EPOXY PER CURRENT ICC ESR-2322.
 COST OF ADDITIONAL FIELD AND OFFICE WORK NECESSITATED BY REQUEST BY THE CONTRACTOR FOR AN OPTION OR DUE TO ERRORS OR OMISSIONS IN CONSTRUCTION SHALL BE BORNE BY THE CONTRACTOR. OPTIONS ARE FOR CONTRACTORS CONVENIENCE. HE SHALL BE RESPONSIBLE FOR ALL CHANGES NECESSARY IF HE CHOOSES AN OPTION AND HE SHALL COORDINATE ALL DETAILS.
 ANY ENGINEERING DESIGN PROVIDED BY OTHERS AND SUBMITTED FOR REVIEW SHALL BEAR THE SEAL OF AN ENGINEER REGISTERED IN THE STATE OF ARIZONA.
 UNLESS OTHERWISE NOTED, DETAILS ON STRUCTURAL DRAWINGS ARE TYPICAL AS INDICATED BY CUTS, REFERENCES OR TITLES.
 VERIFY ALL DIMENSIONS WITH DRAWINGS FROM OTHER DISCIPLINES.
 CONTRACTOR SHALL VERIFY IN FIELD ALL EXISTING CONDITIONS SHOWN ON DRAWINGS.
 ALL CONSTRUCTION MEETING OR CROSSING EXPANSION OR SHRINKAGE CONTROL JOINTS IN FLOORS OR ROOFS MUST HAVE PROVISIONS TO ACCOMMODATE MOVEMENT OR MUST BE DELAYED UNTIL THE JOINT IS CLOSED.
 DRYPACK SHALL BE ONE PART CEMENT AND 2 1/2 PARTS SAND WITH JUST ENOUGH WATER TO HYDRATE CEMENT AND FORM A BALL SHOWING MOISTURE ON THE SURFACE WHEN SQUEEZED. IT SHALL BE RAMMED IN TIGHT TO MAXIMUM DENSITY ATTAINABLE. MINIMUM 28 DAY STRENGTH TO BE 5000 PSI.
 IN LIEU OF DRYPACK, GROUT SHALL BE NON-SHRINK, NON-METALLIC; U.S. GROUT CORP. FIVE STAR GROUT; ASTM C-827, C-191, AND C-109 OR PRIOR APPROVED EQUAL, MIXED AND INSTALLED PER MANUFACTURER'S RECOMMENDATION, MINIMUM COMPRESSIVE STRENGTH 5000 PSI IN 7 DAYS.

SPECIAL INSPECTIONS:

PER SECTION 1704 OF THE INTERNATIONAL BUILDING CODE, SPECIAL INSPECTION IS REQUIRED FOR THE FOLLOWING ITEMS:
 1. CONCRETE AND REINFORCEMENT.
 2. ANCHOR BOLTS.
 3. EXPANSION ANCHORS AND ADHESIVE ANCHORS.
 4. EARTHWORK.
 5. MASONRY.

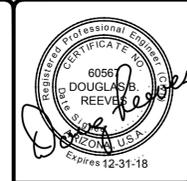

NO.	REVISION DESCRIPTION	DATE	BY
5			
4			
3			
2			
1			

NAVAJO TRIBAL UTILITY AUTHORITY
 GANADO, ARIZONA


GANADO WASTEWATER TREATMENT PLANT
 LAGOON UPGRADE
 STRUCTURAL
 GENERAL STRUCTURAL NOTES

SOLUTIONS FOR TODAY...
 VISION FOR TOMORROW
 2201 San Pedro Dr. NE
 Building 4, Suite 200
 Albuquerque, NM 87110
 Phone: (505) 884-0700
 Fax: (505) 884-2376
TEXAS




RECORD DRAWING
 THIS RECORD DRAWING HAS BEEN PREPARED, IN PART, BASED UPON INFORMATION FURNISHED BY OTHERS. WHILE THE INFORMATION IS BELIEVED TO BE RELIABLE, THE ENGINEER CANNOT ASSURE IT'S ACCURACY, & IS NOT RESPONSIBLE FOR THE ACCURACY OF THIS RECORD DRAWING OR ANY ERRORS OR OMISSIONS WHICH MAY HAVE BEEN INCORPORATED INTO IT AS A RESULT. THOSE RELYING ON THIS RECORD DOCUMENT ARE ADVISED TO OBTAIN INDEPENDENT VERIFICATION OF IT'S ACCURACY BEFORE APPLYING IT FOR ANY PURPOSE.

JOB NO:
 115111
 DATE:
APR 2016
 SHEET NO:
 9

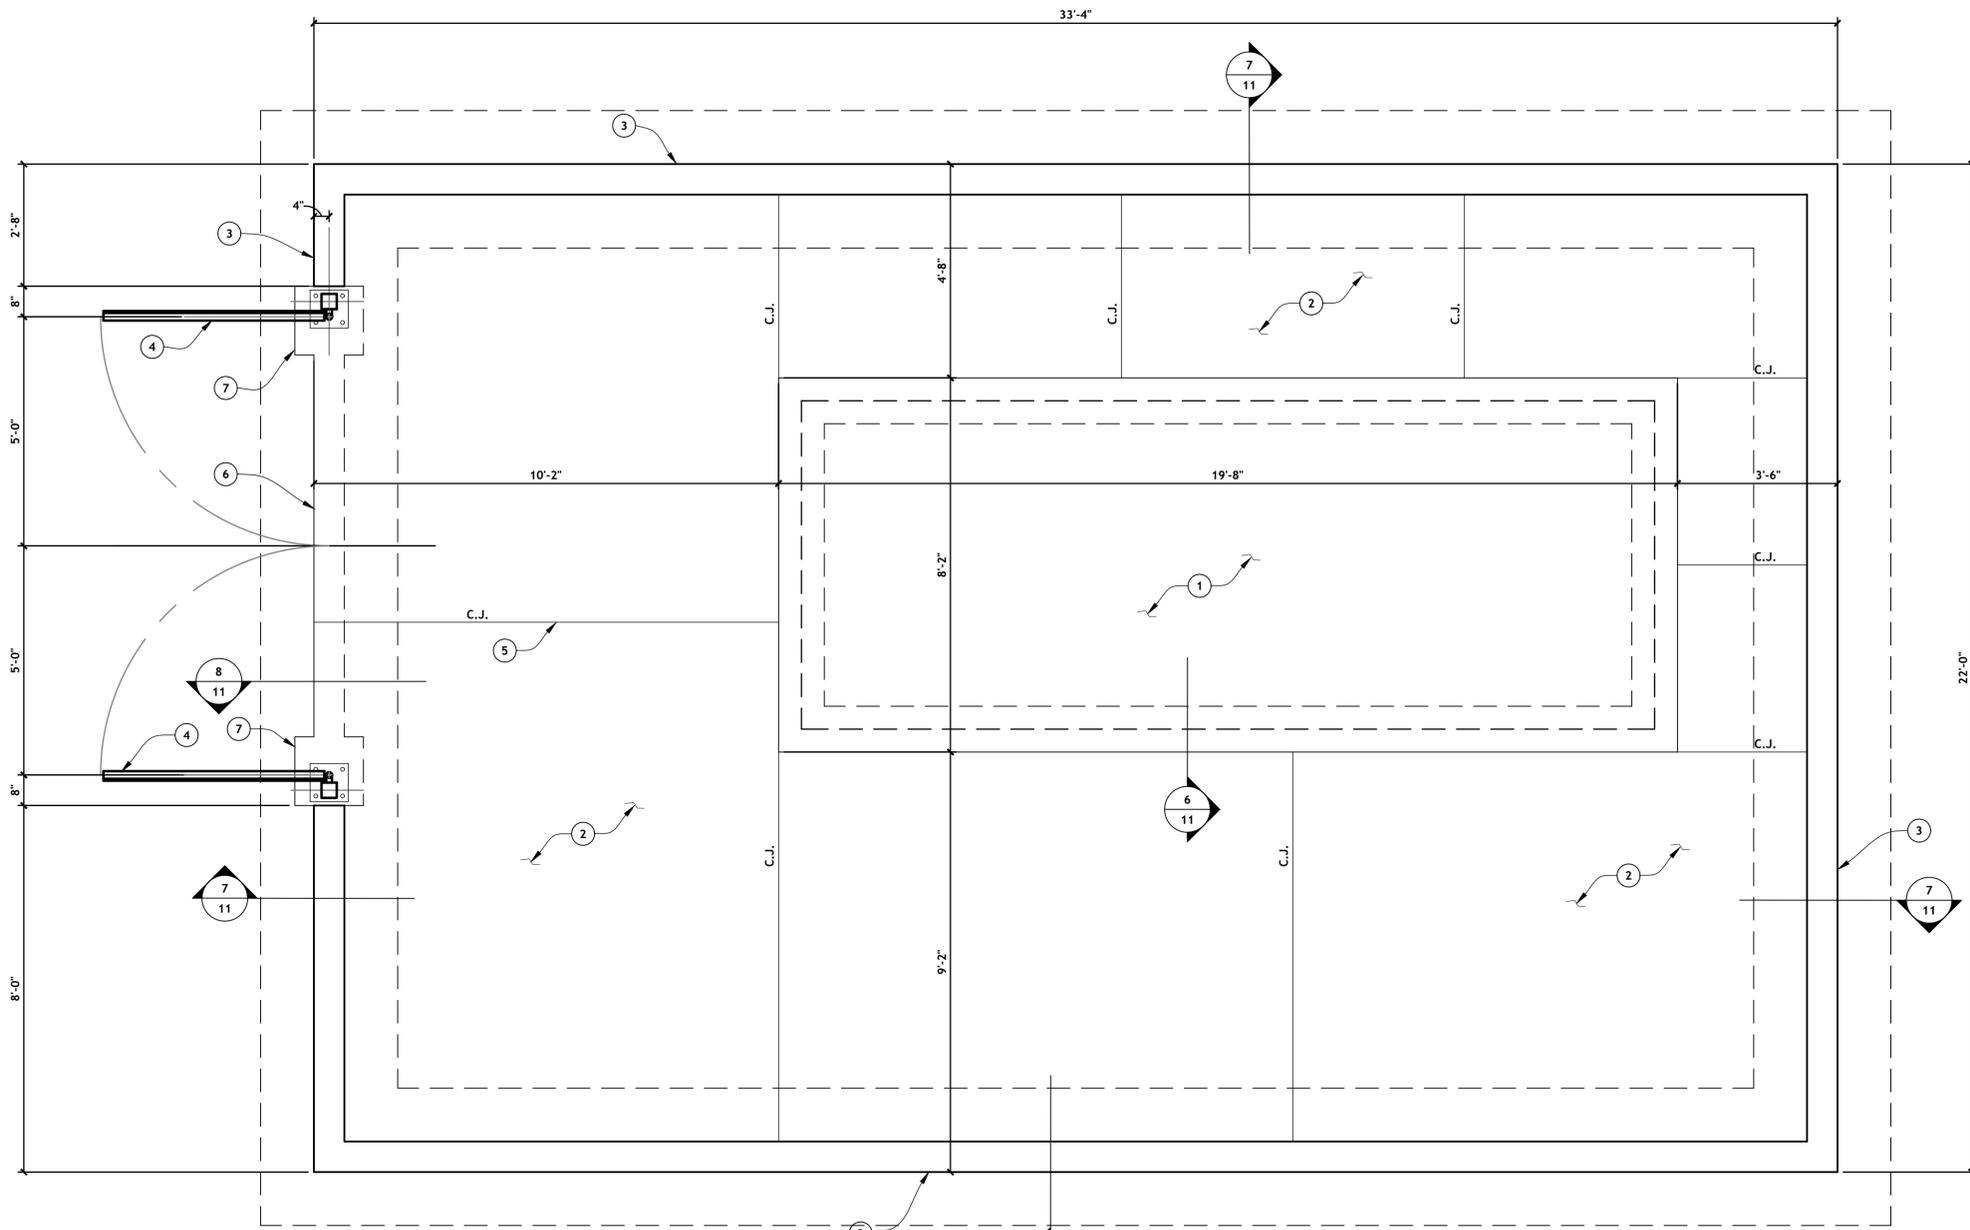


1. CONCRETE GENERATOR PAD, SEE DETAIL 6/11.
2. 4" CONCRETE SLAB WITH #4 BARS AT 18" O.C., E.W.
3. 8" CMU WALL, 8'-0" HIGH, SEE DETAIL 7/11.
4. GATE, SEE DETAIL 9/11 FOR ADDITIONAL INFORMATION.
5. C.J. INDICATES LOCATION OF CONSTRUCTION JOINT IN SLAB, SEE DETAIL 3/11.
6. 8" WIDE TURN DOWN SLAB EDGE ALONG GATE OPENING, SEE 8/11.
7. WIDEN TURN DOWN SLAB EDGE AT GATE POSTS TO 18" SQUARE, SEE DETAIL 9/11.

NOTES:
1. SEE DETAILS 4/11 AND 5/11 FOR LOCATIONS WHERE PIPES OR CONDUITS PASS UNDER THE FOOTINGS.

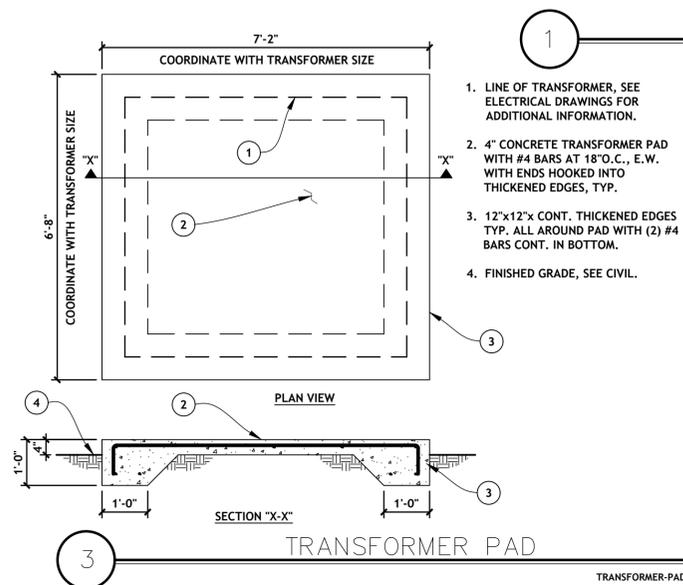


1. LINE OF TRANSFORMER, SEE ELECTRICAL DRAWINGS FOR ADDITIONAL INFORMATION.
2. 4" CONCRETE TRANSFORMER PAD WITH #4 BARS AT 18" O.C., E.W. WITH ENDS HOOKED INTO THICKENED EDGES, TYP.
3. 12"x12"x CONT. THICKENED EDGES TYP. ALL AROUND PAD WITH (2) #4 BARS CONT. IN BOTTOM.
4. FINISHED GRADE, SEE CIVIL.

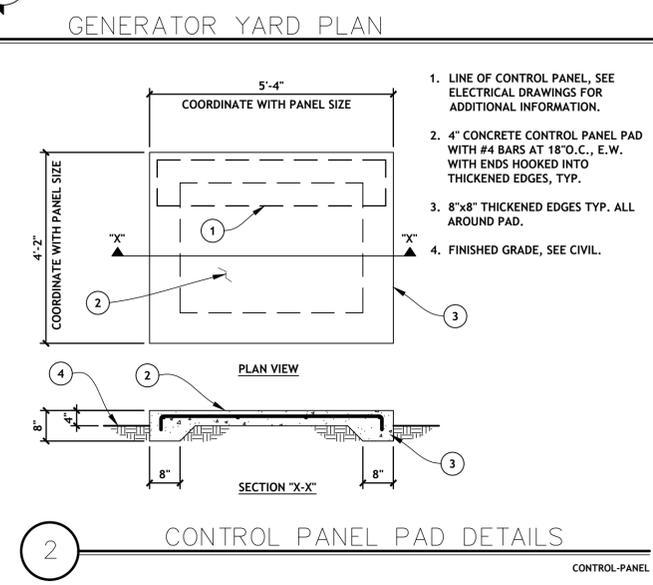

1. LINE OF CONTROL PANEL, SEE ELECTRICAL DRAWINGS FOR ADDITIONAL INFORMATION.
2. 4" CONCRETE CONTROL PANEL PAD WITH #4 BARS AT 18" O.C., E.W. WITH ENDS HOOKED INTO THICKENED EDGES, TYP.
3. 8"x8" THICKENED EDGES TYP. ALL AROUND PAD.
4. FINISHED GRADE, SEE CIVIL.

RECORD DRAWING

THIS RECORD DRAWING HAS BEEN PREPARED, IN PART, BASED UPON INFORMATION FURNISHED BY OTHERS. WHILE THE INFORMATION IS BELIEVED TO BE RELIABLE, THE ENGINEER CANNOT ASSURE ITS ACCURACY, & IS NOT RESPONSIBLE FOR THE ACCURACY OF THIS RECORD DRAWING OR ANY ERRORS OR OMISSIONS WHICH MAY HAVE BEEN INCORPORATED INTO IT AS A RESULT. THOSE RELYING ON THIS RECORD DOCUMENT ARE ADVISED TO OBTAIN INDEPENDENT VERIFICATION OF ITS ACCURACY BEFORE APPLYING IT FOR ANY PURPOSE.

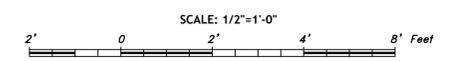

NO.	REVISION DESCRIPTION	DATE	BY
5			
4			
3			
2			
1			

NAVAJO TRIBAL UTILITY AUTHORITY
GANADO, ARIZONA

GANADO WASTEWATER TREATMENT PLANT
LAGOON UPGRADE


STRUCTURAL
PLAN

SOLUTIONS FOR TODAY...
VISION FOR TOMORROW

2201 San Pedro Dr. NE
Building 4, Suite 200
Albuquerque, NM 87110
Phone: (505) 884-0700
Fax: (505) 884-2376
TEXAS




JOB NO.: 115111
DATE: APR 2016
SHEET NO.: 10

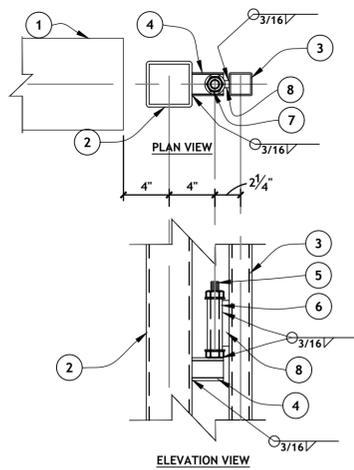


- 8" CMU WALL, SEE PLAN.
- HSS4x4x1/4 GATE POST, SEE PLANS.
- HSS2x2x1/4 GATE FRAME, SEE 9/11.
- HSS2x2x1/4 STUB WELDED TO GATE POST, SEE 9/11.
- 3/4"Ø x 6" LONG BOLT WELDED TO HSS STUB.
- 1"Ø EXTRA-STRONG PIPE SLEEVE, 4 1/2" LONG, PLACED OVER 3/4"Ø BOLT WITH WASHER TOP AND BOTTOM.
- NUT FOR 3/4"Ø BOLT FINGER TIGHT.
- WELD A 5/8" SQUARE SPACER BAR 4" LONG TO PIPE SLEEVE AND HSS2x2 GATE FRAME.

10 GATE HINGE DETAIL

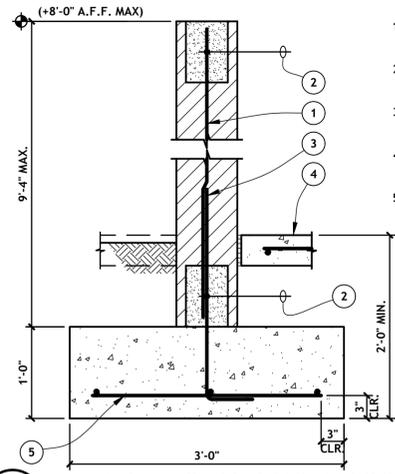


- 8" MASONRY WALL WITH #5 VERTS. AT 24" O.C. CENTERED IN WALL.
- (1) #5 IN 8" DEEP CONT. BOND BEAM.
- DOWELS TO MATCH AND LAP VERT. WALL REINFORCING (30" LAP).
- FINISH GRADE OR CONCRETE SLAB AS OCCURS.
- (3) #5 BARS CONT. AND #5 BARS TRANSV. AT 24" O.C.

7 FREE STANDING MASONRY WALL

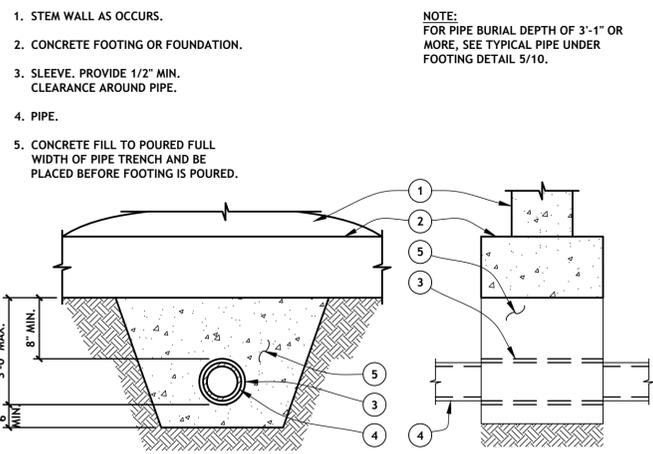

4 PIPE PASSING BELOW CONT. FOOTING

NOTE:
FOR PIPE BURIAL DEPTH OF 3'-1" OR MORE, SEE TYPICAL PIPE UNDER FOOTING DETAIL 5/10.

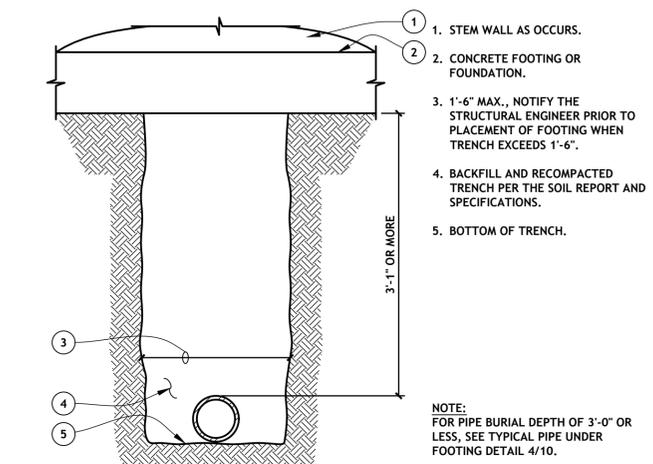

5 PIPE PASSING BELOW CONT. FOOTING

- STEM WALL AS OCCURS.
- CONCRETE FOOTING OR FOUNDATION.
- 1'-6" MAX., NOTIFY THE STRUCTURAL ENGINEER PRIOR TO PLACEMENT OF FOOTING WHEN TRENCH EXCEEDS 1'-6".
- BACKFILL AND RECOMPACTED TRENCH PER THE SOIL REPORT AND SPECIFICATIONS.
- BOTTOM OF TRENCH.


NOTE:
FOR PIPE BURIAL DEPTH OF 3'-0" OR LESS, SEE TYPICAL PIPE UNDER FOOTING DETAIL 4/10.

LAP SPLICE LENGTHS (IN.)

BAR SIZE	LENGTHS (IN.)				DOUBLE MAT	
	SINGLE MAT		8" CMU		12" CMU	
	6" CMU	2000 PSI	1500 PSI	2000 PSI	1500 PSI	2000 PSI
#3	16	14	18	18	18	18
#4	24	18	24	24	24	24
#5	32	28	30	30	30	30
#6	54	54	43	37	39	36
#7	N/A	N/A	59	51	49	43
#8	N/A	N/A	72	72	72	72
#9	N/A	N/A	81	81	81	81

- LAP-SPLICE LENGTHS ARE CALCULATED PER IBC 2009 SECTION 2108.2 AND ACT 530-08 SECTION 3.3.3.3.
- TABULATED VALUES ARE BASED ON GRADE 60 UNCOATED REINFORCING BARS.
- FOR GRADE 40 REINFORCING BARS MULTIPLY THE TABULATED VALUES BY 0.67 (12" MIN. LAP).
- MECHANICAL SPLICE REQUIRED FOR BARS GREATER THAN #9.

1 LAP-SPLICE SCHEDULE FOR MASONRY REI

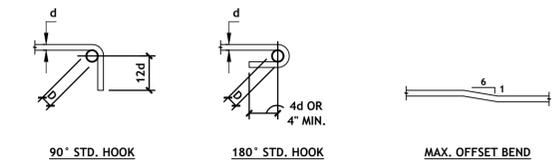


D=6d FOR #3 TO #8
D=8d FOR #9 TO #11
D=12d FOR #14 TO #18

MIN. D=1 1/2" FOR #3
MIN. D=2" FOR #4
MIN. D=2 1/2" FOR #5
MIN. D=4 1/2" FOR #6
MIN. D=5 1/4" FOR #7
MIN. D=6" FOR #8


NOTE:
A. ALL BENDS SHALL BE MADE COLD.
B. #14 AND #18 BARS SHALL BE BEND TESTED AND LAB APPROVED PRIOR TO BENDING.

2 TYPICAL BAR BENDS

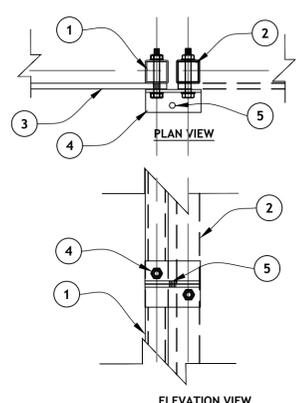


- HSS2x2x1/4 GATE FRAME, SEE PLAN.
- OPPOSITE HSS2x2x1/4 GATE FRAME.
- METAL SIDING ON GATE TO MATCH PRIVACY FENCE.
- L2x2x1/4x0'-5" WITH (1) 1/2"Ø BOLT THRU HSS AND SIDING, FINGER TIGHTEN NUT. PROVIDE WASHERS FOR SPACERS THRU SIDING AS REQUIRED.
- DRILL HOLE IN L2x2 HORIZ. LEG THRU BOTH ANGELS (1) EACH GATE FRAME, FOR LOCK BY OWNER.

11 GATE LATCH DETAIL

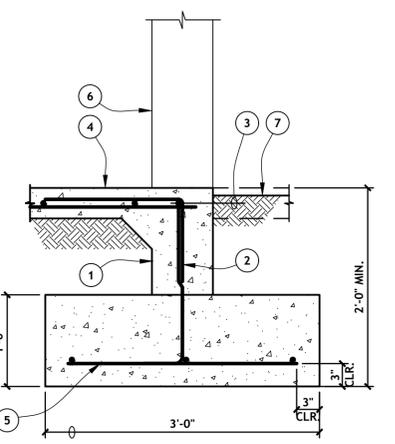


- 8" WIDE TURNED DOWN SLAB EDGE.
- DOWELS TO MATCH VERTICAL WALL REINFORCING (LAP PER G.S.N.).
- (1) #5 CONT. ALONG SLAB EDGE.
- CONCRETE SLAB ON GRADE, SEE PLAN FOR SIZE AND REINFORCING.
- SEE DETAIL 7/10 FOR FOOTING SIZE AND REINFORCING.
- MASONRY WALL BEYOND.
- CONCRETE SLAB OR FINISH GRADE AS OCCURS.

8 FOOTING AT MASONRY WALL OPENING

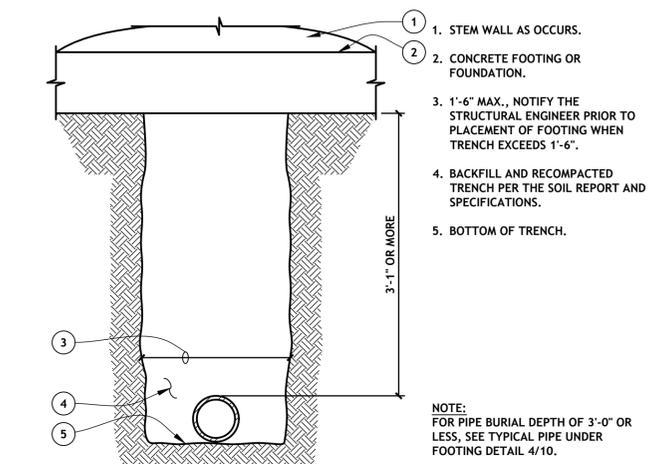

6 GENERATOR PAD DETAIL

- CONCRETE GENERATOR PAD WITH #5 BARS AT 18" O.C., E.W. AND WITH CONT. TURNED DOWN EDGE, SEE PLAN FOR DIMENSIONS.
- #3 TIES AT 24" O.C.
- (3) #5 CONT. TOP AND BOTTOM.
- TYP. CONC. SLAB AROUND PAD, SEE PLAN FOR ADDITIONAL INFO.
- FACE OF GENERATOR, SEE ELECTRICAL DRAWINGS FOR ADDITIONAL INFORMATION.
- OPTIONAL CONSTRUCTION JOINT.
- 1/2" EXPANSION JOINT BETWEEN SLAB AND PAD, TYP.
- 3/4" CHAMFERED EDGE, TYP.

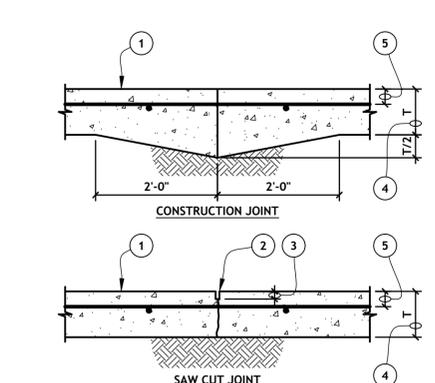


- CONCRETE SLAB OVER STRUCTURE FILL PER THE G.S.N. AND SOILS REPORT.
- SAWCUT SLAB AFTER CONCRETE IS HARD ENOUGH TO AVOID SPALLING AND DAMAGE BUT NOT LATER THAN 12 HOURS AFTER CONCRETE PLACEMENT.
- DEPTH OF CUT=T/4.
- SEE PLANS FOR (T) SLAB THICKNESS.
- 2" MINIMUM COVER.


NOTE:
JOINTS TO BE NO MORE THAN 20'-0" O.C. (10'-0" O.C. WHEN LEFT EXPOSED). ASPECT RATIO OF PANEL LENGTH TO PANEL WIDTH NOT TO EXCEED 1.5.

3 TYPICAL CONTRACTION JOINT IN SLAB

RECORD DRAWING
THIS RECORD DRAWING HAS BEEN PREPARED, IN PART, BASED UPON INFORMATION FURNISHED BY OTHERS. WHILE THE INFORMATION IS BELIEVED TO BE RELIABLE, THE ENGINEER CANNOT ASSURE IT'S ACCURACY, & IS NOT RESPONSIBLE FOR THE ACCURACY OF THIS RECORD DRAWING OR ANY ERRORS OR OMISSIONS WHICH MAY HAVE BEEN INCORPORATED INTO IT AS A RESULT. THOSE RELYING ON THIS RECORD DOCUMENT ARE ADVISED TO OBTAIN INDEPENDENT VERIFICATION OF IT'S ACCURACY BEFORE APPLYING IT FOR ANY PURPOSE.

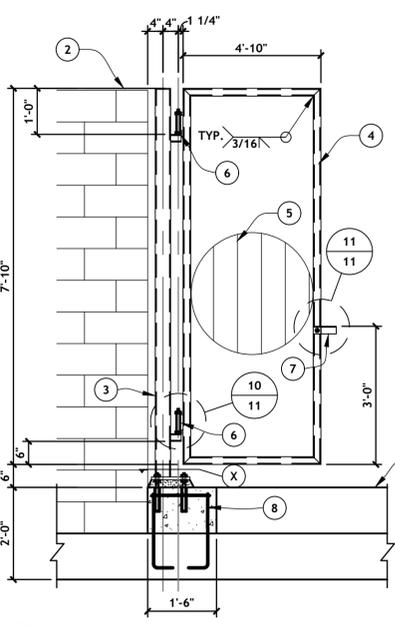

- TOP OF CONCRETE SLAB.
- 8" CMU WALL, SEE DETAIL 7/11.
- HSS4x4x1/4 GATE POST WITH BASE PLATE 10"x3/4"x0'-10" ANCHORED TO CONC. WITH (4) 3/4"Ø ADHESIVE ANCHORS EMBED 6" MIN.
- HSS2x2x1/4 GATE FRAME, MITER CORNERS, WELD, AND GRIND WELDS SMOOTH, TYP.
- PROVIDE BERRIDGE MANUFACTURING METAL "VEE-PANEL" SIDING ON GATE.
- GATE HINGE, SEE DETAIL 10/11.
- GATE LATCH, SEE DETAIL 11/11.
- WIDEN TURN DOWN SLAB EDGE TO 18" SQ. AT GATE POST AND PROVIDE (4) #5 DWL'S TO FOOTING AND (1) #3 TIE AT TOP.

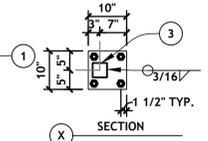

NOTE:
PRIME AND PAINT ALL STEEL GATE PARTS.

9 GATE DETAILS



NO.	REVISION DESCRIPTION	DATE	BY
5			
4			
3			
2			
1			

NAVAJO TRIBAL UTILITY AUTHORITY
GANADO, ARIZONA

GANADO WASTEWATER TREATMENT PLANT
LAGOON UPGRADE

STRUCTURAL
STRUCTURAL DETAILS

SOLUTIONS FOR TODAY...
VISION FOR TOMORROW

2201 San Pedro Dr. NE
Building 4, Suite 200
Albuquerque, NM 87110
Phone: (505) 884-0700
Fax: (505) 884-2376
TEXAS




JOB NO.
115111

DATE:
APR 2016

SHEET NO.
11

VICINITY MAP

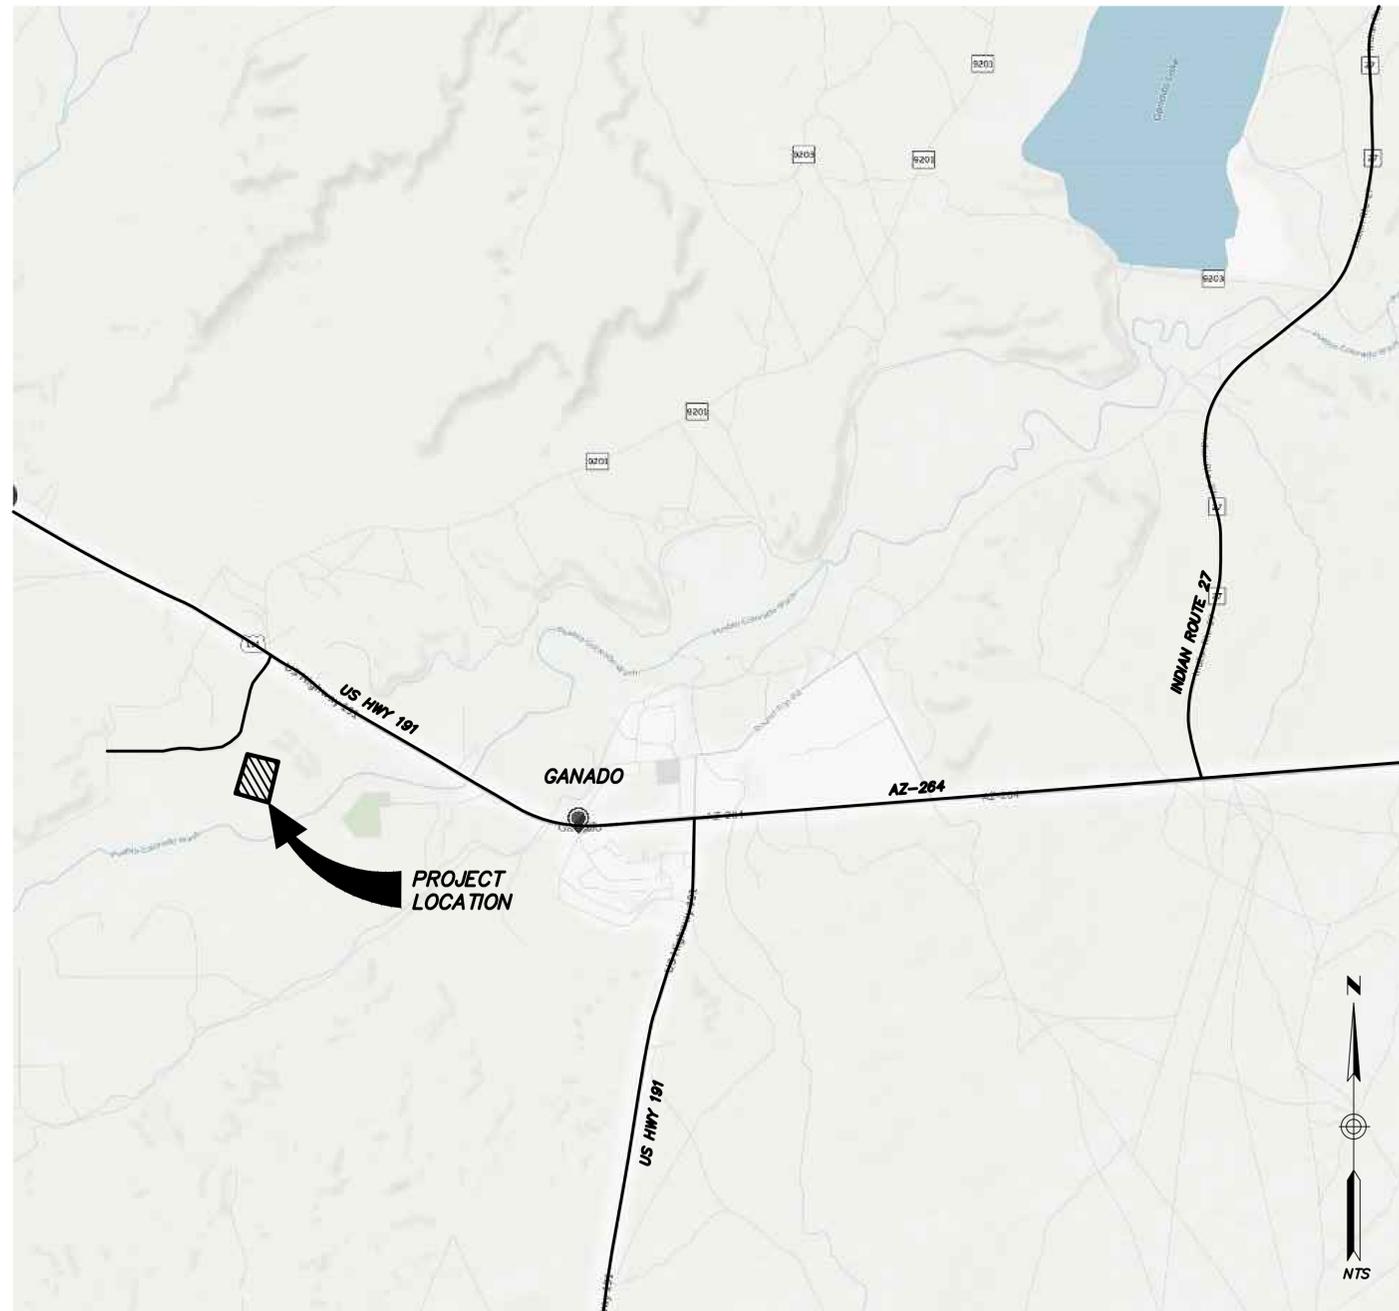

PLAN LEGEND

- EXPOSED CONDUIT
- - - UNDERGROUND CONDUIT DUCTBANK
- - - - UNDERGROUND UTILITY CONDUIT
- · - · - GROUNDING ELECTRODE CONDUCTOR
- OHE — EXISTING OVERHEAD ELECTRIC
- E — EXISTING UNDERGROUND ELECTRIC
- W — EXISTING WATER
- X — CHAIN-LINK FENCE
- S — EXISTING SEWER
- G — EXISTING GAS LINE
- ⊕ GROUND ROD AND WELL
- ⊞ UNDERGROUND JUNCTION BOX
- ⊕ 120V, 20A DUPLEX RECEPTACLE
- ⊕ 120V, 20A SPST SWITCH
- ▭ PANELBOARD
- ⊕ POWER POLE

SINGLE LINE DIAGRAM LEGEND

- ⊞ FUSE
- ⊞ CURRENT TRANSFORMER
- ⊞ TRANSFORMER
- ⊞ MOTOR STARTER
- ⊞ 20 MOTOR (20 DENOTES MOTOR HORSEPOWER)
- ⊞ OR ⊞ JUNCTION BOX
- ⊕ 120V, 20A DUPLEX RECEPTACLE
- ⊞ LIGHT
- ⊞ M METER
- ⊞ LIGHT SWITCH
- ⊞ DISCONNECT SWITCH
- MLO MAIN LUG ONLY
- ⊞ CIRCUIT BREAKER
- ⊞ EARTH GROUND CONNECTION
- ⊞ OVERLOAD (ELECTRONIC TYPE)
- ⊞ NEUTRAL BUS
- ⊞ GROUND BUS
- ⊞ GROUND ROD AND WELL
- ⊞ AUTOMATIC TRANSFER SWITCH

GENERAL ELECTRICAL REQUIREMENTS

- A. THE COMPLETED INSTALLATION SHALL CONFORM TO ALL APPLICABLE FEDERAL, STATE AND LOCAL CODE ORDINANCES AND REGULATIONS. CONTRACTOR SHALL OBTAIN NECESSARY PERMITS AND INSPECTIONS REQUIRED BY THE GOVERNING AUTHORITIES. ALL WORK SHALL BE DONE IN A NEAT, WORKMANLIKE, FINISHED AND SAFE MANNER, ACCORDING TO THE LATEST PUBLISHED N.E.C.A. STANDARDS OF INSTALLATION, UNDER COMPETENT SUPERVISION. INSTALL GROUNDING AS REQUIRED BY THE NATIONAL ELECTRIC CODE (2011).
- B. VISIT THE SITE PRIOR TO BIDDING TO BECOME FAMILIAR WITH EXISTING CONDITIONS AND ALL OTHER FACTORS WHICH MAY AFFECT THE EXECUTION OF THIS WORK. INCLUDE ALL RELATED COSTS IN THE INITIAL BID PROPOSAL.
- C. ALL MATERIALS SHALL BE NEW AND OF THE BEST QUALITY, MANUFACTURED IN ACCORDANCE WITH NEMA, ANSI, U.L. OR OTHER APPLICABLE STANDARDS. THE USE OF MANUFACTURER'S NAMES, MODELS AND NUMBERS IS INTENDED TO ESTABLISH STYLE, QUALITY, APPEARANCE, USEFULNESS AND BID PRICE. PROPOSED SUBSTITUTIONS SHALL BE SUBMITTED IN WRITING AND REVIEWED BY THE ENGINEER BEFORE ORDERING.
- D. PROTECT ALL ELECTRICAL MATERIAL AND EQUIPMENT INSTALLED UNDER THIS CONTRACT AGAINST DAMAGE BY OTHER TRADES, WEATHER CONDITIONS OR ANY OTHER CAUSES. EQUIPMENT FOUND DAMAGED OR IN OTHER THAN NEW CONDITION WILL BE REJECTED AS DEFECTIVE.
- E. LEAVE THE SITE CLEAN, REMOVE ALL DEBRIS, EMPTY CARTONS, TOOLS, CONDUIT, WIRE SCRAPS AND ALL MISCELLANEOUS SPARE EQUIPMENT AND MATERIALS USED IN THE WORK DURING CONSTRUCTION. ALL COMPONENTS SHALL BE FREE OF DUST, GRIT AND FOREIGN MATERIALS, LEFT AS NEW BEFORE FINAL ACCEPTANCE OF WORK.
- F. REFER TO OTHER PLANS FOR EXACT LOCATION OF EQUIPMENT AND ARCHITECTURAL FEATURES.
- G. REFER TO SPECIFICATIONS FOR ADDITIONAL PROJECT REQUIREMENTS.
- H. TYPICAL DETAILS APPLY IN ALL CASES WHETHER SPECIFICALLY REFERRED TO OR NOT.
- I. THESE CONTRACT DOCUMENTS ARE SUBJECT TO THE INTERPRETATION BY THE ENGINEER. ALL QUESTIONS REGARDING THESE CONTRACT DOCUMENTS SHALL BE BROUGHT TO THE ENGINEER. ANYONE WHO TAKES UPON THEMSELVES THE INTERPRETATION OF THESE CONTRACT DOCUMENTS OR MAKES REVISIONS TO THE SAME WITHOUT CONFERRING WITH THE DESIGN ENGINEER SHALL BE RESPONSIBLE FOR THE CONSEQUENCES THEREOF.
- J. ALL UNDERGROUND CONDUIT TO BE SCHEDULE 40 PVC. MINIMUM DEPTH 24", MINIMUM SIZE 3/4". ALL CONDUIT EXPOSED AND/OR LOCATED WITHIN THE VAULT TO BE TYPE GRS, MINIMUM SIZE 3/4". PROVIDE EACH PVC CONDUIT WITH A BELL END WHERE ENTERING FREE STANDING EQUIPMENT. INSTALL LFMC AT EQUIPMENT WHICH IS SUBJECT TO VIBRATION OR REQUIRE MOVEMENT FOR MAINTENANCE PURPOSES. PROVIDE NECESSARY REDUCER WHERE EQUIPMENT FURNISHED CANNOT ACCEPT 3/4" SIZE FLEXIBLE CONDUIT. LIMIT FLEXIBLE CONDUIT LENGTH TO 3' MAXIMUM.
- K. ALL CIRCUIT CONDUCTORS TO BE "XHHW-2" STRANDED COPPER. MINIMUM CONDUCTOR SIZE FOR POWER TO BE #12 AWG WITH #12 GND. MINIMUM CONDUCTOR SIZE FOR CONTROL TO BE #14 AWG WITH #14 GND. SERVICE ENTRANCE CONDUCTORS SHALL BE MARKED "SUNLIGHT RESISTANT" AS REQUIRED BY UTILITY COMPANY.
- L. LOCATION OF ELECTRICAL EQUIPMENT SHALL BE SCALED FROM THE SITE PLAN. UPON COMPLETION OF WORK, FURNISH A SET OF RED-LINED "AS-BUILT" DRAWINGS, THAT ACCURATELY REFLECTS FINAL LOCATION OF UNDERGROUND CONDUIT AND OTHER ELECTRICAL EQUIPMENT.
- M. THIS WASTEWATER TREATMENT FACILITY IS OPERATING AND MUST REMAIN IN OPERATION AT ALL TIMES WITH MINIMAL DOWNTIME. THE CONTRACTOR IS REQUIRED TO WORK CLOSELY WITH NTUA FOR SCHEDULING ANY POWER OUTAGES TO MINIMIZE DOWNTIME AND DISRUPTION TO FACILITY OPERATION.

GENERAL DEMOLITION NOTES

- A. DEMOLITION OF CONDUITS INCLUDES REMOVAL AND DISPOSAL OF EXISTING EXPOSED CONDUITS TO A MINIMUM OF 6-INCHES BELOW GRADE.
- B. ALL REMOVED MATERIAL NOT BEING SALVAGED BY OWNER SHALL BECOME THE PROPERTY OF THE CONTRACTOR TO BE HAULED OFF SITE AND DISPOSED OF AT AN APPROVED LANDFILL, OR OTHER APPROVED LOCATION.
- C. THE CONTRACTOR SHALL PERFORM DEMOLITION WORK WHILE THE FACILITY IS IN OPERATION AS MUCH AS POSSIBLE. ALL WORK SHALL BE PERFORMED IN A MANNER TO MINIMIZE DOWNTIMES AND OPERATIONAL UPSETS.
- D. COORDINATE ALL DEMOLITION WORK AND SHUTDOWN REQUIREMENTS WITH THE OWNER PRIOR TO PERFORMING THE WORK.

ABBREVIATIONS

AFF ABOVE FINISHED FLOOR	MCC MOTOR CONTROL CENTER
AFG ABOVE FINISHED GRADE	MFR MANUFACTURER
C CONDUIT	MH MANHOLE
CKT CIRCUIT	MBJ MAIN BOUND JUMPER
CMU CONCRETE MASONRY UNIT	MLO MAIN LUG ONLY
Cu COPPER	NEC NATIONAL ELECTRIC CODE
DWG DRAWING	NOTC NORMALLY OPEN TIMED TO CLOSE
EXISTG EXISTING	NTS NOT TO SCALE
E.C. EMPTY CONDUIT	NTUA NAVAJO TRIBAL UTILITY AUTHORITY
ENCL ENCLOSURE	PACP PKG'D AERATION CONTROL PANEL
FM FLOWMETER	PKG'D PACKAGED
GEC GROUNDING ELECTRODE CONDUCTOR	REQ'TS REQUIREMENTS
GND GROUND	RMC RIGID METAL CONDUIT
HP HORSEPOWER	SCA SHORT CIRCUIT AMPS AVAILABLE
LF LINEAR FEET	SES SERVICE ENTRANCE SECTION
KVA THOUSAND VOLT AMPS	SPD SURGE PROTECTIVE DEVICE
KW KILO-WATT	TYP TYPICAL
MCB MAIN CIRCUIT BREAKER	W-I-U WHILE-IN-USE
	WP WEATHERPROOF
	XFMR TRANSFORMER

LUMINAIRE SCHEDULE

SYMBOL	VOLTS	LAMP(S)	FIXTURE	DESCRIPTION	MANUFACTURER
⊕	120V	29W LED 3000K		FULL CUTOFF WALL MOUNTED LUMINAIRE WITH A FULLY GASKETED TWO-PIECE DIE-CAST ALUMINUM HOUSING FINISHED WITH A BRONZE POLYESTER POWDER COAT. EPDM GASKETED SEALED IMPACT-RESISTANT GLASS LENS UL APPROVED FOR WET LOCATIONS.	HUBBELL (LNC2-12LU-3K-3-1) OR APPROVED EQUAL AB

RECORD DRAWING
THIS RECORD DOCUMENT HAS BEEN PREPARED BASED UPON INFORMATION PROVIDED BY THE CONTRACTOR (AS DENOTED BY "AB"). THIS INFORMATION MAY OR MAY NOT BE ACCURATE OR COMPLETE. FURTHERMORE, THE CONSULTANT HAS NOT VERIFIED ALL INFORMATION INDICATED ON THIS DOCUMENT. THE CONSULTANT SHALL NOT BE HELD RESPONSIBLE FOR ANY ERRORS OR OMISSIONS ON THIS DOCUMENT. THIS DOCUMENT IS FOR GENERAL INFORMATION PURPOSES ONLY. ANY OTHER USE OF THIS DOCUMENT IS AT YOUR SOLE RISK!

DARCOR
ELECTRICAL CONSULTING ENGINEERS
7600 N. 16TH ST. SUITE 212 PHOENIX, AZ 85020
PH: (602) 795-8899 WWW.DARCORINC.COM



NAVAJO TRIBAL UTILITY AUTHORITY GANADO, ARIZONA	
NO.	DATE
1	3/13/2017
2	
3	
4	
AS BUILT PER CONTRACTOR REDLINES	DAR
REVISION DESCRIPTION	BY
CHKD BY: DAR	DRWN BY: DRG

GANADO WASTEWATER TREATMENT PLANT
LAGOON UPGRADE
ELECTRICAL
LEGEND, NOTES & ABBREVIATIONS


SOLUTIONS FOR TODAY...
VISION FOR TOMORROW
2201 San Pedro Dr. NE
Building 4, Suite 200
Albuquerque, NM 87110
Phone: (505) 884-0700
Fax: (505) 884-2376
TEXAS



JOB NO: 115111
DATE: MAR 2016
SHEET NO: E500

Saved: March 14, 2017 File: 16019-RD-CANADO-E500.dwg Drafter: Brandon Rickerd

Saved: March 14, 2017 File: 16019-RD-CANADO-E501.dwg Drafter: Brandon Rickard

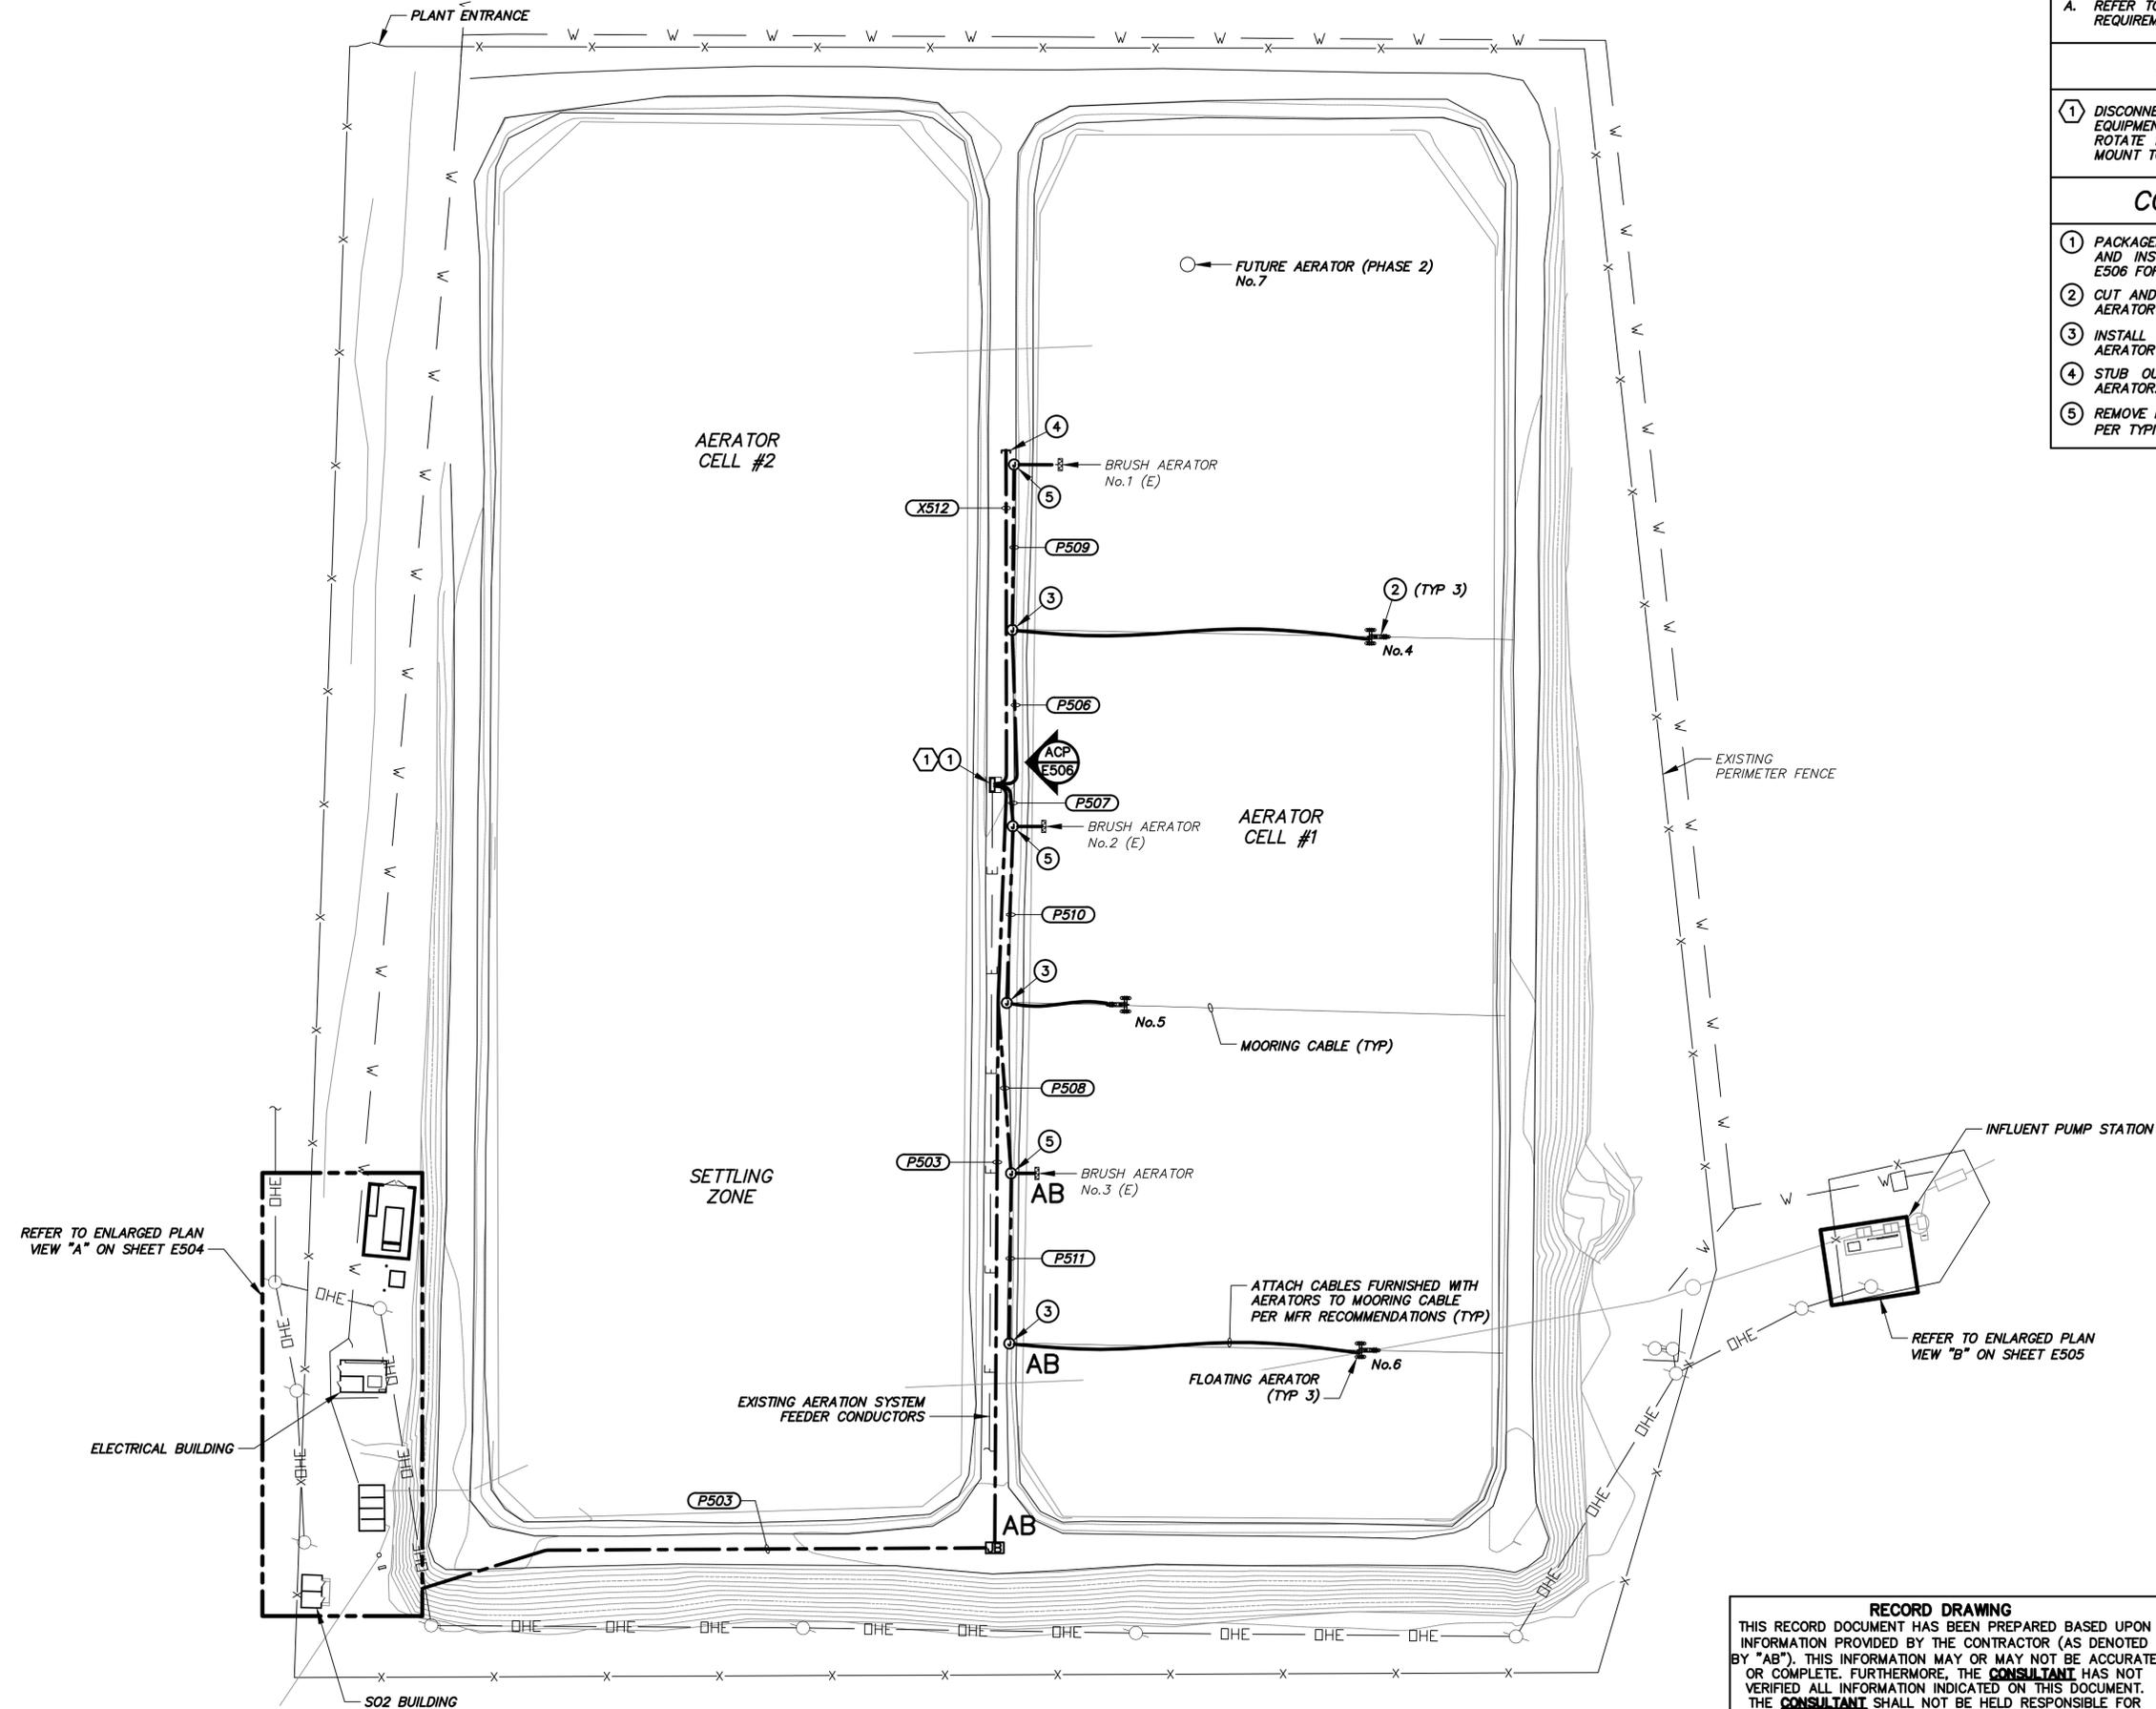

REFER TO ENLARGED PLAN VIEW "A" ON SHEET E504

ELECTRICAL BUILDING

S02 BUILDING

SETTLING ZONE

AERATOR CELL #2

FUTURE AERATOR (PHASE 2) No.7

BRUSH AERATOR No.1 (E)

BRUSH AERATOR No.2 (E)

AERATOR CELL #1

BRUSH AERATOR No.3 (E)

ATTACH CABLES FURNISHED WITH AERATORS TO MOORING CABLE PER MFR RECOMMENDATIONS (TYP)

FLOATING AERATOR (TYP 3) No.6

MOORING CABLE (TYP)


EXISTING PERIMETER FENCE

INFLUENT PUMP STATION

REFER TO ENLARGED PLAN VIEW "B" ON SHEET E505

RECORD DRAWING
 THIS RECORD DOCUMENT HAS BEEN PREPARED BASED UPON INFORMATION PROVIDED BY THE CONTRACTOR (AS DENOTED BY "AB"). THIS INFORMATION MAY OR MAY NOT BE ACCURATE OR COMPLETE. FURTHERMORE, THE CONSULTANT HAS NOT VERIFIED ALL INFORMATION INDICATED ON THIS DOCUMENT. THE CONSULTANT SHALL NOT BE HELD RESPONSIBLE FOR ANY ERRORS OR OMISSIONS ON THIS DOCUMENT. THIS DOCUMENT IS FOR GENERAL INFORMATION PURPOSES ONLY. ANY OTHER USE OF THIS DOCUMENT IS AT YOUR SOLE RISK!

DARCOR
 ELECTRICAL CONSULTING ENGINEERS
 7800 N. 16TH ST. SUITE 212 PHOENIX, AZ 85020
 PH: (602) 796-2899 WWW.DARCORINC.COM

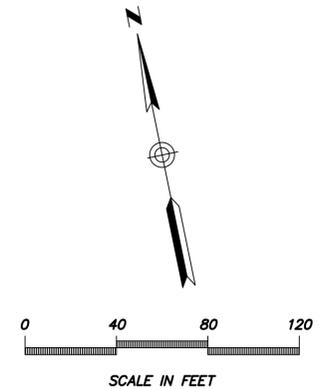

GENERAL NOTE

A. REFER TO SINGLE LINE DIAGRAM FOR CONDUIT AND CONDUCTOR REQUIREMENTS.

DEMOLITION KEY NOTE

1 DISCONNECT AND REMOVE EXISTING AERATOR MOTOR STARTERS, EQUIPMENT RACK AND AERATOR BRANCH CIRCUIT CONDUCTORS. ROTATE EXISTING 200A DISCONNECT SWITCH 90 DEGREES AND MOUNT TO SIDE OF NEW AERATION CONTROL PANEL.

CONSTRUCTION KEY NOTES

- 1 PACKAGED AERATION CONTROL PANEL FURNISHED BY OWNER AND INSTALLED BY CONTRACTOR. SEE ELEVATION ON SHEET E506 FOR ADDITIONAL INFORMATION.
- 2 CUT AND TERMINATE CABLE FURNISHED WITH AERATORS IN EACH AERATOR MOTOR AND BOND PER MFR REQUIREMENTS.
- 3 INSTALL JUNCTION BOX PER TYPICAL DETAIL "JB1" ADJACENT TO AERATOR ANCHOR MOORING POST.
- 4 STUB OUT AND CAP EMPTY CONDUIT FOR FUTURE PHASE 2 AERATOR.
- 5 REMOVE EXISTING JUNCTION BOX AND INSTALL NEW JUNCTION BOX PER TYPICAL DETAIL "JB1".



NAVAJO TRIBAL UTILITY AUTHORITY
 GANADO, ARIZONA

GANADO WASTEWATER TREATMENT PLANT
 LAGOON UPGRADE


SOLUTIONS FOR TODAY...
 VISION FOR TOMORROW

2201 San Pedro Dr. NE
 Building 4, Suite 200
 Albuquerque, NM 87110
 Phone: (505) 884-0700
 Fax: (505) 884-2376
 TEXAS




JOB NO: 115111
 DATE: MAR 2016
 SHEET NO: E501

Saved: March 14, 2017 File: 16019-RD-CANADO-E502.dwg Drafter: Brandon Rickerd

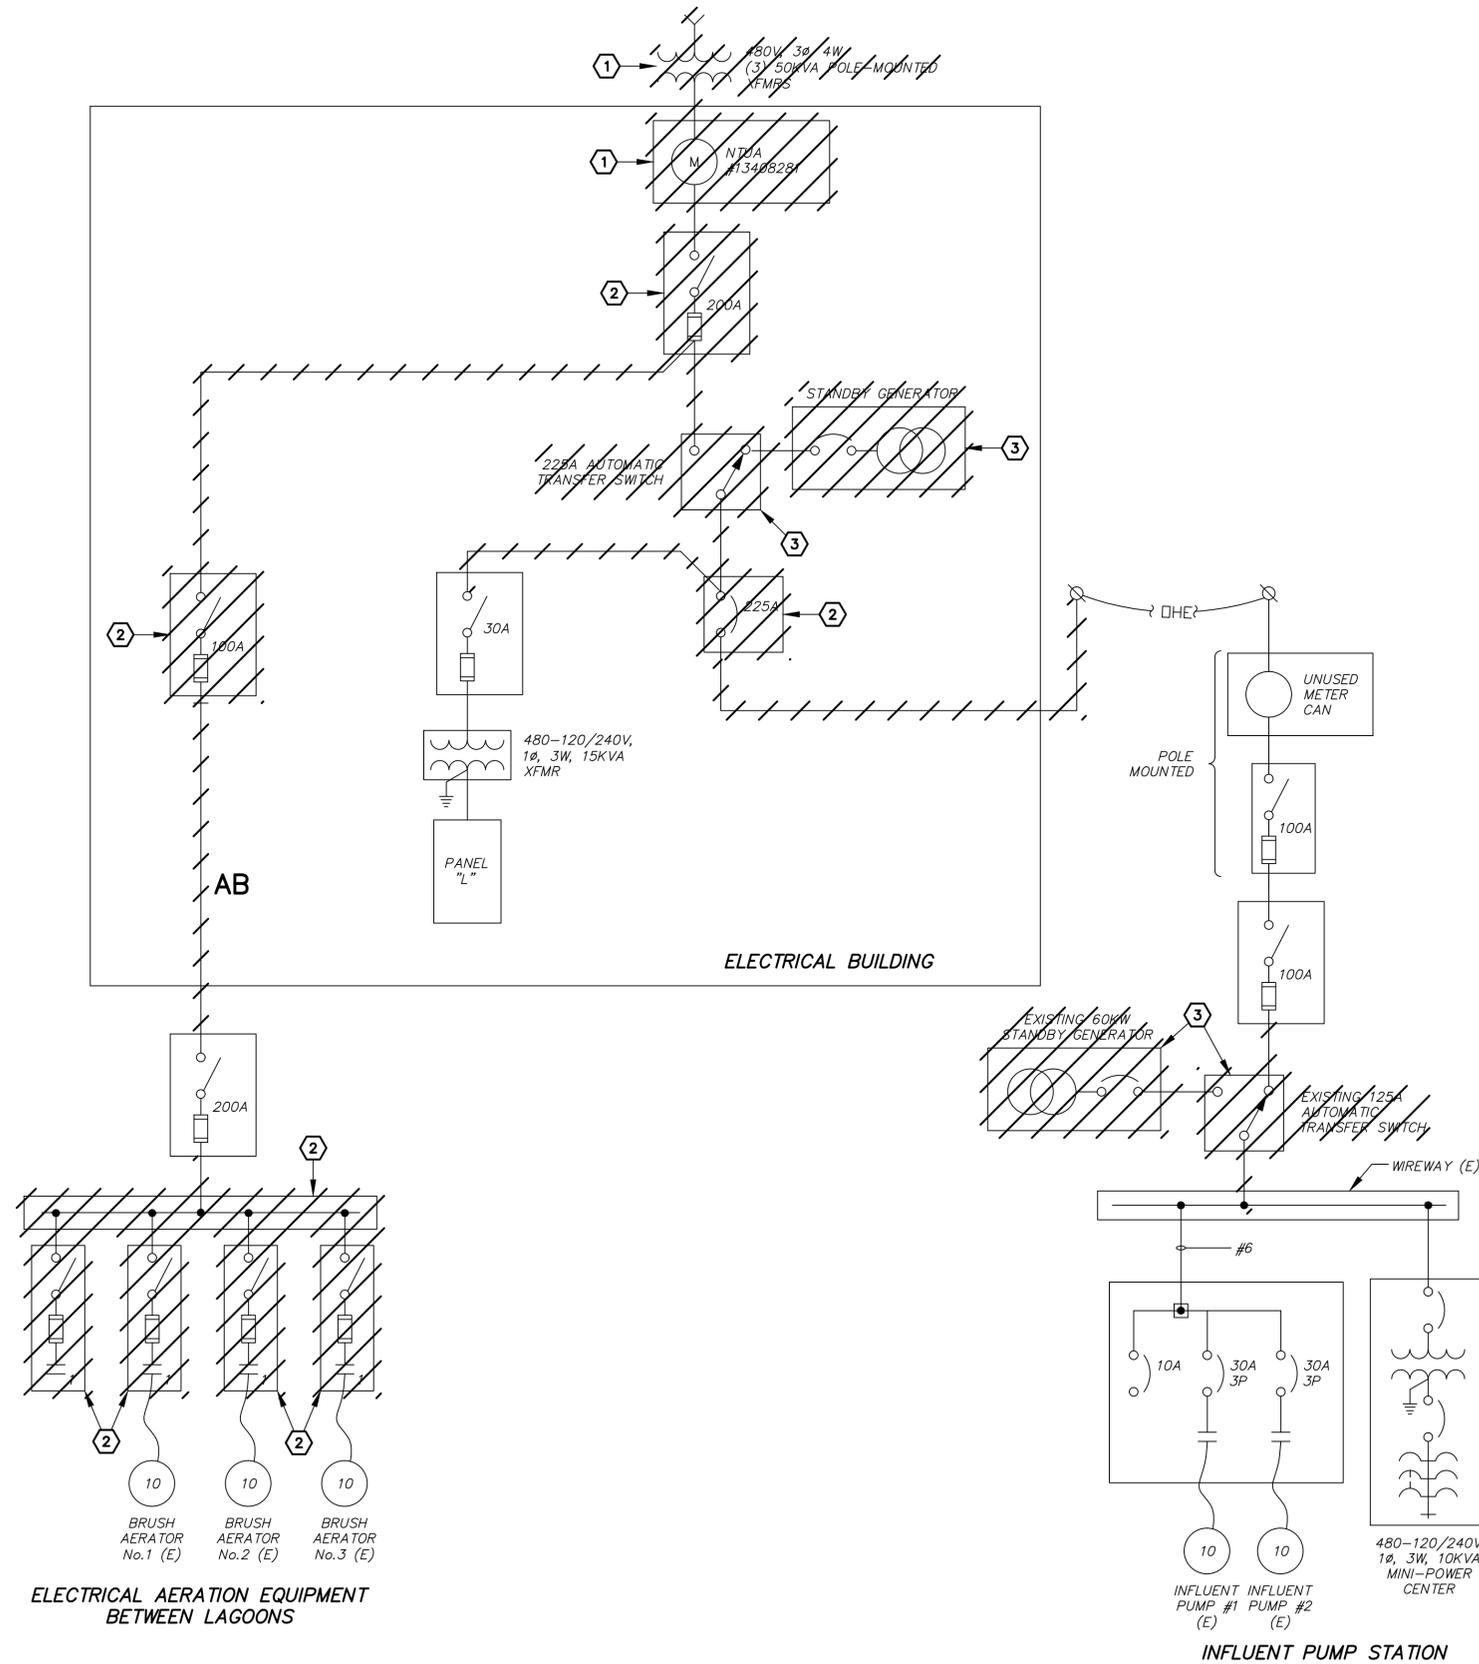

MAIN PLANT SINGLE LINE DIAGRAM DEMOLITION

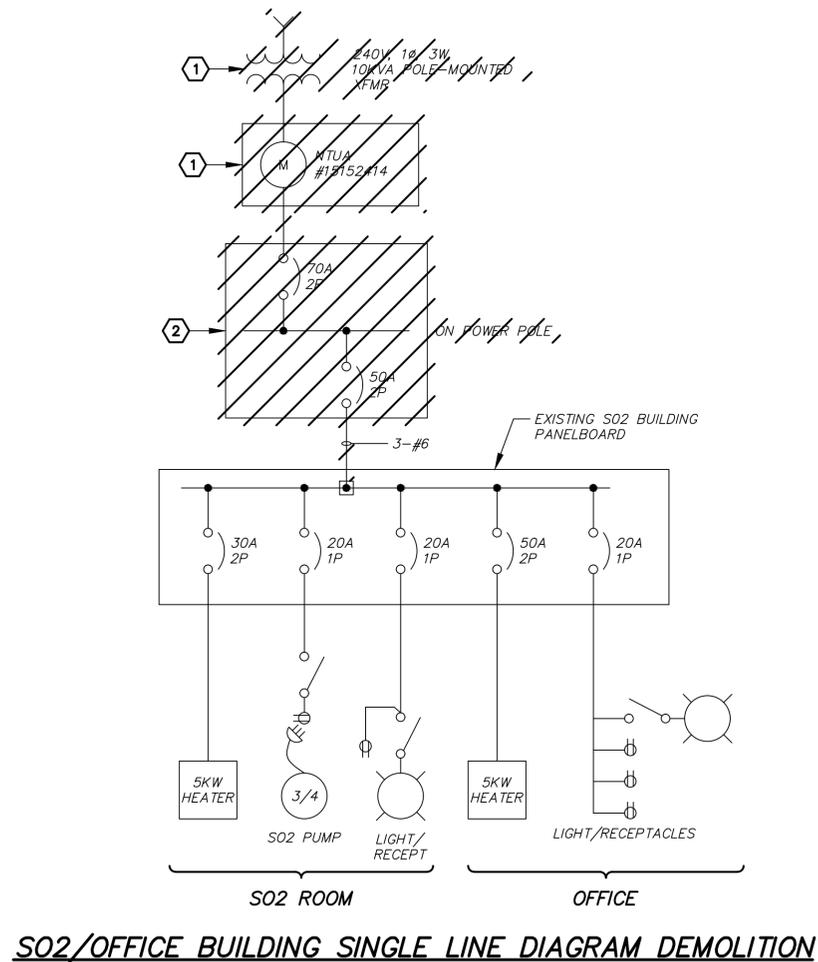

SO2/OFFICE BUILDING SINGLE LINE DIAGRAM DEMOLITION

DEMOLITION KEY NOTES

- 1 COORDINATE WITH NTUA TO DISCONTINUE POWER, THEN DISCONNECT AND REMOVE EXISTING ELECTRICAL SERVICE EQUIPMENT AS INDICATED, INCLUDING EXISTING FEEDER CONDUCTORS AND ANY EXPOSED CONDUIT. ABANDON UNDERGROUND CONDUIT IN PLACE.
- 2 DISCONNECT AND REMOVE EXISTING ELECTRICAL EQUIPMENT AS INDICATED, INCLUDING ALL EXISTING CONDUCTORS AND ANY EXPOSED CONDUIT AND JUNCTION BOXES. ABANDON UNDERGROUND CONDUIT IN PLACE.
- 3 DISCONNECT AND REMOVE EXISTING STANDBY GENERATOR AND AUTOMATIC TRANSFER SWITCH.



NAVAJO TRIBAL UTILITY AUTHORITY GANADO, ARIZONA	
NO.	DATE
1	3/13/2017
2	3/21/16
3	
4	
DESIGN BY: JLG	CHECK BY: DAR
DRWN BY: DAR	DATE: 3/13/2017
BY: DAR	NO. 1
DESCRIPTION	REVISION
CONTRACTOR	REDLINES
AS BUILT PER	CONTRACTOR

**GANADO WASTEWATER TREATMENT PLANT
LAGOON UPGRADE
ELECTRICAL
SINGLE LINE DIAGRAM DEMOLITIONS**

SOLUTIONS FOR TODAY...
VISION FOR TOMORROW
2201 San Pedro Dr. NE
Building 4, Suite 200
Albuquerque, NM 87110
Phone: (505) 884-0700
Fax: (505) 884-2376
TEXAS




RECORD DRAWING
THIS RECORD DOCUMENT HAS BEEN PREPARED BASED UPON INFORMATION PROVIDED BY THE CONTRACTOR (AS DENOTED BY "AB"). THIS INFORMATION MAY OR MAY NOT BE ACCURATE OR COMPLETE. FURTHERMORE, THE CONSULTANT HAS NOT VERIFIED ALL INFORMATION INDICATED ON THIS DOCUMENT. THE CONSULTANT SHALL NOT BE HELD RESPONSIBLE FOR ANY ERRORS OR OMISSIONS ON THIS DOCUMENT. THIS DOCUMENT IS FOR GENERAL INFORMATION PURPOSES ONLY. ANY OTHER USE OF THIS DOCUMENT IS AT YOUR SOLE RISK!

DARCOR
ELECTRICAL CONSULTING ENGINEERS
115111
DATE: MAR 2016
SHEET NO: E502

7800 N. 16TH ST.
SUITE 212
PHOENIX, AZ 85020
PH: (602) 796-8899
WWW.DARCORINC.COM

480V, 3 φ LOAD CALCULATIONS


LOADS	KVA	H.P.	AMPS
EXISTING INFLUENT PUMP No.1	--	10	14.0
EXISTING INFLUENT PUMP No.2	--	10	14.0
EXISTING PANEL "L" TRANSFORMER (1 φ)	15	--	31.3
EXISTING MINI-POWER CENTER (1 φ)	10	--	20.8
EXISTING BRUSH AERATOR No.1	--	10	14.0
EXISTING BRUSH AERATOR No.2	--	10	14.0
EXISTING BRUSH AERATOR No.3	--	10	14.0
CELL 1 AERATOR No.4	--	25	34.0
CELL 1 AERATOR No.5	--	25	34.0
CELL 1 AERATOR No.6	--	25	34.0
FUTURE CELL 1 AERATOR No.7	--	25	34.0
FUTURE CELL 2 AERATOR No.1	--	25	34.0
FUTURE CELL 2 AERATOR No.2	--	25	34.0
FUTURE CELL 2 AERATOR No.3	--	25	34.0
FUTURE CELL 2 AERATOR No.4	--	25	34.0
PANEL "A" TRANSFORMER (1 φ)	25	--	52.1
SUBTOTAL =			446.2
+25% OF LARGEST MOTOR (25HP) =			8.5
MINIMUM SERVICE SIZE =			454.7
SELECTED SERVICE SIZE =			600A

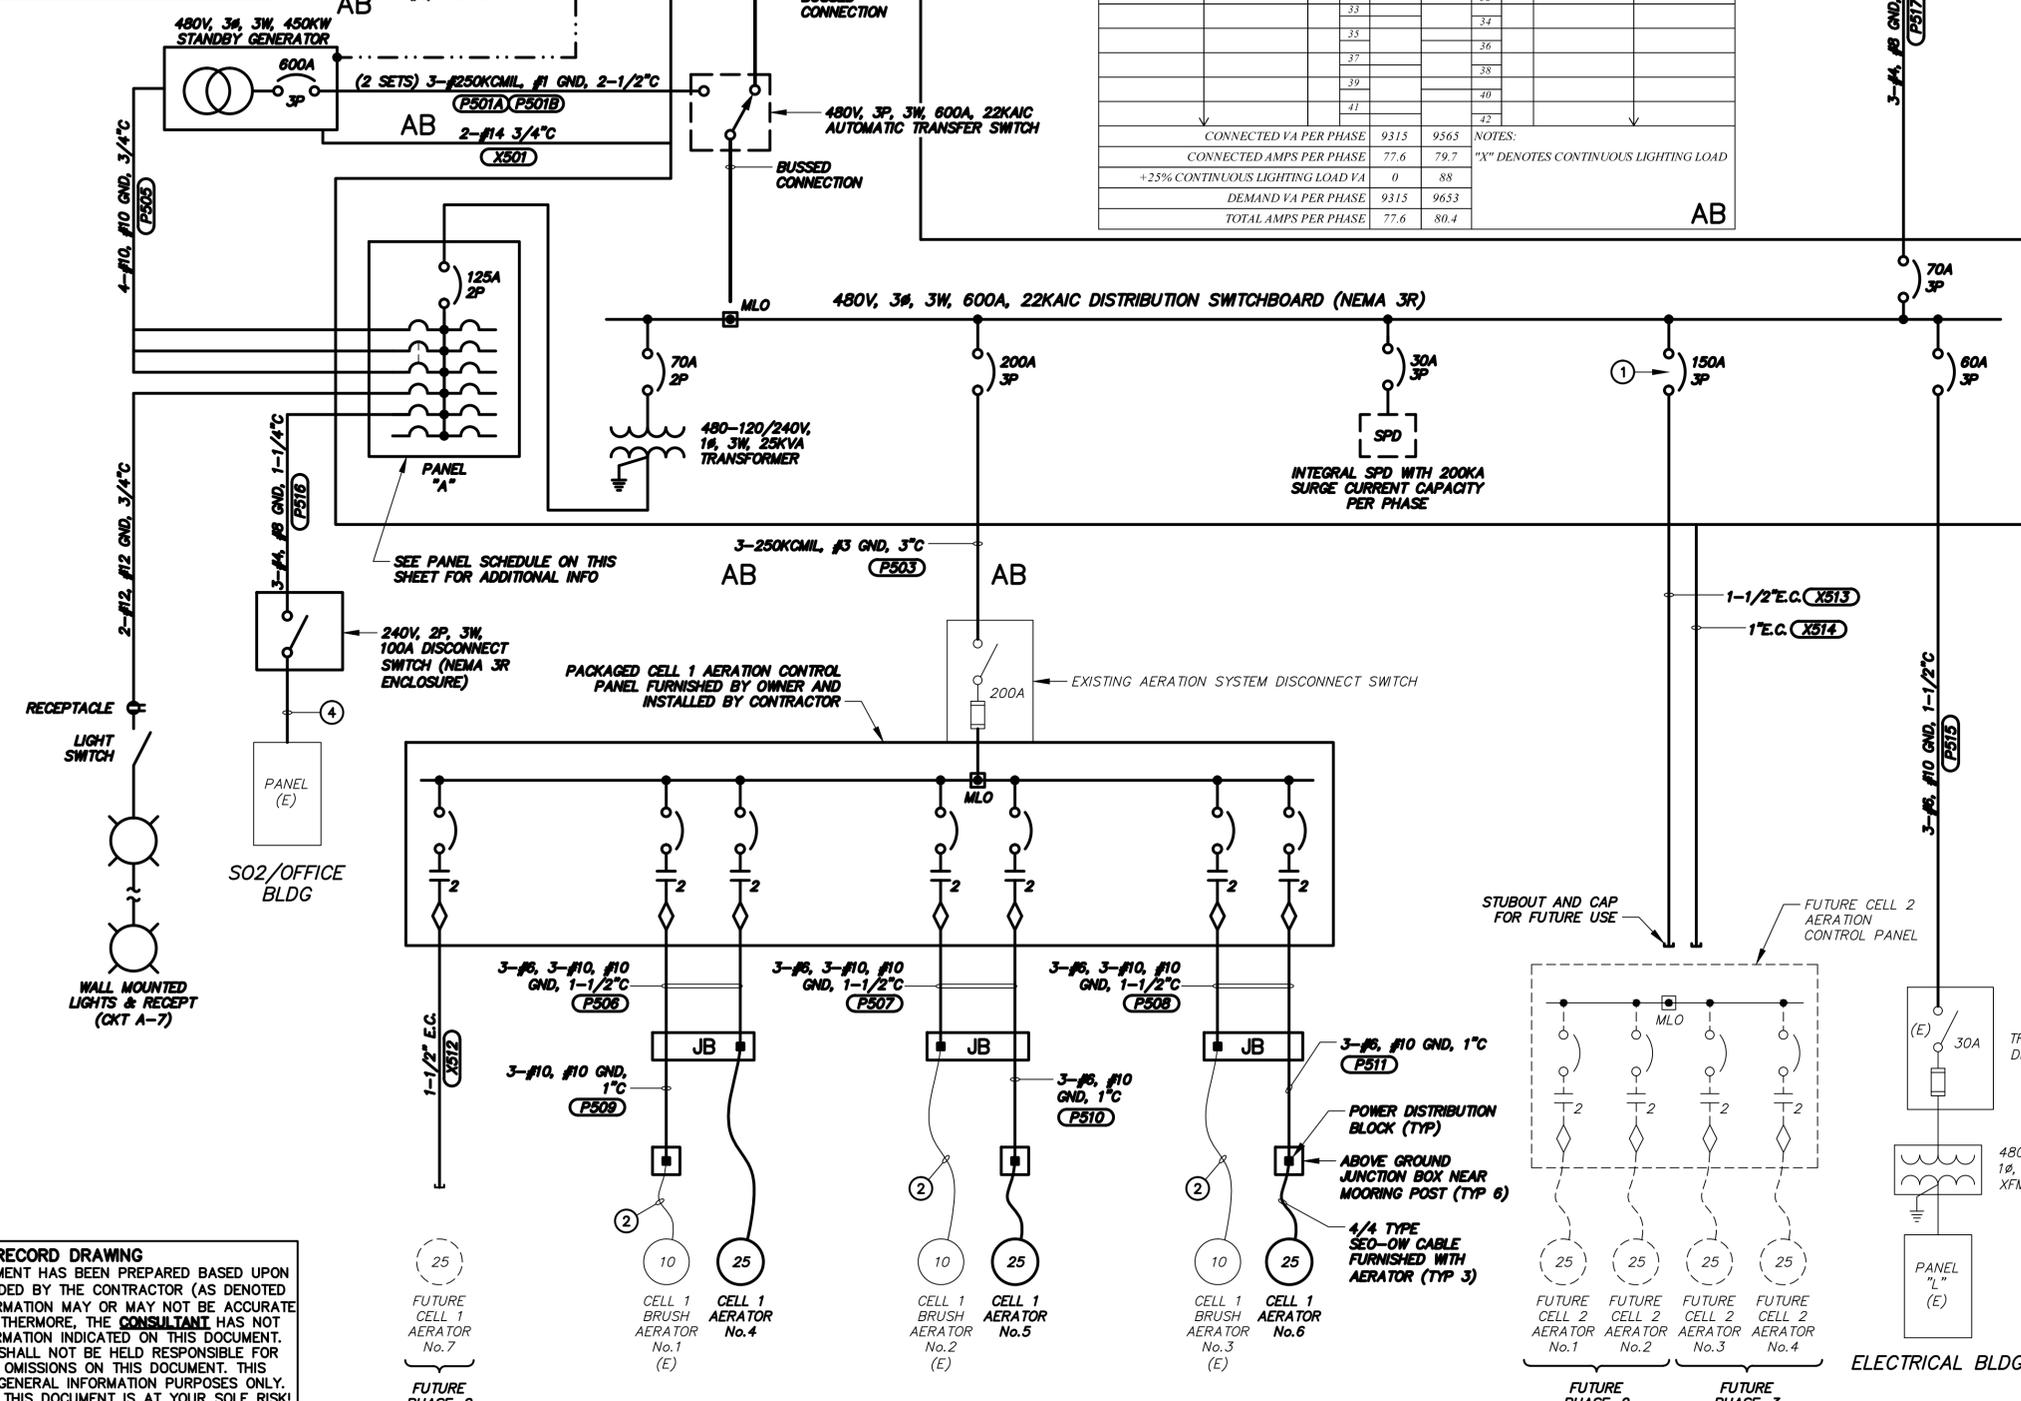

PANEL: A		VOLTAGE: 240 / 120 1Ø		MAINS: 125A MCB		BUS AMPS: 225A	
TYPE: BOLT-ON		ENCLOSURE: OPEN STYLE		MOUNTING: IN SWBD		MIN AIC: 10,000	
VA LOAD							
CIRCUIT DESCRIPTION	BKR	CKT	φ A	φ B	CKT	BKR	CIRCUIT DESCRIPTION
GENERATOR BATTERY CHARGER	20	1	100		2	70	SO2/OFFICE BLDG PANELBOARD
GENERATOR BLOCK HEATER	30	5	2495	6720	4		
WALL MTD LTS & RECEPT	20	7	0	350	8	20	SPARE
SPACE		9		0	8		SPARE
		11			10		SPACE
		13			12		
		15			14		
		17			16		
		19			18		
		21			20		
		23			22		
		25			24		
		27			26		
		29			28		
		31			30		
		33			32		
		35			34		
		37			36		
		39			38		
		41			40		
		43			42		
CONNECTED VA PER PHASE			9315	9565	NOTES:		
CONNECTED AMPS PER PHASE			77.6	79.7	"X" DENOTES CONTINUOUS LIGHTING LOAD		
+25% CONTINUOUS LIGHTING LOAD VA			0	88			
DEMAND VA PER PHASE			9315	9653			
TOTAL AMPS PER PHASE			77.6	80.4			

CONSTRUCTION KEY NOTES

- FURNISH CIRCUIT BREAKER WITH A PADLOCKING DEVICE TO ALLOW CIRCUIT BREAKER TO BE PADLOCKED IN THE OFF POSITION.
- EXISTING AERATOR CABLE
- AFTER REMOVAL OF AUTOMATIC TRANSFER SWITCH, INSTALL 3-#2, #8 GND, 1-1/2" C FROM 100A DISCONNECT SWITCH TO WIREWAY AND SPLICE TO EXISTING CONDUCTORS IN WIREWAY.
- INSTALL 3-#4, #8 GND IN EXISTING CONDUIT NIPPLE PASSING THROUGH BUILDING WALL.

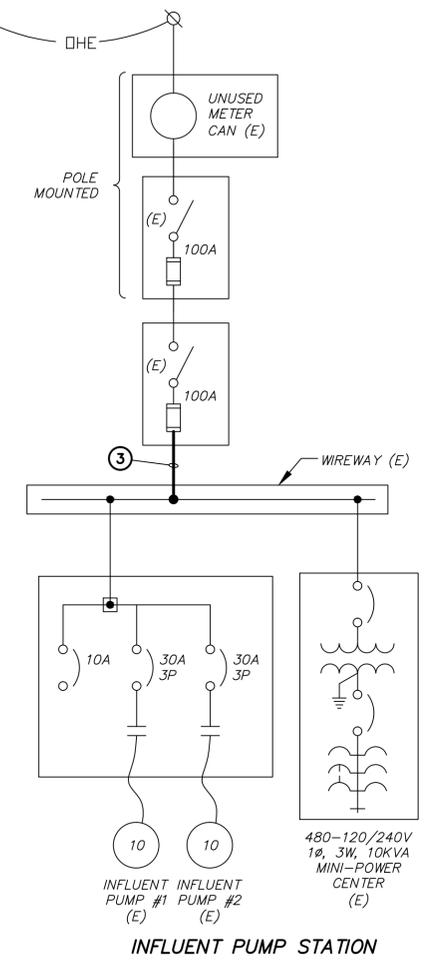

NAVAJO TRIBAL UTILITY AUTHORITY
GANADO, ARIZONA

NO. 1
DATE 3/13/2017
BY DAR

NO. 2
DATE 3/21/16
BY REYNOLDS

NO. 3
DATE 3/21/16
BY REYNOLDS

NO. 4
DATE 3/21/16
BY REYNOLDS

NO. 5
DATE 3/21/16
BY REYNOLDS

NO. 6
DATE 3/21/16
BY REYNOLDS

NO. 7
DATE 3/21/16
BY REYNOLDS

NO. 8
DATE 3/21/16
BY REYNOLDS

NO. 9
DATE 3/21/16
BY REYNOLDS

NO. 10
DATE 3/21/16
BY REYNOLDS

NO. 11
DATE 3/21/16
BY REYNOLDS

NO. 12
DATE 3/21/16
BY REYNOLDS

NO. 13
DATE 3/21/16
BY REYNOLDS

NO. 14
DATE 3/21/16
BY REYNOLDS

NO. 15
DATE 3/21/16
BY REYNOLDS

NO. 16
DATE 3/21/16
BY REYNOLDS

NO. 17
DATE 3/21/16
BY REYNOLDS

NO. 18
DATE 3/21/16
BY REYNOLDS

NO. 19
DATE 3/21/16
BY REYNOLDS

NO. 20
DATE 3/21/16
BY REYNOLDS

NO. 21
DATE 3/21/16
BY REYNOLDS

NO. 22
DATE 3/21/16
BY REYNOLDS

NO. 23
DATE 3/21/16
BY REYNOLDS

NO. 24
DATE 3/21/16
BY REYNOLDS

NO. 25
DATE 3/21/16
BY REYNOLDS

NO. 26
DATE 3/21/16
BY REYNOLDS

NO. 27
DATE 3/21/16
BY REYNOLDS

NO. 28
DATE 3/21/16
BY REYNOLDS

NO. 29
DATE 3/21/16
BY REYNOLDS

NO. 30
DATE 3/21/16
BY REYNOLDS

NO. 31
DATE 3/21/16
BY REYNOLDS

NO. 32
DATE 3/21/16
BY REYNOLDS

NO. 33
DATE 3/21/16
BY REYNOLDS

NO. 34
DATE 3/21/16
BY REYNOLDS

NO. 35
DATE 3/21/16
BY REYNOLDS

NO. 36
DATE 3/21/16
BY REYNOLDS

NO. 37
DATE 3/21/16
BY REYNOLDS

NO. 38
DATE 3/21/16
BY REYNOLDS

NO. 39
DATE 3/21/16
BY REYNOLDS

NO. 40
DATE 3/21/16
BY REYNOLDS

NO. 41
DATE 3/21/16
BY REYNOLDS

NO. 42
DATE 3/21/16
BY REYNOLDS

NO. 43
DATE 3/21/16
BY REYNOLDS

NO. 44
DATE 3/21/16
BY REYNOLDS

NO. 45
DATE 3/21/16
BY REYNOLDS

NO. 46
DATE 3/21/16
BY REYNOLDS

NO. 47
DATE 3/21/16
BY REYNOLDS

NO. 48
DATE 3/21/16
BY REYNOLDS

NO. 49
DATE 3/21/16
BY REYNOLDS

NO. 50
DATE 3/21/16
BY REYNOLDS

GANADO WASTEWATER TREATMENT PLANT
LAGOON UPGRADE

ELECTRICAL
SINGLE LINE DIAGRAM

SOLUTIONS FOR TODAY...
VISION FOR TOMORROW

2201 San Pedro Dr. NE
Building 4, Suite 200
Albuquerque, NM 87110
Phone: (505) 884-0700
Fax: (505) 884-2376

TEXAS



DARCOR
ELECTRICAL CONSULTING ENGINEERS

7800 N. 16TH ST.
SUITE 212
PHOENIX, AZ 85020
PH: (602) 795-8899
WWW.DARCORINC.COM

JOB NO: 115111
DATE: MAR 2016
SHEET NO: E503

Saved: March 14, 2017 File: 16019-RD-CANADO-E503.dwg Drafter: Brandon Rickard

RECORD DRAWING
THIS RECORD DOCUMENT HAS BEEN PREPARED BASED UPON INFORMATION PROVIDED BY THE CONTRACTOR (AS DENOTED BY "AB"). THIS INFORMATION MAY OR MAY NOT BE ACCURATE OR COMPLETE. FURTHERMORE, THE CONSULTANT HAS NOT VERIFIED ALL INFORMATION INDICATED ON THIS DOCUMENT. THE CONSULTANT SHALL NOT BE HELD RESPONSIBLE FOR ANY ERRORS OR OMISSIONS ON THIS DOCUMENT. THIS DOCUMENT IS FOR GENERAL INFORMATION PURPOSES ONLY. ANY OTHER USE OF THIS DOCUMENT IS AT YOUR SOLE RISK!



NAVAJO TRIBAL UTILITY AUTHORITY GANADO, ARIZONA	
NO.	DATE
1	3/13/2017
2	
3	
4	
AS BUILT PER CONTRACTOR REDLINES	
NO.	REVISION DESCRIPTION
1	AB
2	AB
3	AB
4	AB
DESIGN BY:	JLC
CHKD BY:	DAR
DRWN BY:	DAR

GANADO WASTEWATER TREATMENT PLANT
LAGOON UPGRADE
ELECTRICAL
ENLARGED PLAN VIEW "A"

SOLUTIONS FOR TODAY...
VISION FOR TOMORROW
2201 San Pedro Dr. NE
Building 4, Suite 200
Albuquerque, NM 87110
Phone: (505) 884-0700
Fax: (505) 884-2376
TEXAS



JOB NO.: 115111
DATE: MAR 2016
SHEET NO.: E504

CONSTRUCTION KEY NOTES

- INSTALL 4" X 6" CONCRETE FILLED BOLLARD PER NTUA REQUIREMENTS.
- INSTALL CONDUIT, TRENCH AND BACKFILL PER NTUA REQUIREMENTS. REFER TO THE SINGLE LINE DIAGRAM FOR CONDUIT & CONDUCTOR REQUIREMENTS.
- INSTALL TRANSFORMER PAD AND GROUND RODS PER NTUA REQUIREMENTS.
- INSTALL WALL MOUNTED LUMINAIRE ON FLUSH MOUNTED BOX IN TOP ROW OF CMU BLOCK WALL. CONDUIT SHALL BE CONCEALED IN CMU BLOCK WALL. REFER TO SHEET E500 FOR LUMINAIRE SCHEDULE.
- INSTALL 120V, 20A GFCI RECEPTACLE WITH WP WHILE-IN-USE COVER IN FLUSH MOUNTED BOX IN CMU BLOCK WALL AT +24" AFF (CKT A-7). INSTALL 120V, 20A LIGHT SWITCH WITH WP COVER IN FLUSH MOUNTED BOX IN CMU WALL ABOVE RECEPTACLE AT +42" AFF (CKT A-7) TO CONTROL WALL MOUNTED LUMINAIRES. CONDUIT SHALL BE CONCEALED IN CMU BLOCK WALL.
- STUB OUT AND CAP CONDUITS 5- FEET PAST GENERATOR ENCLOSURE WALL FOR FUTURE USE.
- TERMINATE CONDUIT IN A "LB" ON EXTERIOR OF ELECTRICAL BUILDING AND INSTALL CONDUCTORS PER SINGLE LINE DIAGRAM.
- INSTALL 18" X 12" X 1/2" NEMA 3R JUNCTION BOX IN PLACE OF EXISTING "LB" CONDULET ON EXTERIOR WALL. STUBUP CONDUIT AND TERMINATE IN JUNCTION BOX AND SPICE TO EXISTING AERATION SYSTEM FEEDER CONDUCTORS.
- DIG DOWN, LOCATE AND INSTALL SWEEP TO EXISTING INFLUENT PUMP STATION RISER. EXTEND CONDUCTORS THROUGH EXISTING WEATHERHEAD AND SPICE TO EXISTING OVERHEAD CONDUCTORS.
- EXISTING 120V AREA LIGHTING BRANCH CIRCUIT CONDUIT AND CONDUCTORS TO REMAIN, UNDISTURBED.
- INSTALL DISCONNECT SWITCH IN PLACE OF EXISTING "LB" CONDULET ON EXTERIOR WALL OF SO2 BUILDING. UTILIZE EXISTING NIPPLE THROUGH WALL TO SO2 BUILDING PANELBOARD FOR NEW CONDUCTORS.


DEMOLITION KEY NOTES

- COORDINATE WITH NTUA TO DISCONTINUE POWER, THEN DISCONNECT AND REMOVE EXISTING ELECTRICAL SERVICE EQUIPMENT AS INDICATED, INCLUDING ALL EXISTING FEEDER CONDUCTORS AND ANY EXPOSED CONDUIT. ABANDON UNDERGROUND CONDUIT IN PLACE.
- COORDINATE WITH NTUA TO DISCONTINUE POWER, THEN DISCONNECT AND REMOVE EXISTING ELECTRICAL SERVICE ENTRANCE SECTION INCLUDING FEEDER, SERVICE RISER, WEATHERHEAD AND EXPOSED CONDUIT. ABANDON UNDERGROUND CONDUIT IN PLACE.
- DISCONNECT AND REMOVE EXISTING STANDBY GENERATOR AND DAY TANK, INCLUDING ALL EXISTING CONDUCTORS AND EXPOSED CONDUITS. ABANDON UNDERGROUND CONDUIT IN PLACE.
- DISCONNECT AND REMOVE EXISTING INFLUENT PUMP STATION FEEDER CONDUCTORS BETWEEN OVERHEAD CONDUCTOR SPLICES AND ELECTRICAL ROOM. ABANDON UNDERGROUND CONDUIT IN PLACE.
- EXISTING OVERHEAD POWER TO BE REMOVED BY NTUA.

GENERAL NOTES

- REFER TO SINGLE LINE DIAGRAM FOR CONDUIT AND CONDUCTOR REQUIREMENTS.
- ALL GENERATOR ENCLOSURE DIMENSIONS SHOWN ARE THE MINIMUM SPACE REQUIREMENTS.

RECORD DRAWING
THIS RECORD DOCUMENT HAS BEEN PREPARED BASED UPON INFORMATION PROVIDED BY THE CONTRACTOR (AS DENOTED BY "AB"). THIS INFORMATION MAY OR MAY NOT BE ACCURATE OR COMPLETE. FURTHERMORE, THE CONSULTANT HAS NOT VERIFIED ALL INFORMATION INDICATED ON THIS DOCUMENT. THE CONSULTANT SHALL NOT BE HELD RESPONSIBLE FOR ANY ERRORS OR OMISSIONS ON THIS DOCUMENT. THIS DOCUMENT IS FOR GENERAL INFORMATION PURPOSES ONLY. ANY OTHER USE OF THIS DOCUMENT IS AT YOUR SOLE RISK!

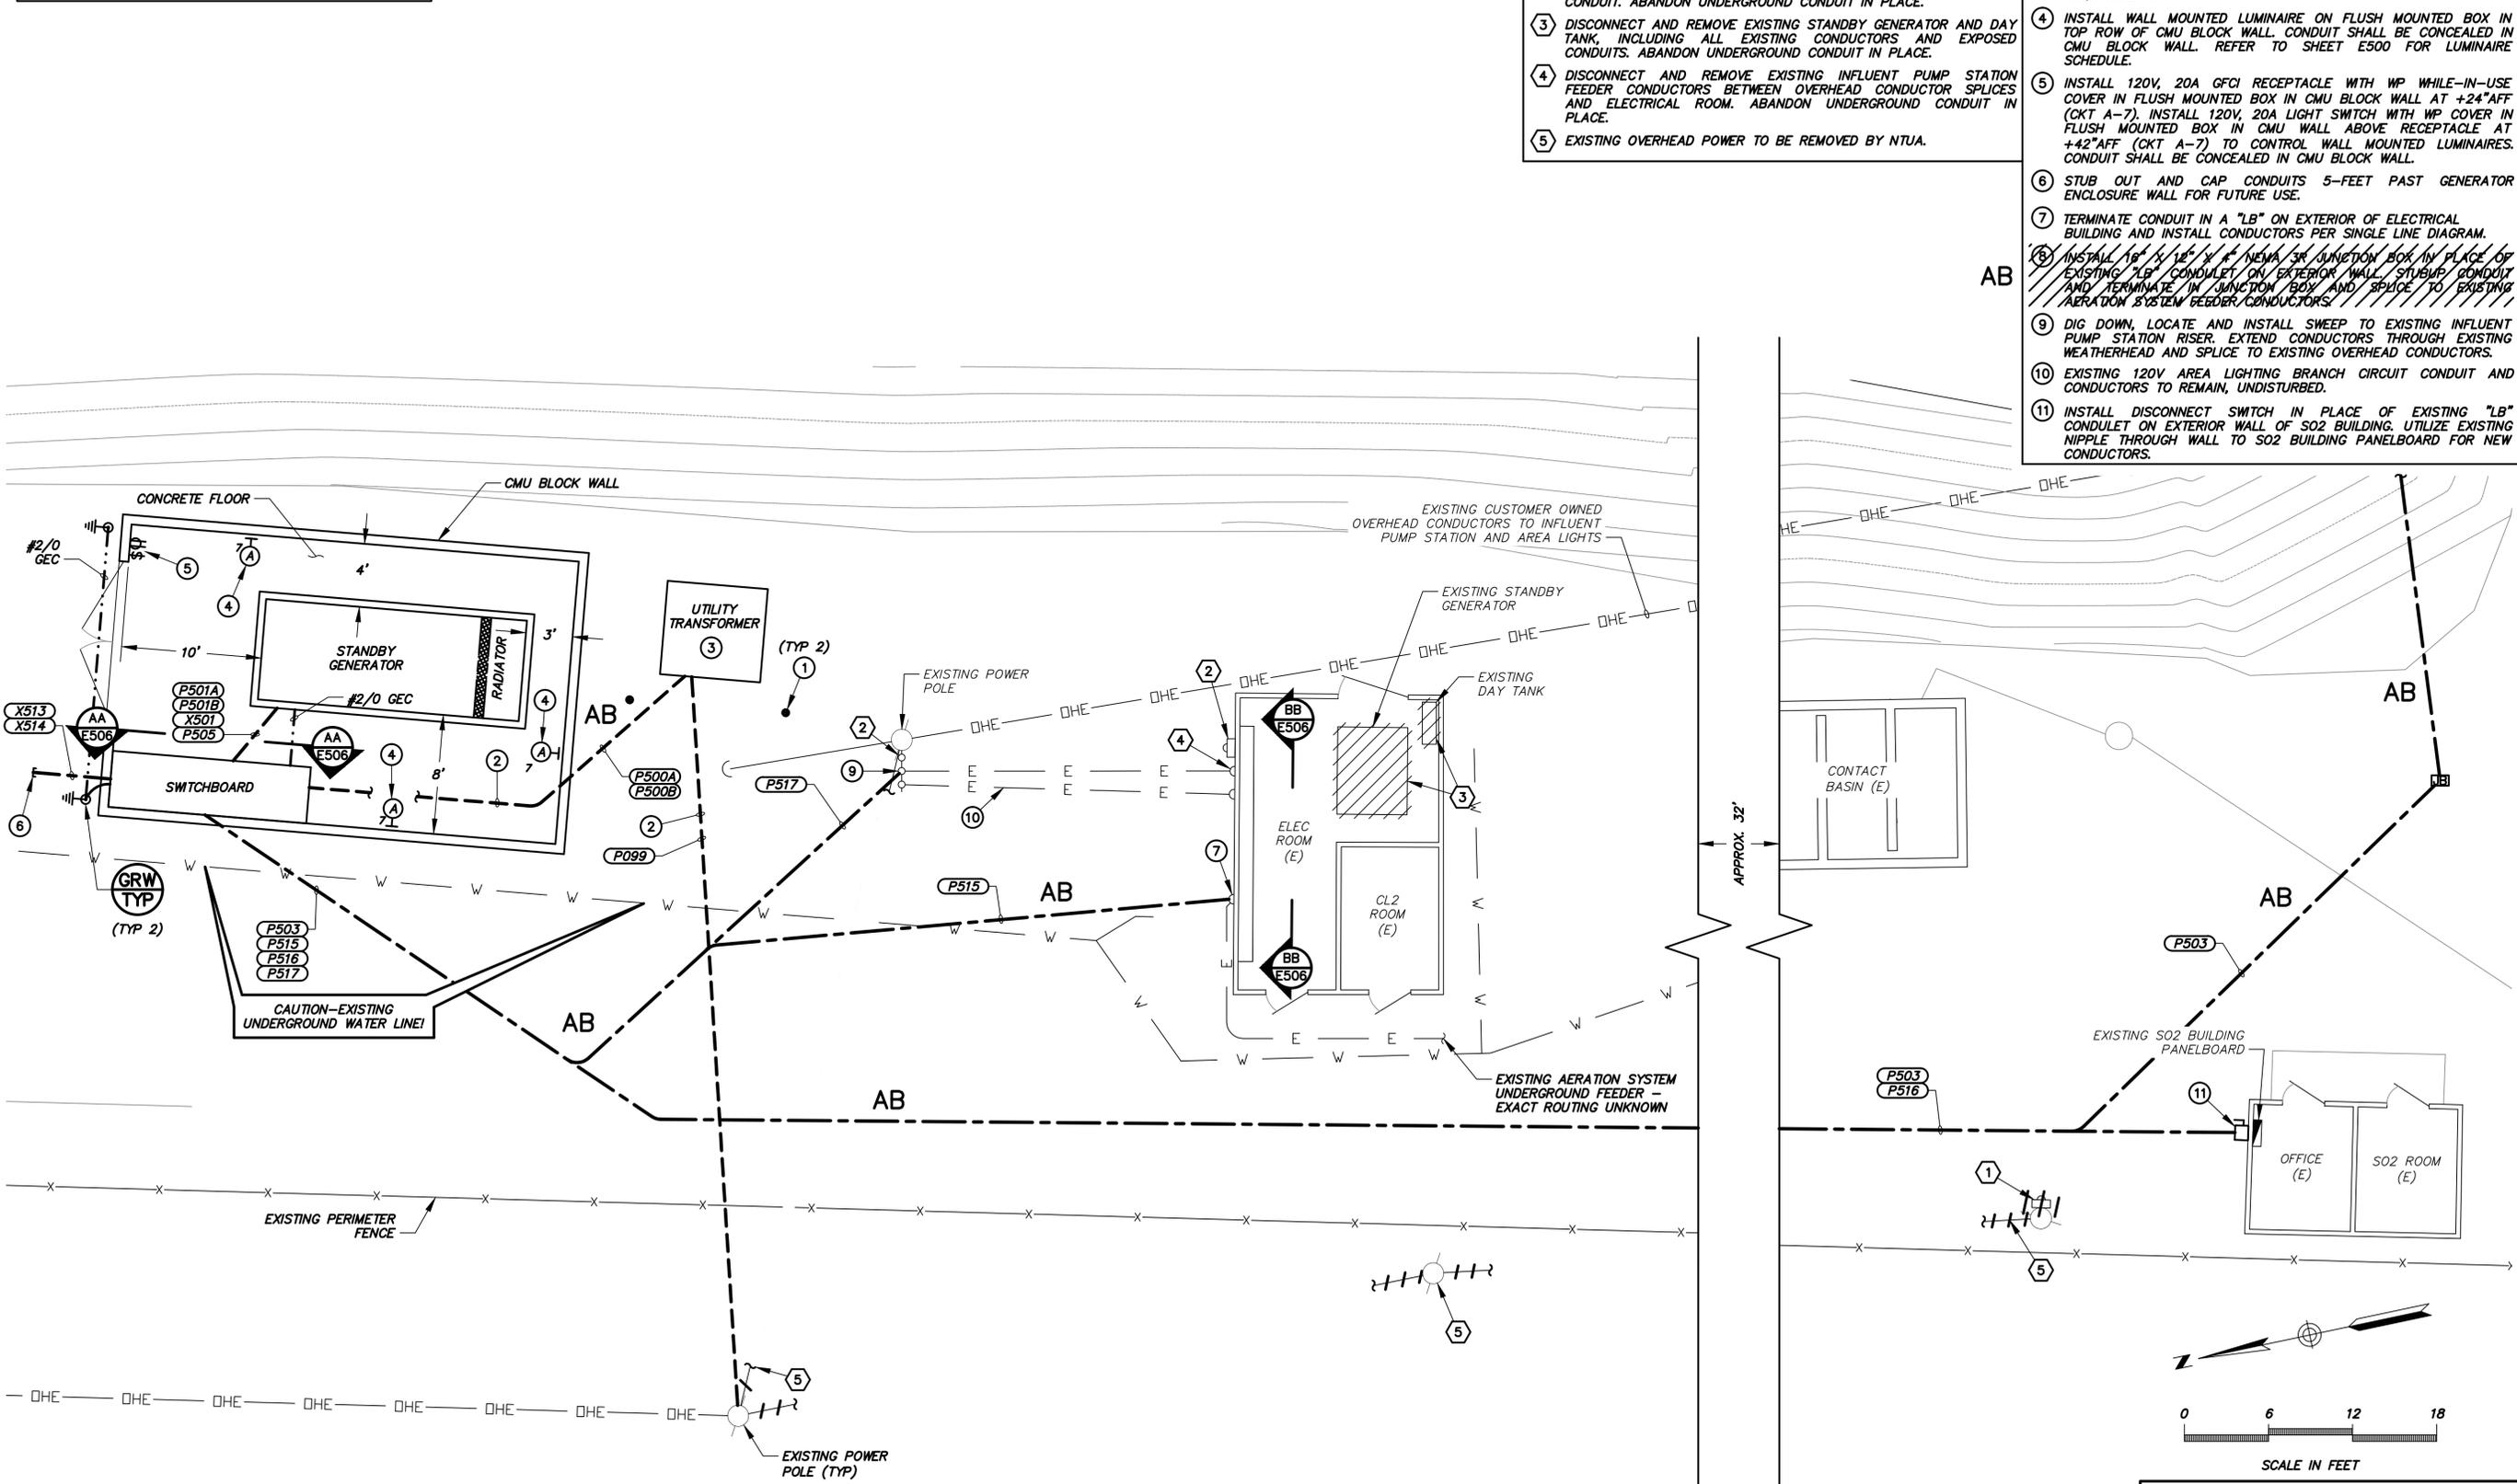

Saved: March 14, 2017 File: 16019-RD-GANADO-E504.dwg Drafter: Brandon Rickard

DARCOR
ELECTRICAL CONSULTING ENGINEERS
7600 N. 16TH ST.
SUITE 212
PHOENIX, AZ 85020
Ph: (602) 796-2899
WWW.DARCORINC.COM

Saved: March 14, 2017 File: 16019-RD-CANADO-E505.dwg Drafter: Brandon Rickard

DEMOLITION KEY NOTE


① DISCONNECT AND REMOVE EXISTING STANDBY GENERATOR AND AUTOMATIC TRANSFER SWITCH, INCLUDING ALL CONDUIT AND CONDUCTORS. DELIVER GENERATOR AND TRANSFER SWITCH TO NTUA CHINLE DISTRICT WAREHOUSE IN CHINLE, ARIZONA.

CONSTRUCTION KEY NOTE


① INSTALL CONDUIT AND CONDUCTORS FROM EXISTING 100A DISCONNECT SWITCH TO WIREWAY PER SINGLE LINE DIAGRAM ON SHEET E503. SPLICE TO EXISTING CONDUCTORS IN WIREWAY AS PREVIOUS CONDUCTORS WERE SPICED



NAVAJO TRIBAL UTILITY AUTHORITY GANADO, ARIZONA	
NO.	DATE
1	3/13/2017
2	
3	
4	
DESIGN BY: JLG	CHKD BY: DAR
DRWN BY: DAR	DATE: 3/13/2017
	BY: DAR

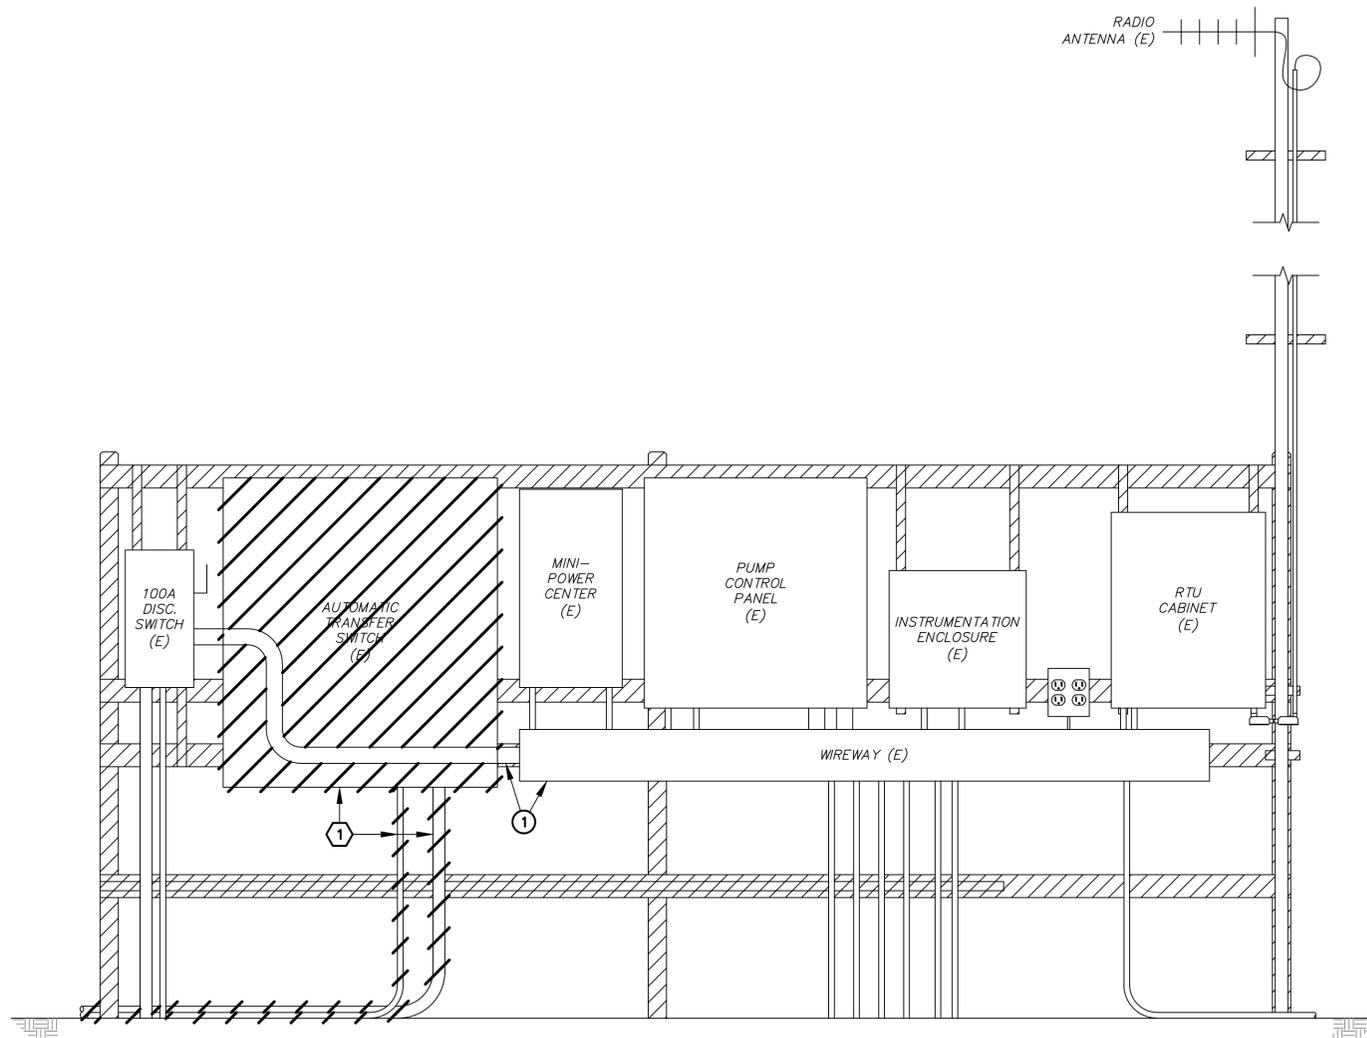

CC ELECTRICAL EQUIPMENT ELEVATION
NTS

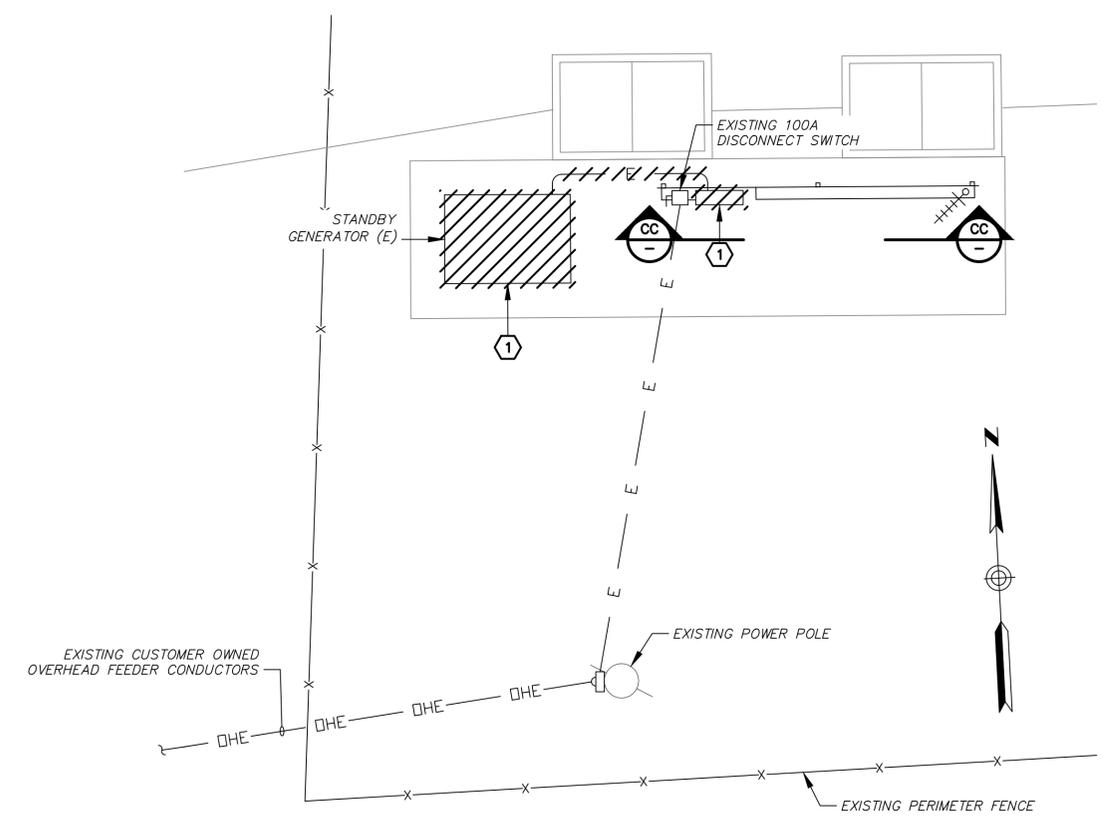

ENLARGED PLAN VIEW "B" (INFLUENT P.S.)



RECORD DRAWING
THIS RECORD DOCUMENT HAS BEEN PREPARED BASED UPON INFORMATION PROVIDED BY THE CONTRACTOR (AS DENOTED BY "AB"). THIS INFORMATION MAY OR MAY NOT BE ACCURATE OR COMPLETE. FURTHERMORE, THE CONSULTANT HAS NOT VERIFIED ALL INFORMATION INDICATED ON THIS DOCUMENT. THE CONSULTANT SHALL NOT BE HELD RESPONSIBLE FOR ANY ERRORS OR OMISSIONS ON THIS DOCUMENT. THIS DOCUMENT IS FOR GENERAL INFORMATION PURPOSES ONLY. ANY OTHER USE OF THIS DOCUMENT IS AT YOUR SOLE RISK!

DARCOR
ELECTRICAL CONSULTING ENGINEERS
7600 N. 16TH ST.
SUITE 212
PHOENIX, AZ 85020
PH: (602) 796-2899
WWW.DARCORINC.COM


GANADO WASTEWATER TREATMENT PLANT
LAGOON UPGRADE
ELECTRICAL
ENLARGED PLAN VIEW "B"

SOLUTIONS FOR TODAY...
VISION FOR TOMORROW
2201 San Pedro Dr. NE
Building 4, Suite 200
Albuquerque, NM 87110
Phone: (505) 884-0700
Fax: (505) 884-2376
TEXAS




JOB NO: 115111
DATE: MAR 2016
SHEET NO: E505

Saved: March 14, 2017 File: 16019-RD-CANADO-E506.dwg Drafter: Brandon Rickard

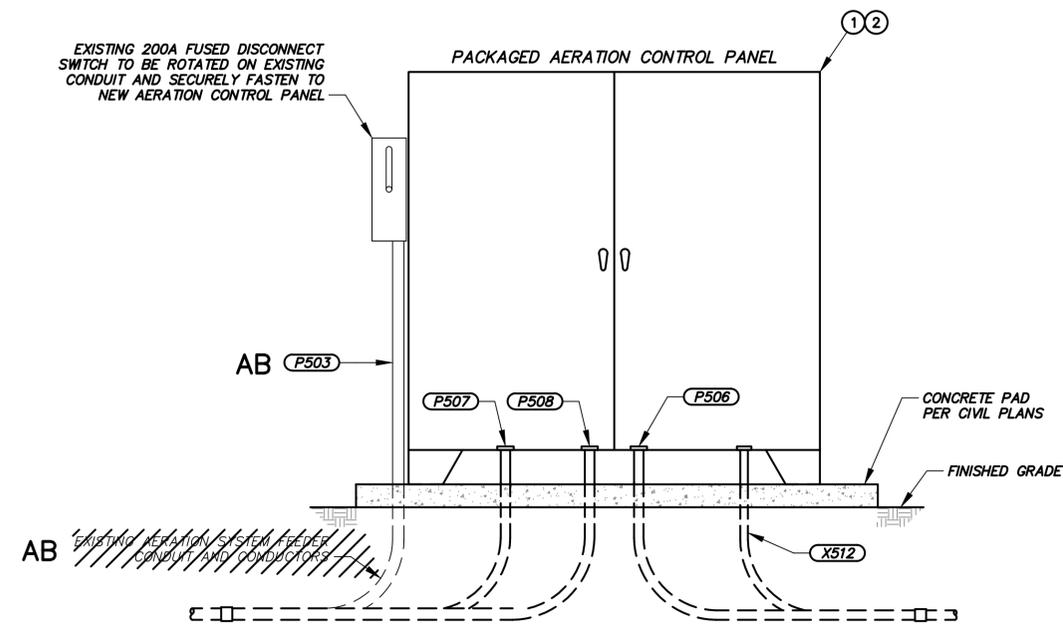


ACP E501 PACKAGED AERATION CONTROL PANEL ELEVATION
NTS

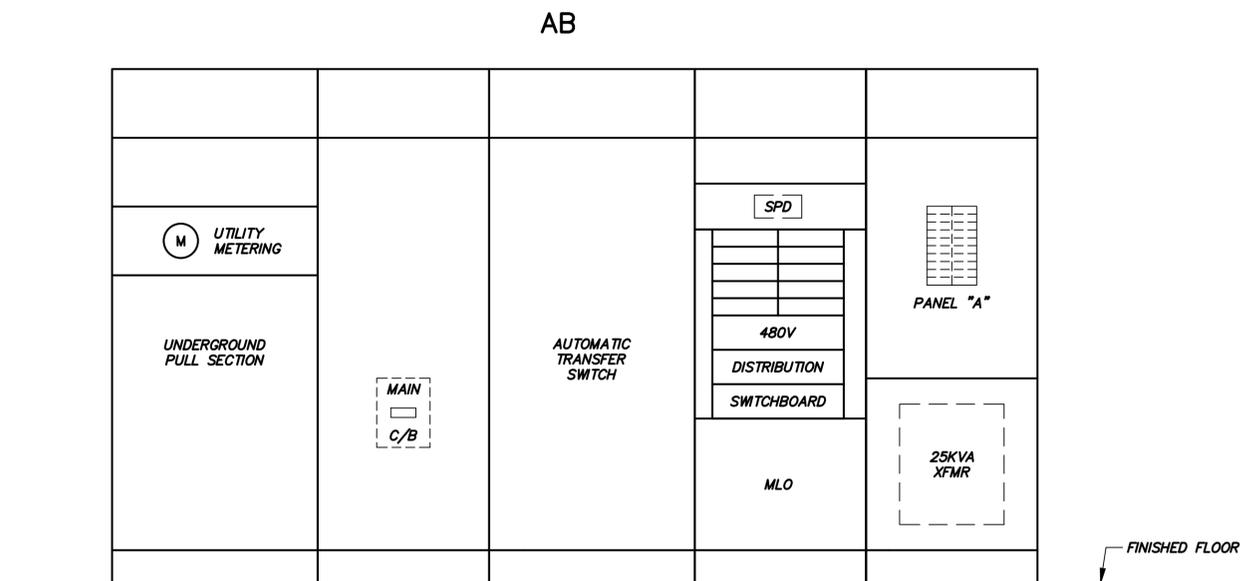

NOTE: FASTEN ELECTRICAL EQUIPMENT TO CONCRETE USING 3/8" GALVANIZED STEEL CONCRETE ANCHORS

AA E504 ELECTRICAL EQUIPMENT ELEVATION
NTS

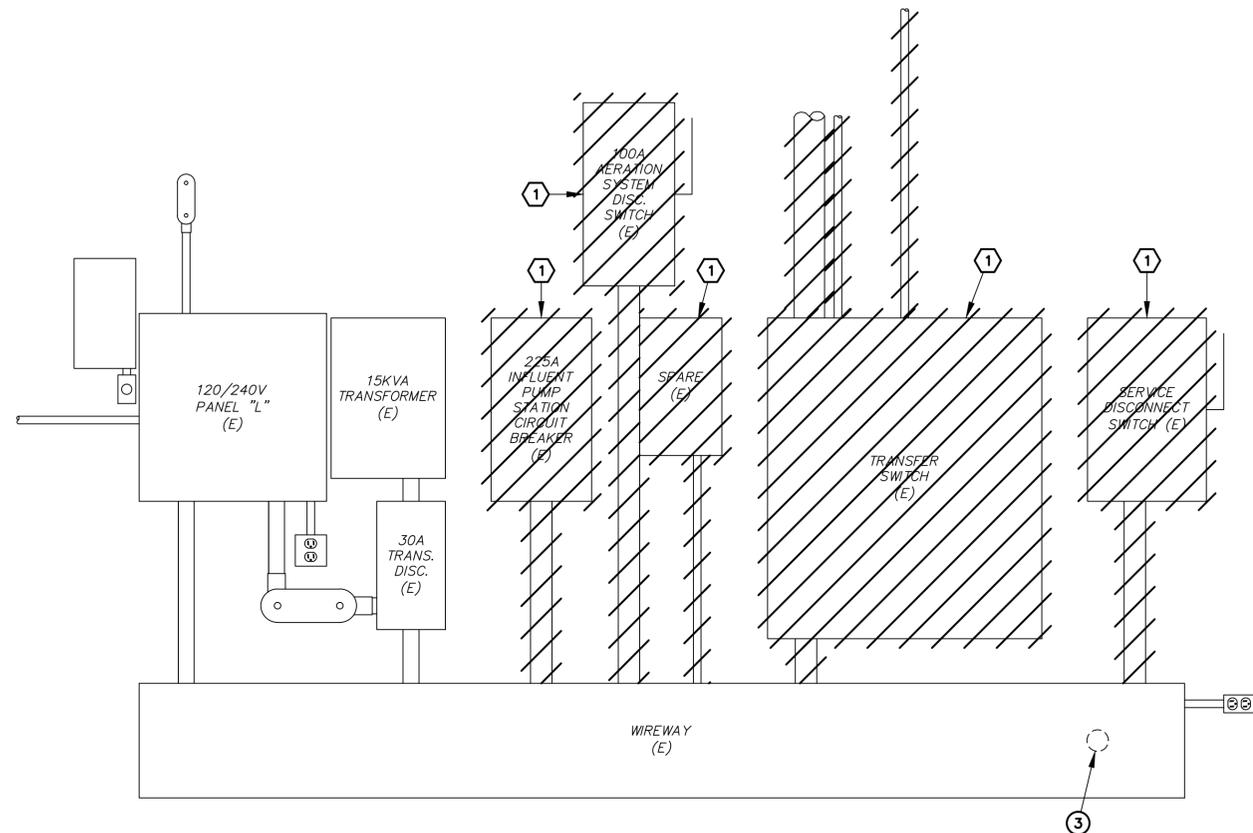

BB E504 ELECTRICAL EQUIPMENT ELEVATION
NTS

DEMOLITION KEY NOTE

- ① DISCONNECT AND REMOVE EXISTING SERVICE DISCONNECT SWITCH, TRANSFER SWITCH, AERATION SYSTEM DISCONNECT SWITCH, AND INFLUENT PUMP STATION CIRCUIT BREAKER INCLUDING ALL CONDUITS AND CONDUCTORS.

CONSTRUCTION KEY NOTES

- ① PACKAGED AERATION CONTROL PANEL FURNISHED BY OWNER AND INSTALLED BY CONTRACTOR.
- ② ANCHOR ENCLOSURE TO CONCRETE PAD WITH (4) 3/8" CONCRETE ANCHORS.
- ③ UTILIZE EXISTING 1-1/2" CONDUIT STUBBED THROUGH WALL INTO WIREWAY FOR CONDUCTORS IN CONDUIT P515.



NAVAJO TRIBAL UTILITY AUTHORITY GANADO, ARIZONA	
NO.	DATE
1	3/13/2017
2	
3	
4	

GANADO WASTEWATER TREATMENT PLANT
LAGOON UPGRADE

AS BUILT PER CONTRACTOR REDLINES
DATE: 3/13/2017
BY: DAR
DESCRIPTION: ELECTRICAL ELEVATIONS
CHKD BY: DAR
DRWN BY: JLG

SOLUTIONS FOR TODAY...
VISION FOR TOMORROW

2201 San Pedro Dr. NE
Building 4, Suite 200
Albuquerque, NM 87110
Phone: (505) 884-0700
Fax: (505) 884-2376
TEXAS



RECORD DRAWING
THIS RECORD DOCUMENT HAS BEEN PREPARED BASED UPON INFORMATION PROVIDED BY THE CONTRACTOR (AS DENOTED BY "AB"). THIS INFORMATION MAY OR MAY NOT BE ACCURATE OR COMPLETE. FURTHERMORE, THE CONSULTANT HAS NOT VERIFIED ALL INFORMATION INDICATED ON THIS DOCUMENT. THE CONSULTANT SHALL NOT BE HELD RESPONSIBLE FOR ANY ERRORS OR OMISSIONS ON THIS DOCUMENT. THIS DOCUMENT IS FOR GENERAL INFORMATION PURPOSES ONLY. ANY OTHER USE OF THIS DOCUMENT IS AT YOUR SOLE RISK!

DARCOR
ELECTRICAL CONSULTING ENGINEERS

7800 N. 16TH ST.
SUITE 212
PHOENIX, AZ 85020
Ph: (602) 796-2899
WWW.DARCORINC.COM

JOB NO: 115111
DATE: MAR 2016
SHEET NO: E506



NAVAJO TRIBAL UTILITY AUTHORITY GANADO, ARIZONA		DATE	BY
NO.	DESCRIPTION	DATE	BY
1	AS BUILT PER CONTRACTOR REDLINES	3/13/2017	DAR
2	REVISION		
3			
4			
DGN BY: JLG		CHKD BY: DAR	DRWN BY: DRG

GANADO WASTEWATER TREATMENT PLANT
LAGOON UPGRADE


ELECTRICAL
DETAILS

SOLUTIONS FOR TODAY...
VISION FOR TOMORROW

2201 San Pedro Dr. NE
Building 4, Suite 200
Albuquerque, NM 87110
Phone: (505) 884-0700
Fax: (505) 884-2376
TEXAS




JOB NO.: 115111
DATE: MAR 2016
SHEET NO.: E507

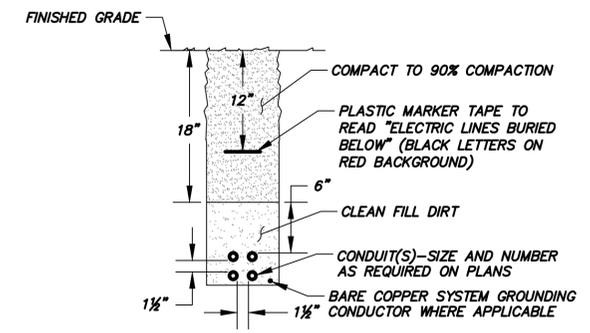


- NOTES:**
1. ALL DIMENSIONS INDICATED ABOVE ARE MINIMUM.
 2. SPARE CONDUITS MUST BE LOCATED ON TOP OF DUCTBANKS.
 3. THIS DETAIL APPLIES IN ALL CASES WHETHER SPECIFICALLY REFERRED TO OR NOT.
 4. THIS DETAIL DOES NOT APPLY TO UTILITY DUCTBANKS.

UDG TYP TYPICAL UNDERGROUND CONDUIT DUCTBANK DETAIL
NTS

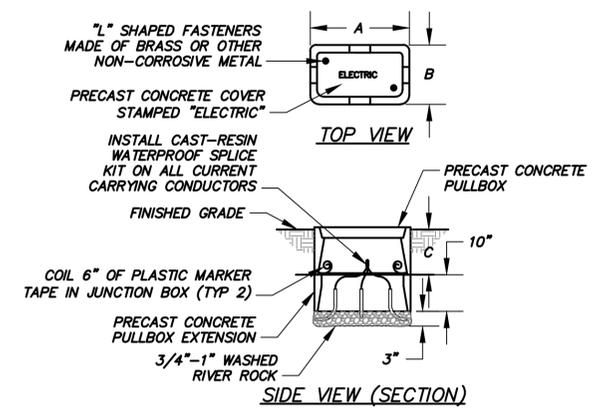


TYPE	DIM. A	DIM. B	DIM. C
#5	25"	15-1/2"	12"


UJB TYP TYPICAL UNDERGROUND JUNCTION BOX DETAIL
NTS

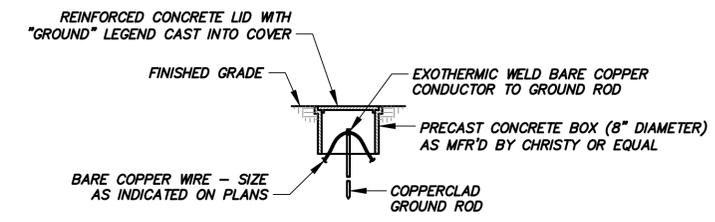

GRW TYP TYPICAL GROUND ROD AND WELL DETAIL
NTS

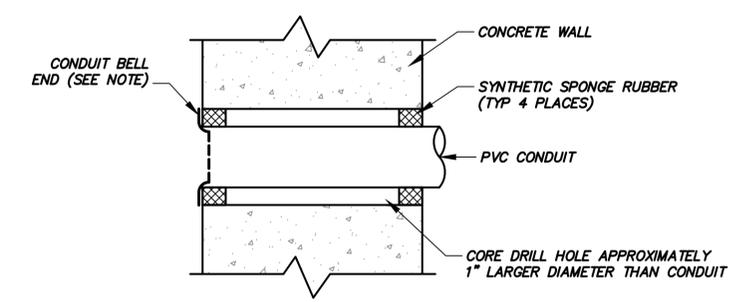

CWP TYP TYPICAL CONCRETE WALL PENETRATION DETAIL
NTS

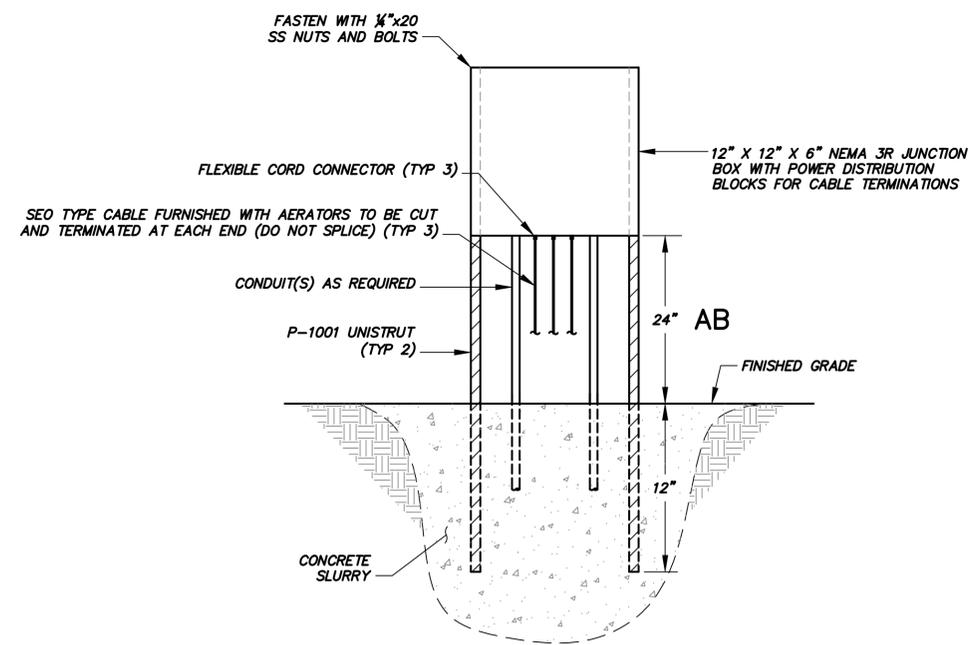

JB1 TYP ABOVE GROUND JUNCTION BOX WITH FOUNDATION MOUNTING DETAIL
NTS

RECORD DRAWING

THIS RECORD DOCUMENT HAS BEEN PREPARED BASED UPON INFORMATION PROVIDED BY THE CONTRACTOR (AS DENOTED BY "AB"). THIS INFORMATION MAY OR MAY NOT BE ACCURATE OR COMPLETE. FURTHERMORE, THE CONSULTANT HAS NOT VERIFIED ALL INFORMATION INDICATED ON THIS DOCUMENT. THE CONSULTANT SHALL NOT BE HELD RESPONSIBLE FOR ANY ERRORS OR OMISSIONS ON THIS DOCUMENT. THIS DOCUMENT IS FOR GENERAL INFORMATION PURPOSES ONLY. ANY OTHER USE OF THIS DOCUMENT IS AT YOUR SOLE RISK!

DARCOR
ELECTRICAL CONSULTING ENGINEERS

7600 N. 16TH ST.
SUITE 212
PHOENIX, AZ 85020
PH: (602) 796-8899
WWW.DARCORINC.COM

Saved: March 14, 2017 File: 16019-RD-GANADO-E507.dwg Drafter: Brandon Rickard